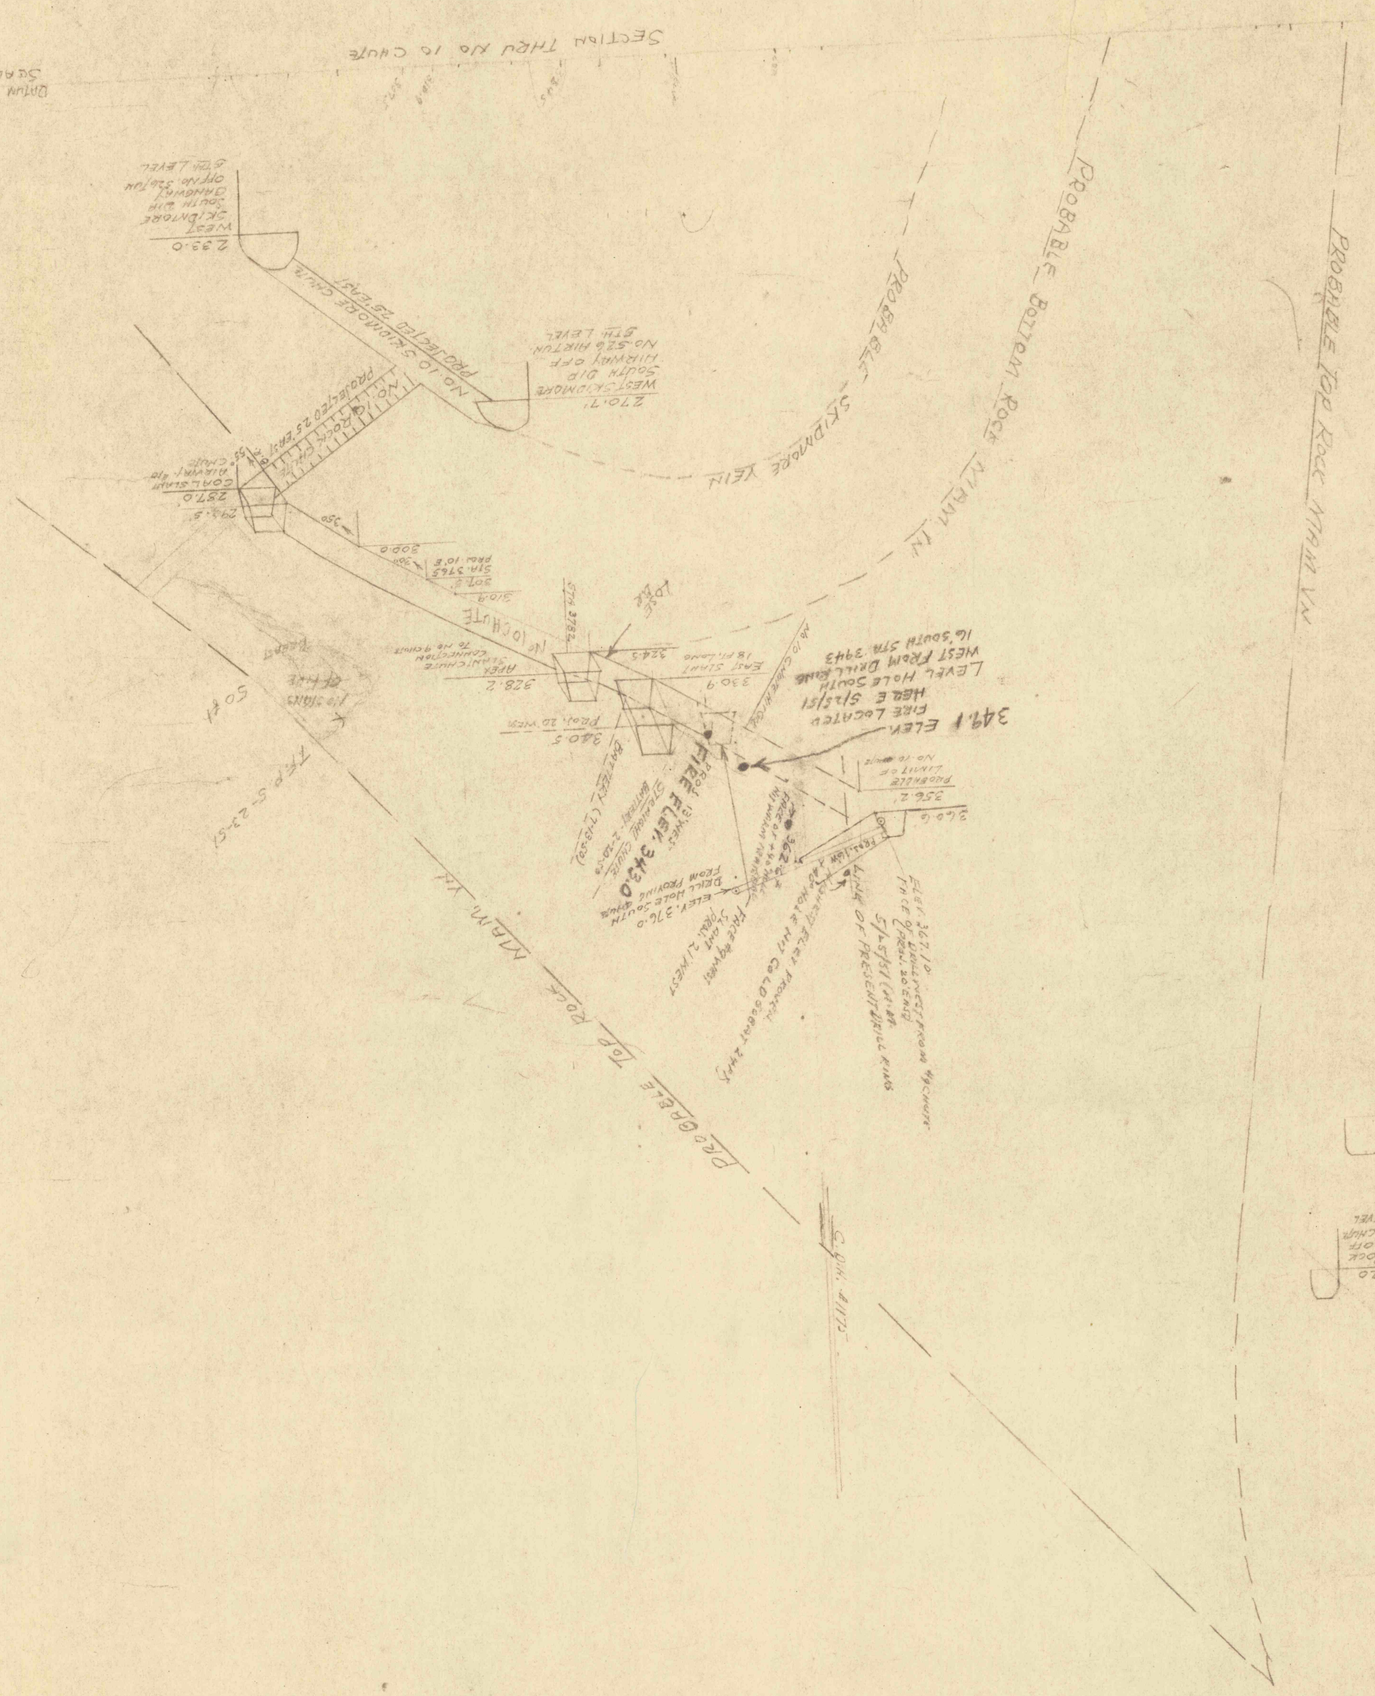
SKIDMORE VEIN
PROBABLE TOP
MAIN VEIN
TREP. 5-25-51
SOUTH
No. 10 CHUTE
No. 10 SKIDMORE CHUTE
PROJECTED 25 EAST
WEST SKIDMORE SOUTH DIP OFFAN. 25th GTH LEVEL
Z 33.0
WEST-SKIDMORE HIGHWAY OFF No. 5 & 6 HIGHWAY GTH LEVEL
Z70.7'
PROJECTED 25 EAST
287.0'
COAL SEAM MAINT. & CHUTE
293.5
300.0
30°
30ft. 3765 STH. 10'E
310.9
STH 378.8
LOCK
No. 10 CHUTE
328.2
HEAV. SHAKE CONNECTION TO No. 9 CHUTE
324.5
EAST STATE 18 Ft. LONG
330.9
No. 10 CHUTE
340.5
FRAG. 20' WIDE
FIRE LOCATED
FIRE ELEV. 342.0
BATTERY STATION
STATIONAL CHUTE
BATTERY (CHUTE)
ELEV. 376.0
DRILL HOLE SOUTH FROM PROVING SPACE
FACE REMAINS
FACE 2 WEST
FACE REMAINS
FRAGILIAN
No. 10 CHUTE
PROBABLE LIMIT OF
256.2'
340.6
349.1 ELEV.
FIRE LOCATED
HOLE SIZE/SI
LEVEL HOLE SOUTH
WEST FROM DRILL HOLE
16' SOUTH STA. 394.3
No. 10 CHUTE
SCALE: 1" = 20'
DATUM 2000'
SCALE 1:20
430.0
WEST MAIN. ROCK CROSS OFF No. 4 & 6 TUNNEL.
4th LEVEL
461.20
EAST ROCK SLANT OFF No. 10 CHUTE
4th LEVEL