


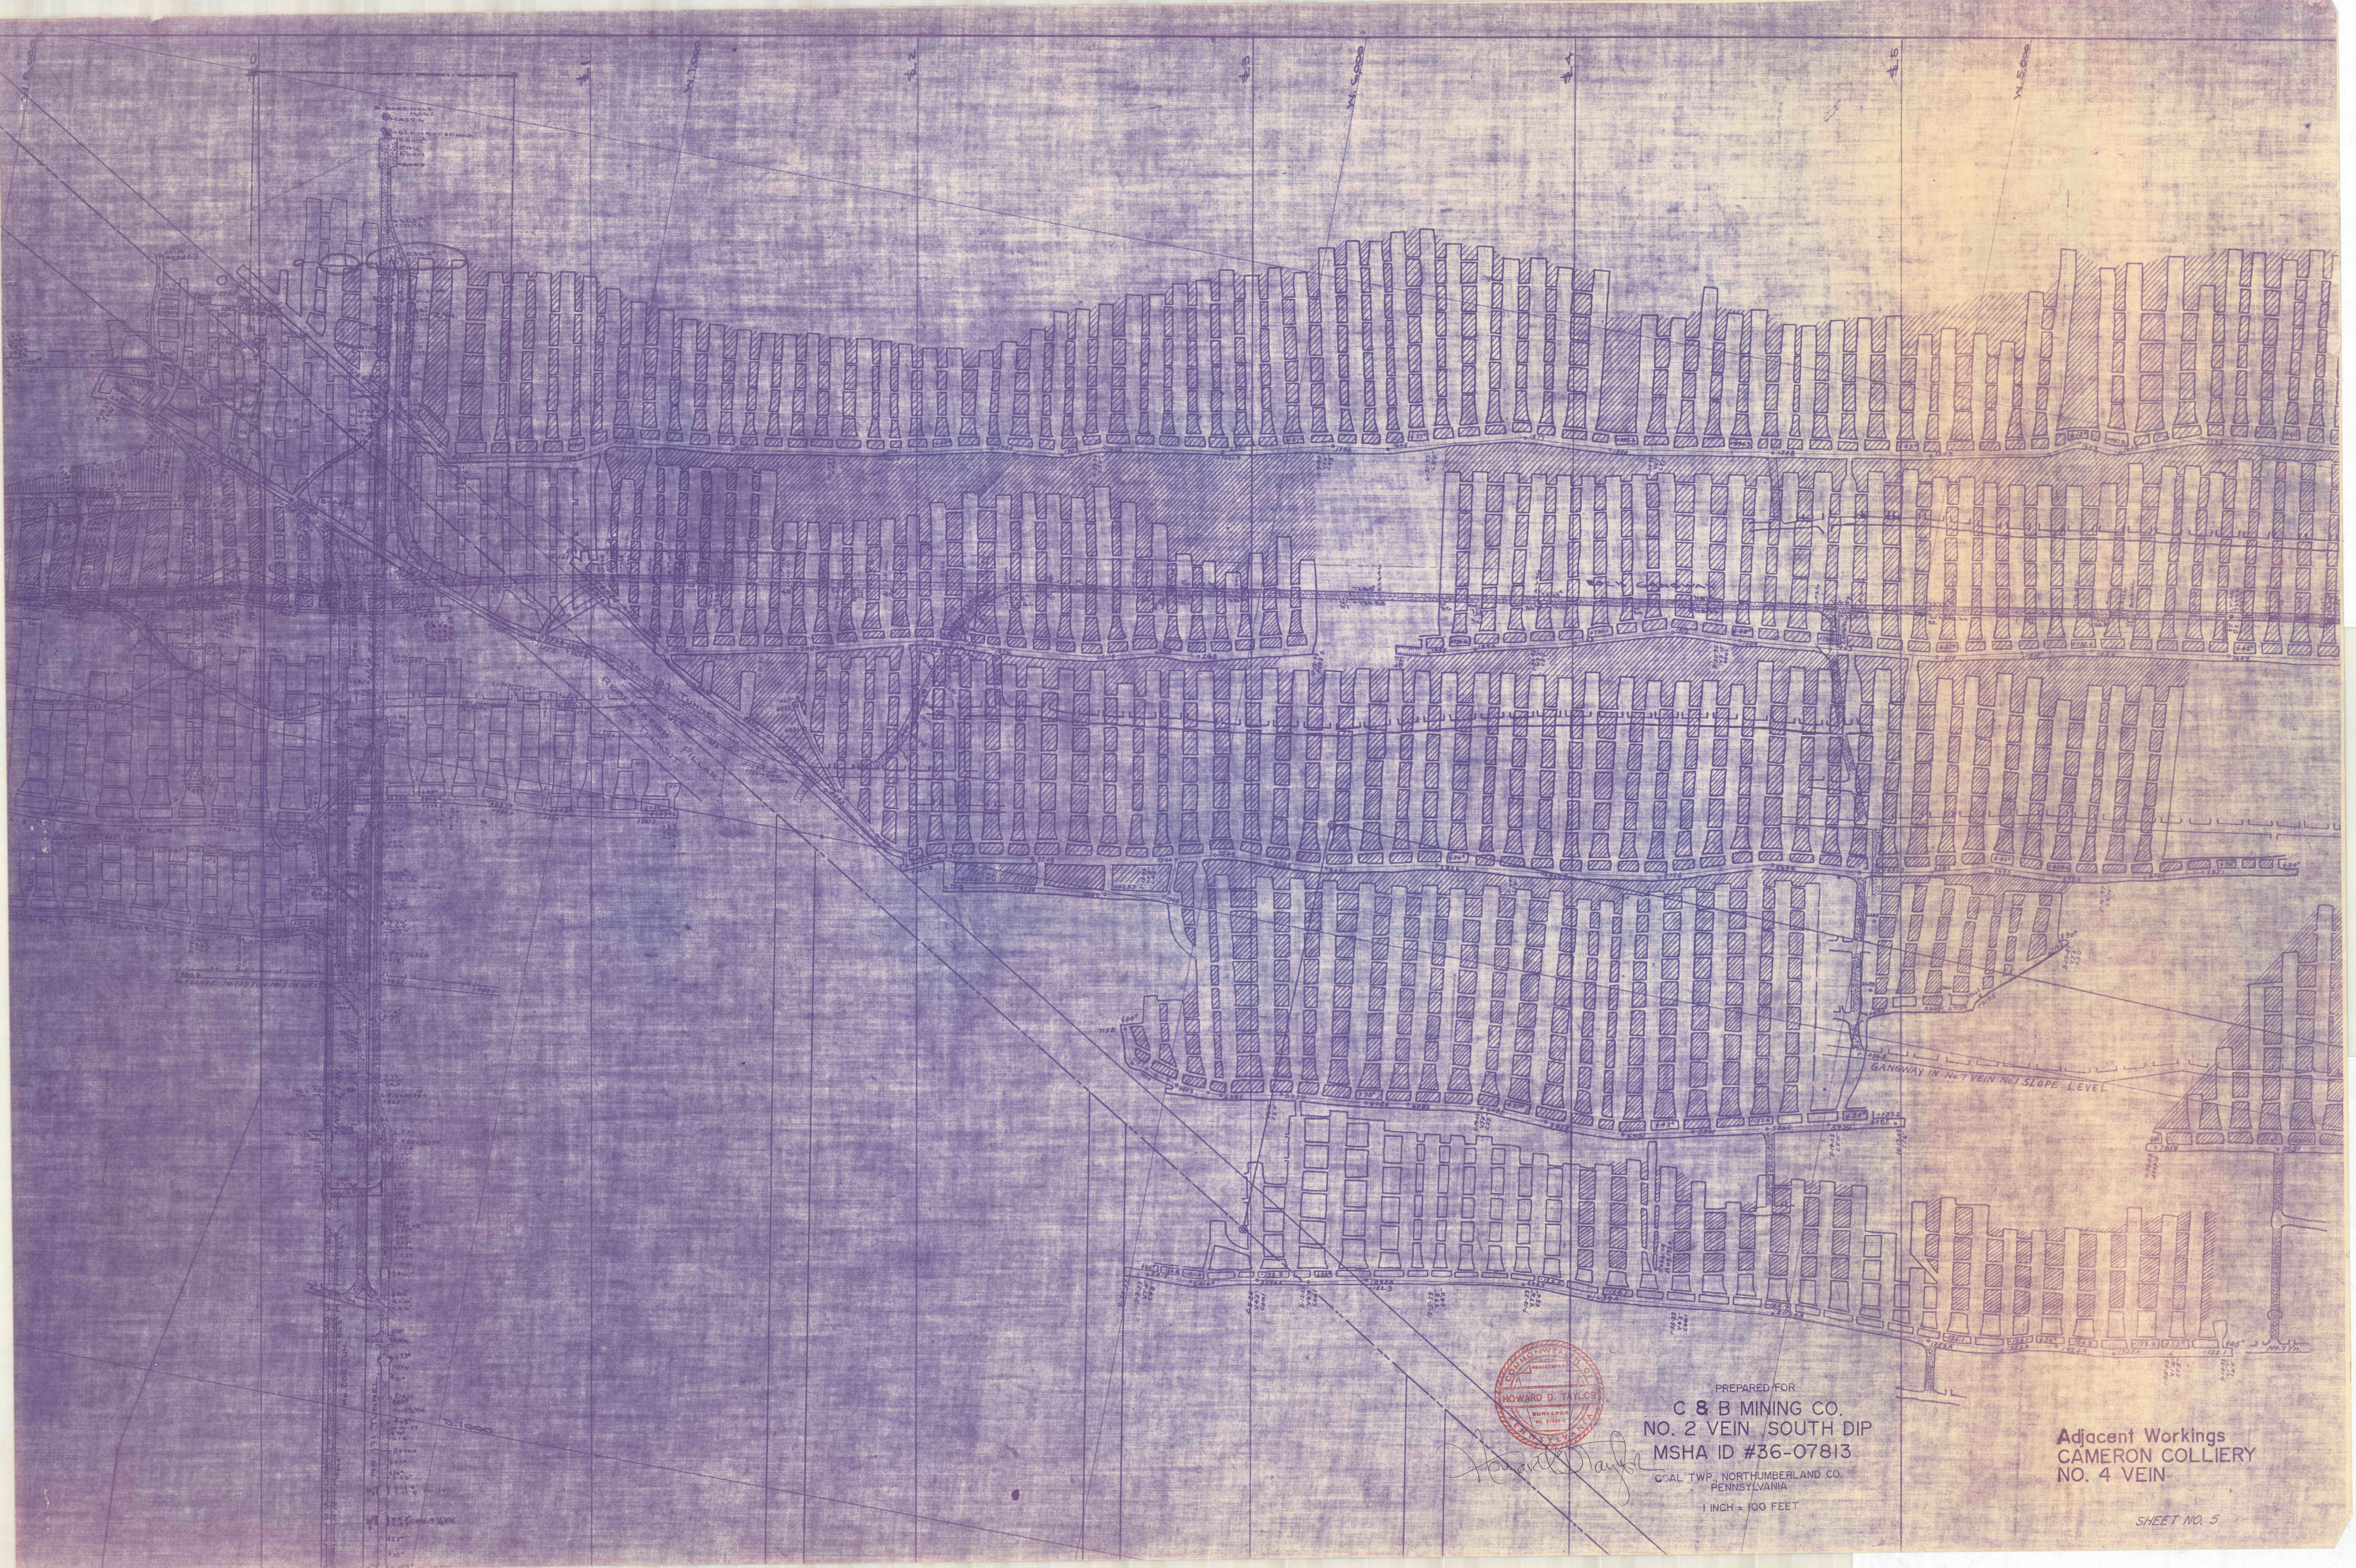

PREPARED FOR
C & B MINING CO.
NO. 2 VEIN, SOUTH DIP
MSHA ID #36-07813
COAL TWP., NORTHUMBERLAND CO.
PENNSYLVANIA
1 INCH = 100 FEET

Adjacent Workings
CAMERON COLLIERY
NO. 4 VEIN