
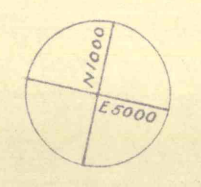
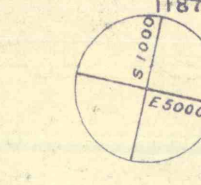
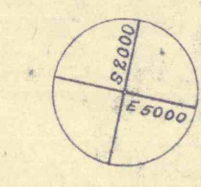
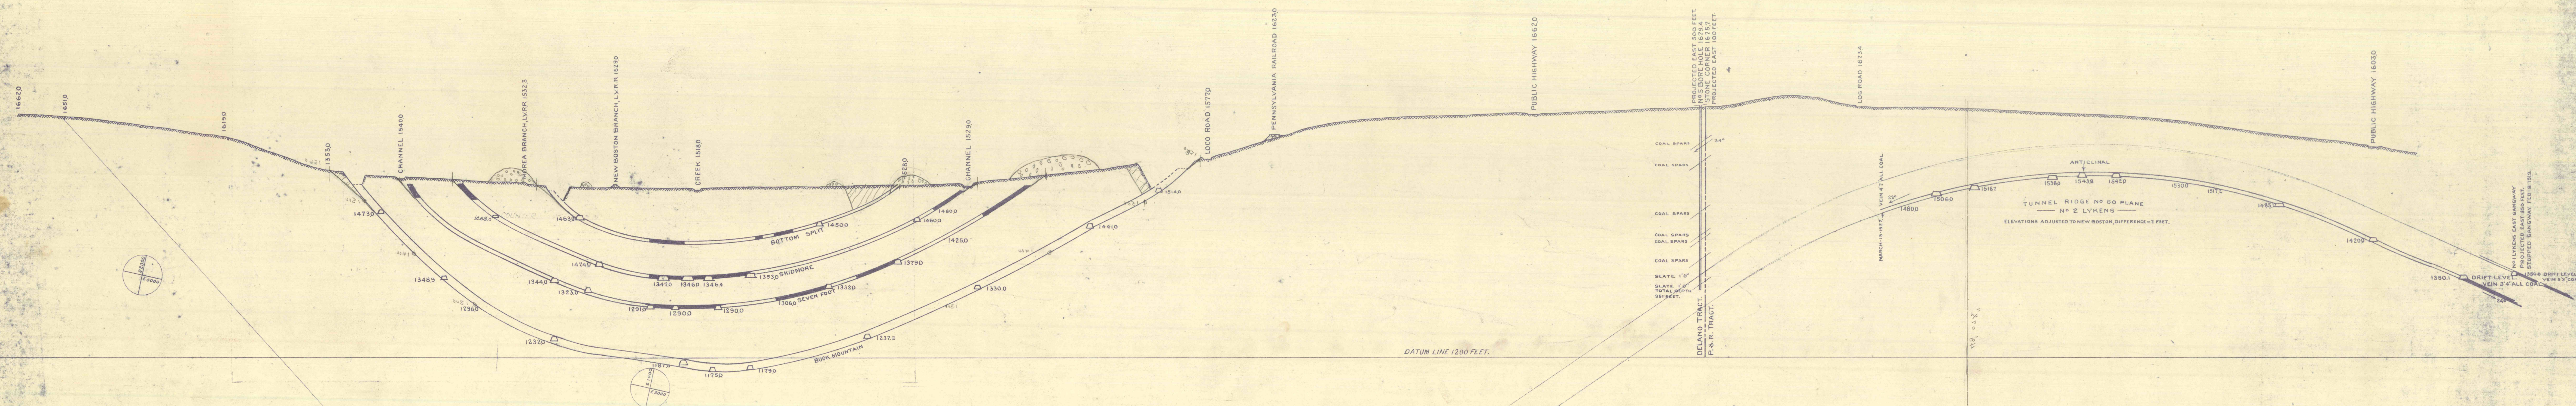


Robbing 18417 N.E. 52

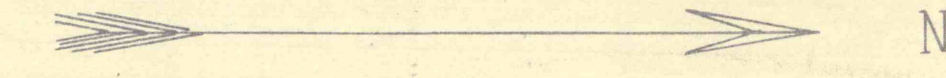

No 118
— NEW BOSTON COLLIERY —
Section 2350 feet East of No 1 Slope, and on Line of
TUNNEL RIDGE NO 50 PLANE SLOPE, NO 2 LYKENS BED
Scale 100 feet per inch. February-24-1928.