


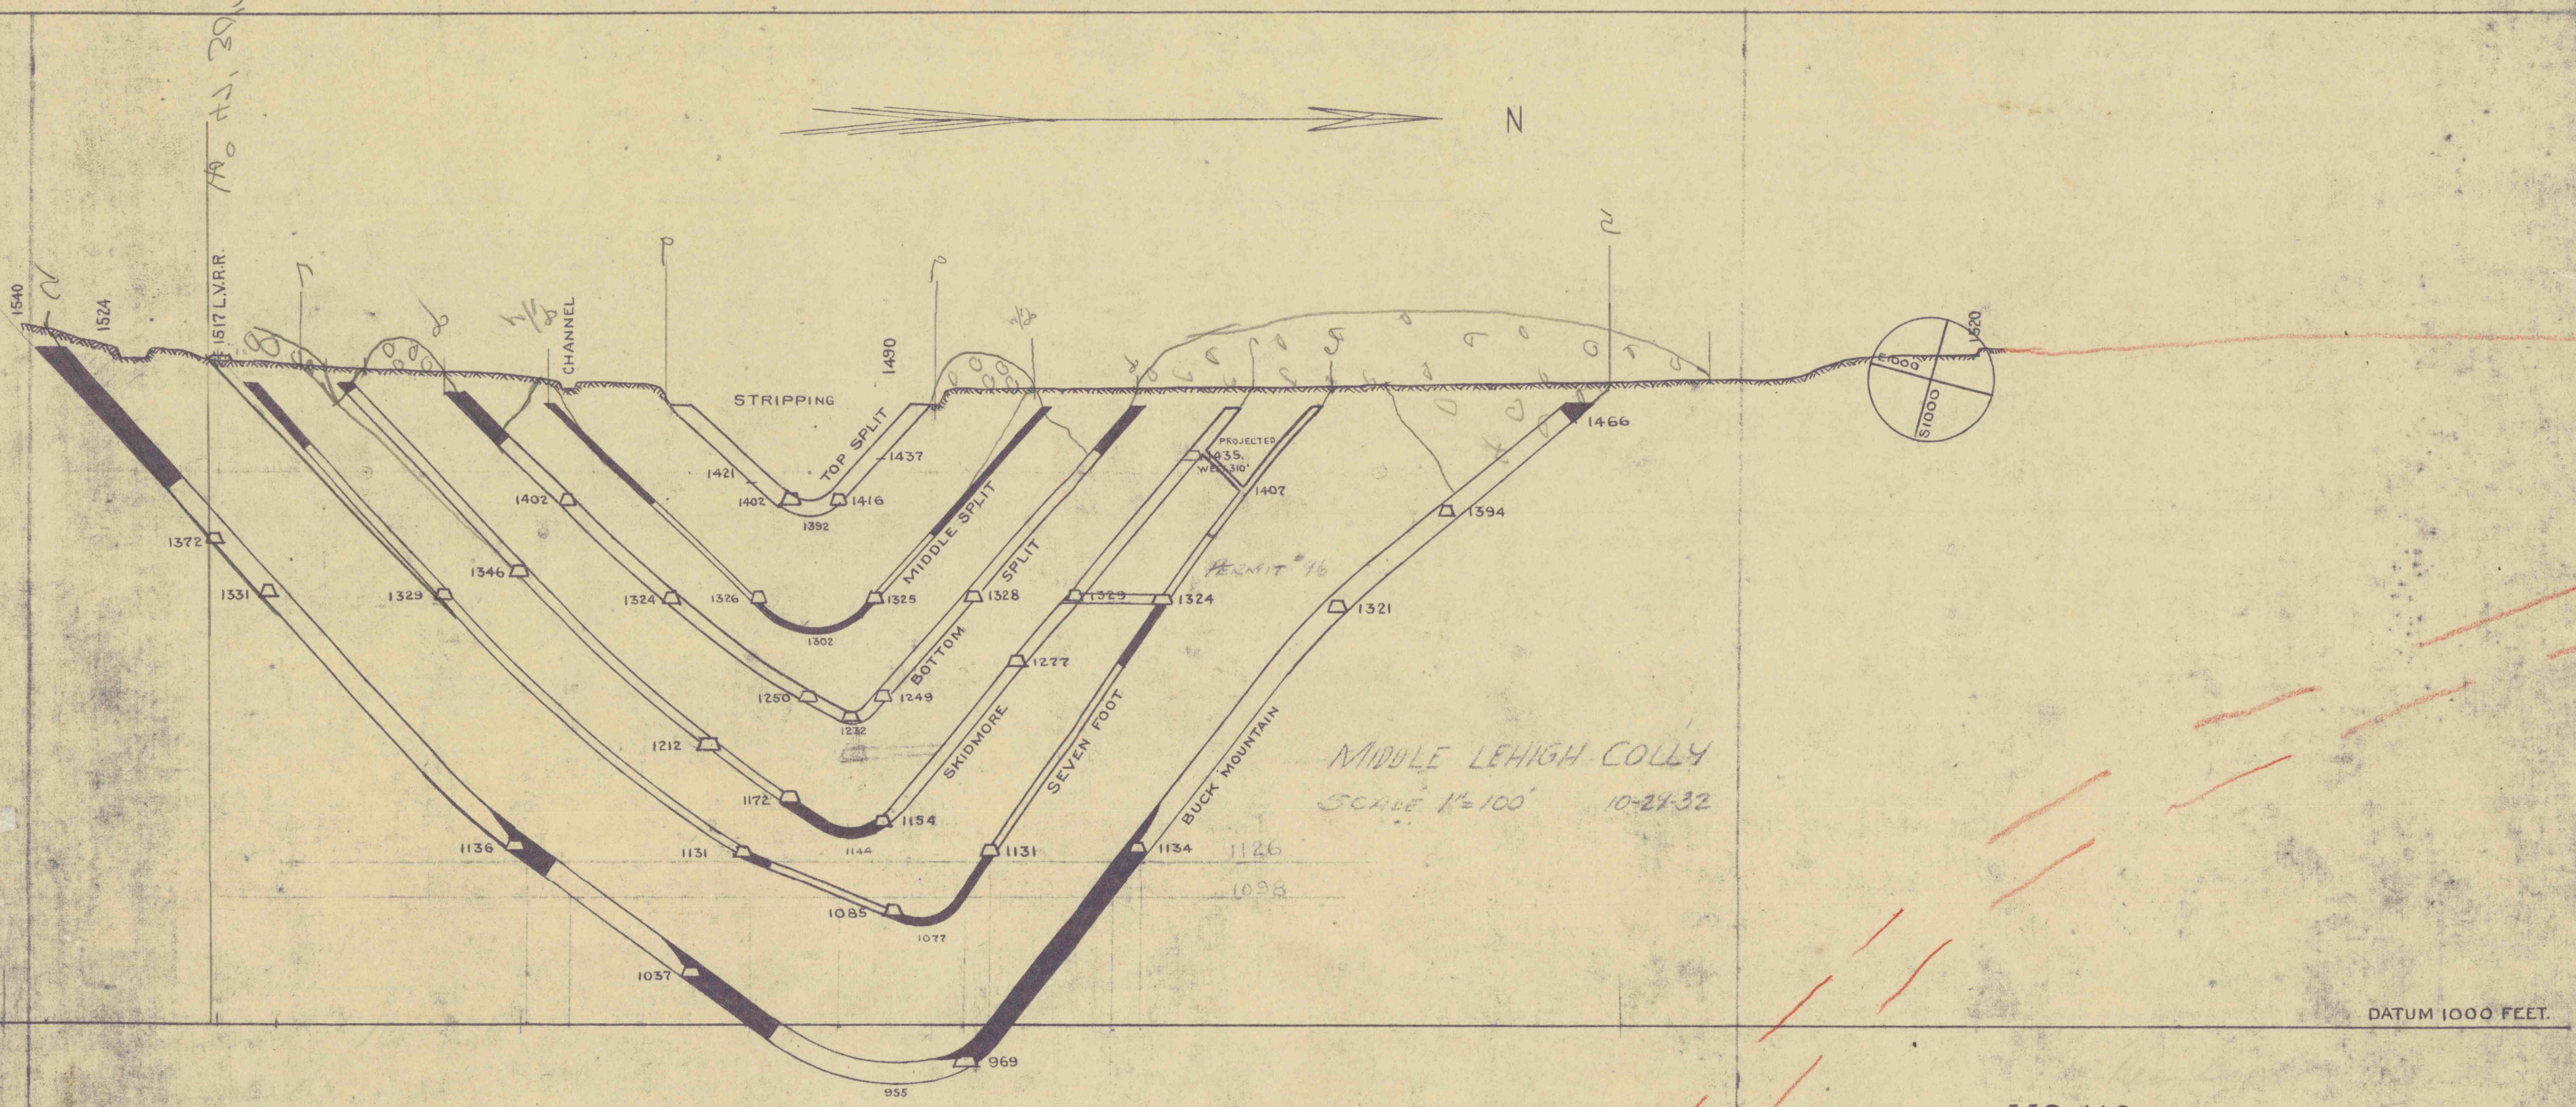

No 110

MIDDLE LEHIGH COLLIERY
SECTION 1080 FEET EAST OF WEST LINE.
SCALE 1-INCH PER 100 FEET, FEB-25-1929.