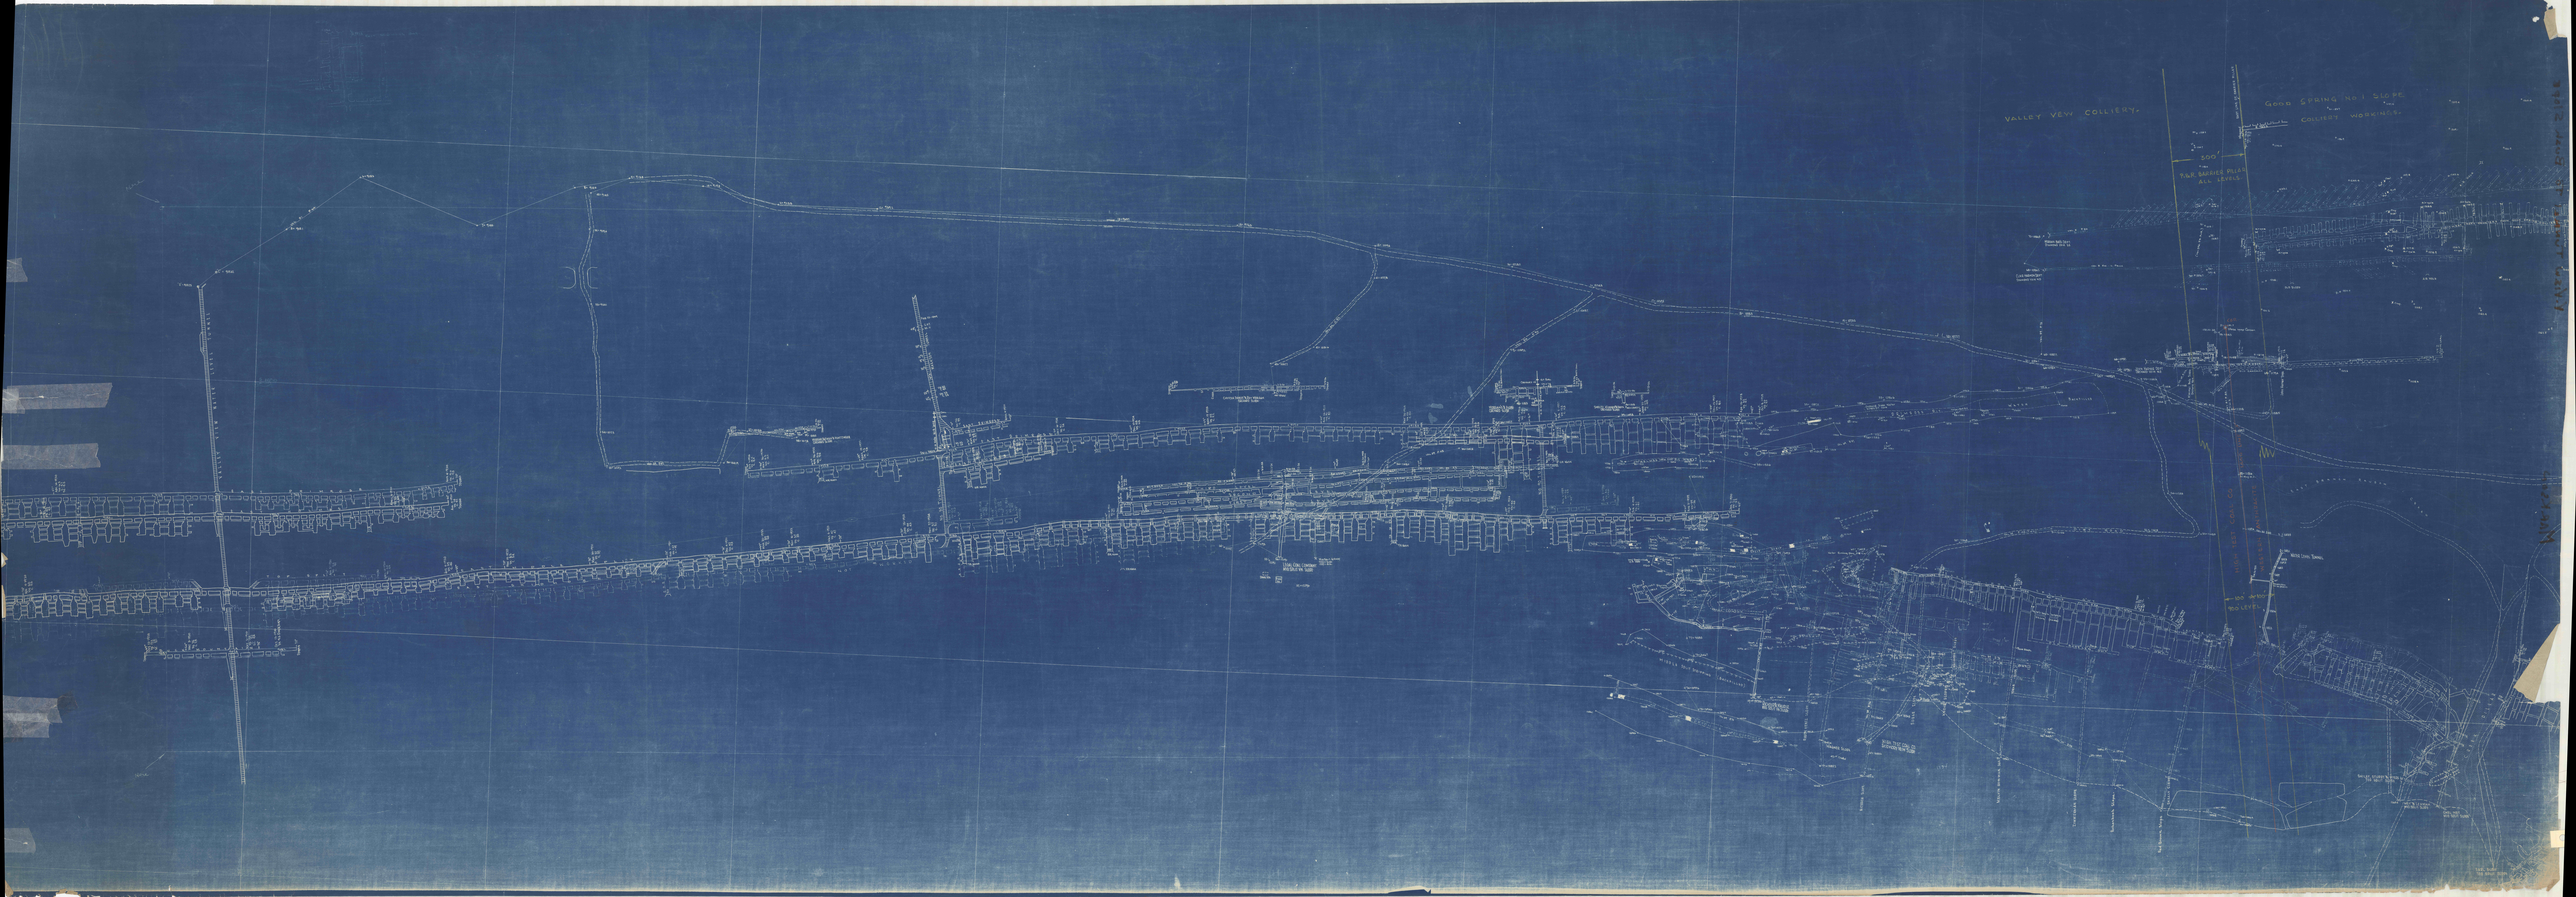

VALLEY VEW COLLIERY.
GOOD SPRING NO 1 SLOPE
COLLIERY WORKINGS.
300'
P.&R. BARRIER PILLAR
ALL LEVELS.
EAST LINE OF BARRIER PILLAR
MORGAN BROS. DRIFT
DIAMOND VEIN S.D.
CLAIR HARMON DRIFT
DIAMOND VEIN N.D.
OLD GANGWAY
OLD SLOPE
AIR HOLE
Air Hole
WEST TRACY COUNTERS FROM GOOD SPRING COLLIERY
Stone Heap Corner
COR.
CREEK