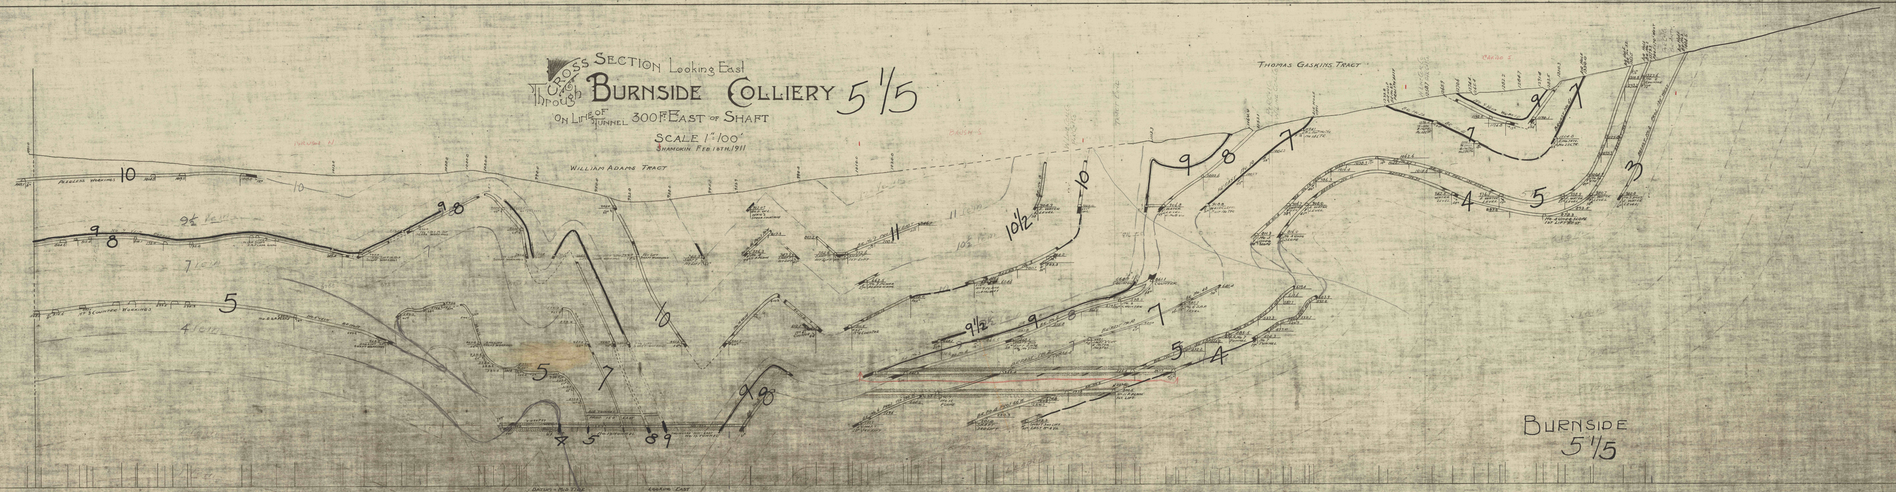
Cross Section Looking East
Burnside Colliery 5 1/5
On Line of Tunnel 300 Ft East of Shaft
Scale 1"=100'
Shamokin Feb 15th 1911
William Adams Tract
Thomas Gaskins Tract
Looking East
Burnside
5 1/5