


VALENTINE

BROBST

#3-N. 9. V. N

500 F

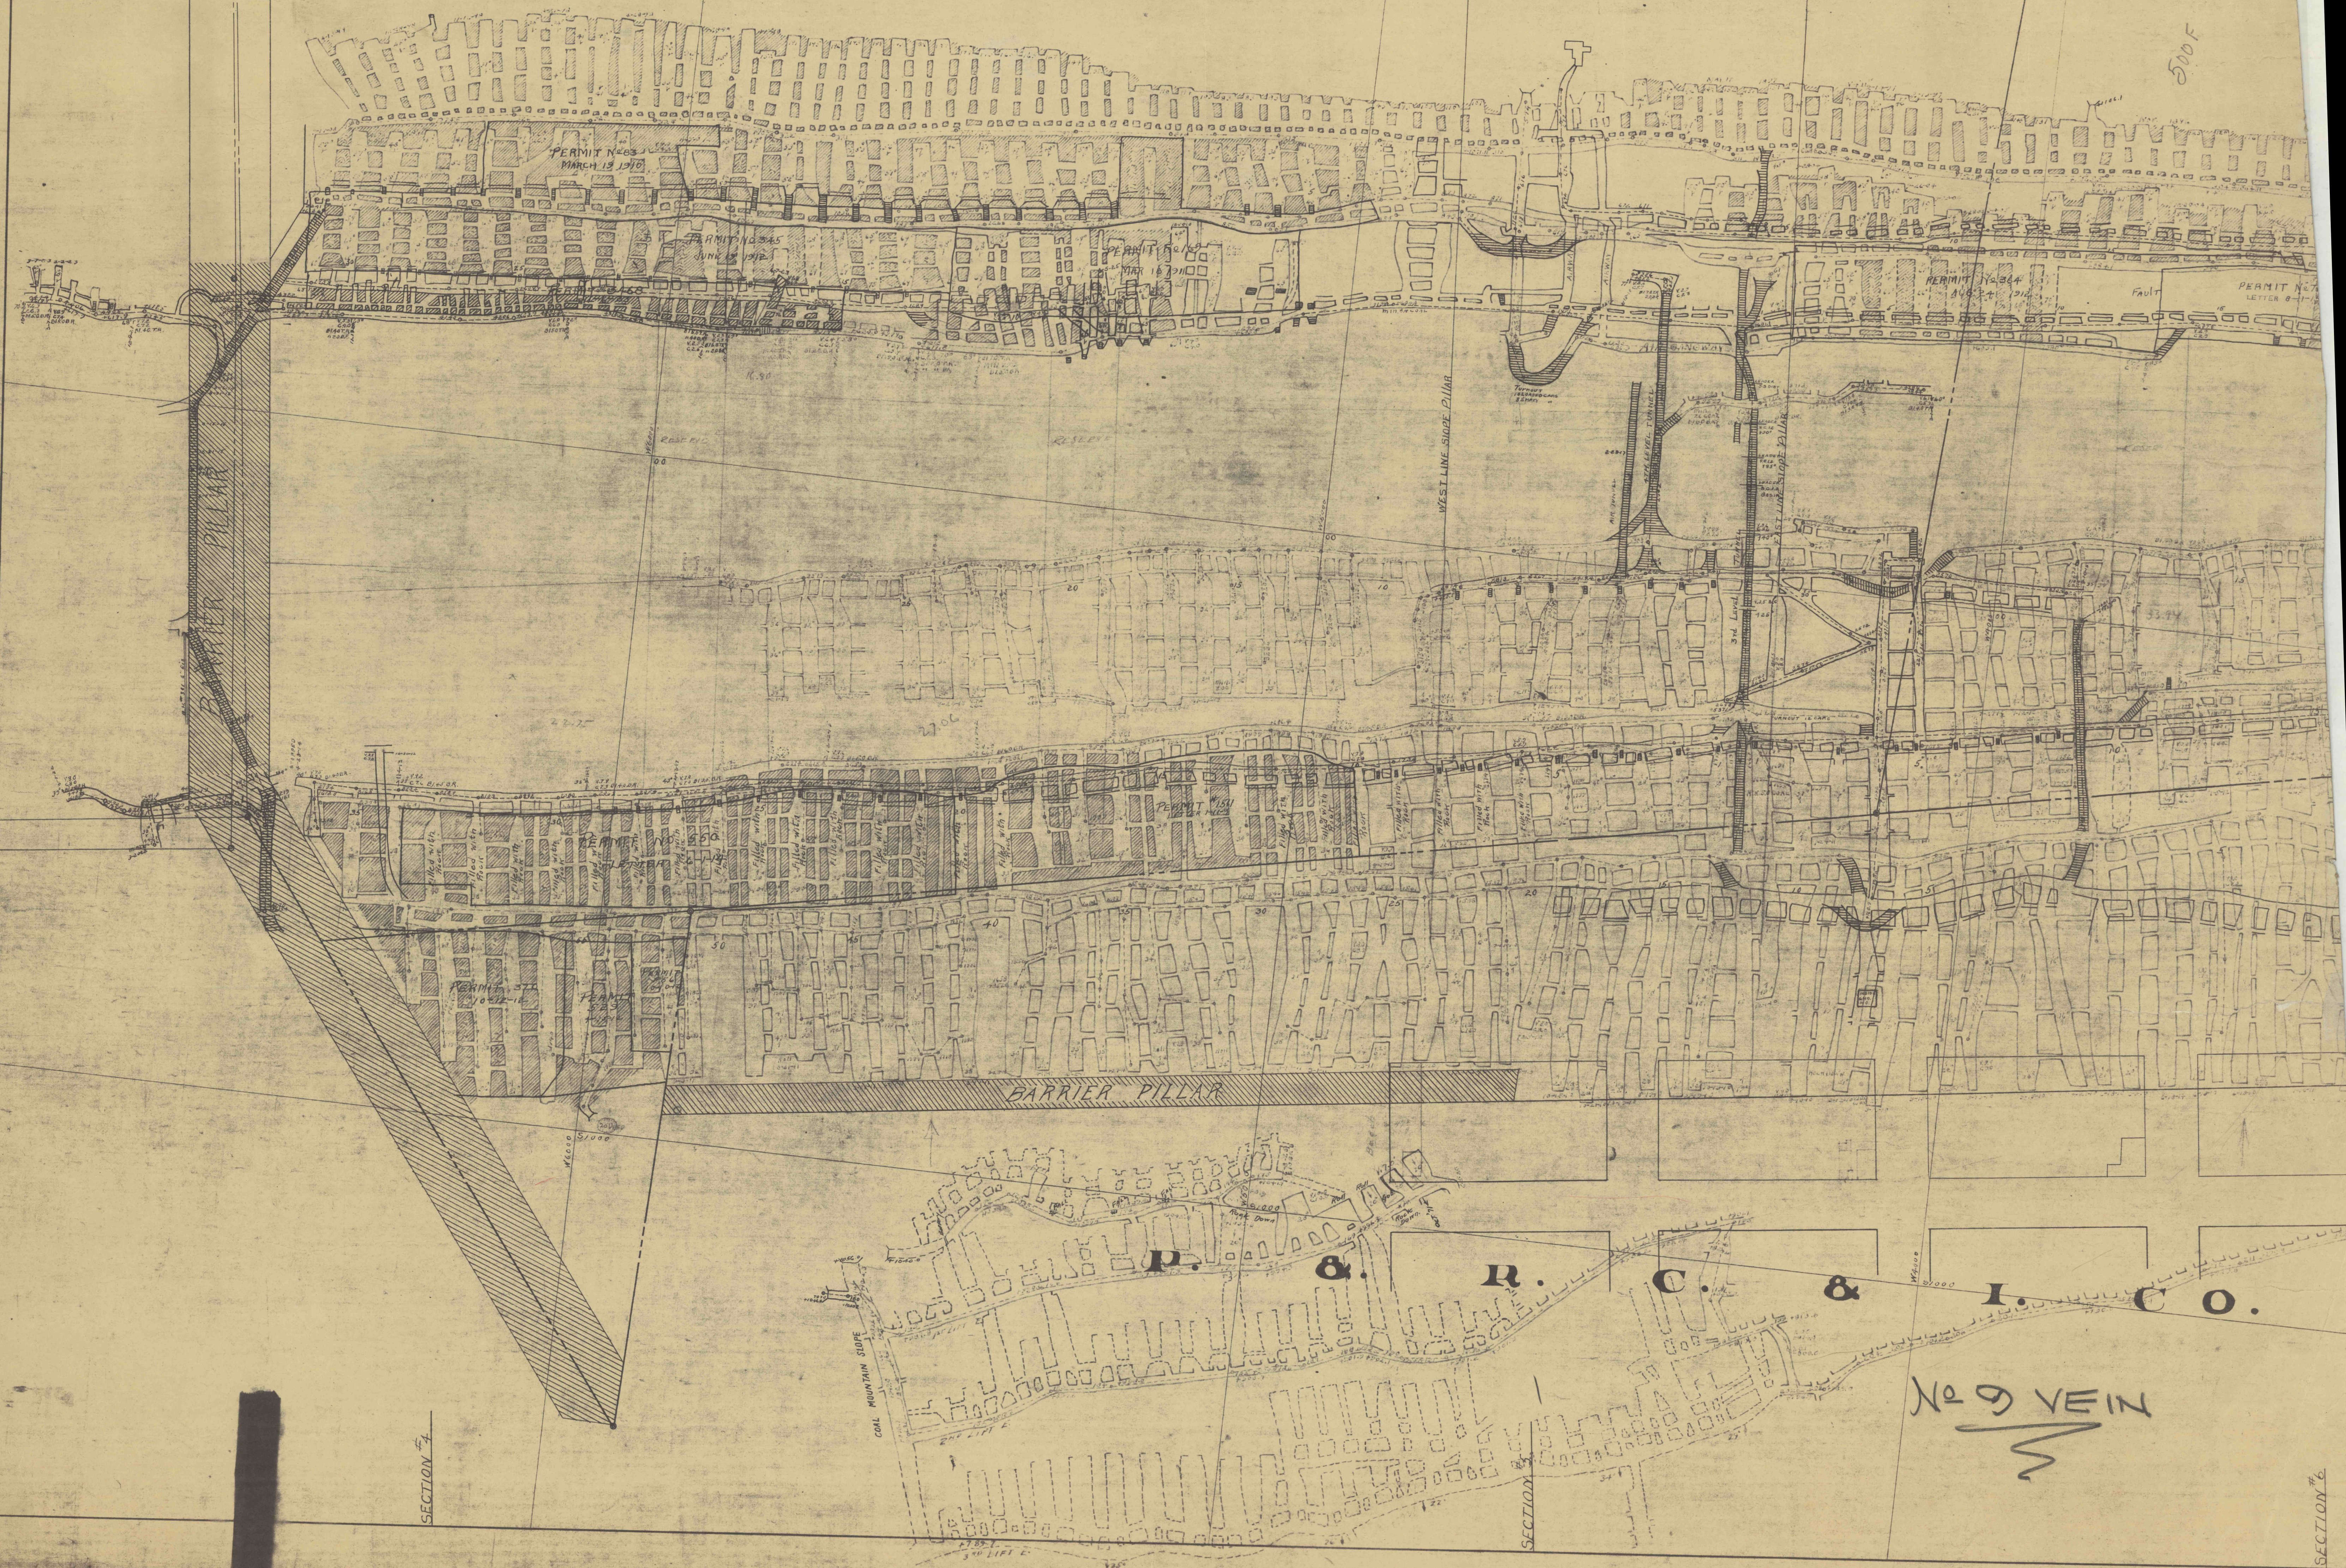

SECTION 4

SECTION 5

SECTION 6

BARRIER PILLAR

WEST LINE SLIDE PILLAR

COAL MOUNTAIN SLIDE

D. & R. C. & I. CO.

No 9 VEIN

PERMIT No. 83
MARCH 13 1910

PERMIT No. 84
JUNE 15 1910

PERMIT No. 85
MAR 16 1910

PERMIT No. 86
AUG 21 1910

PERMIT No. 87
LETTER 8-11-10