
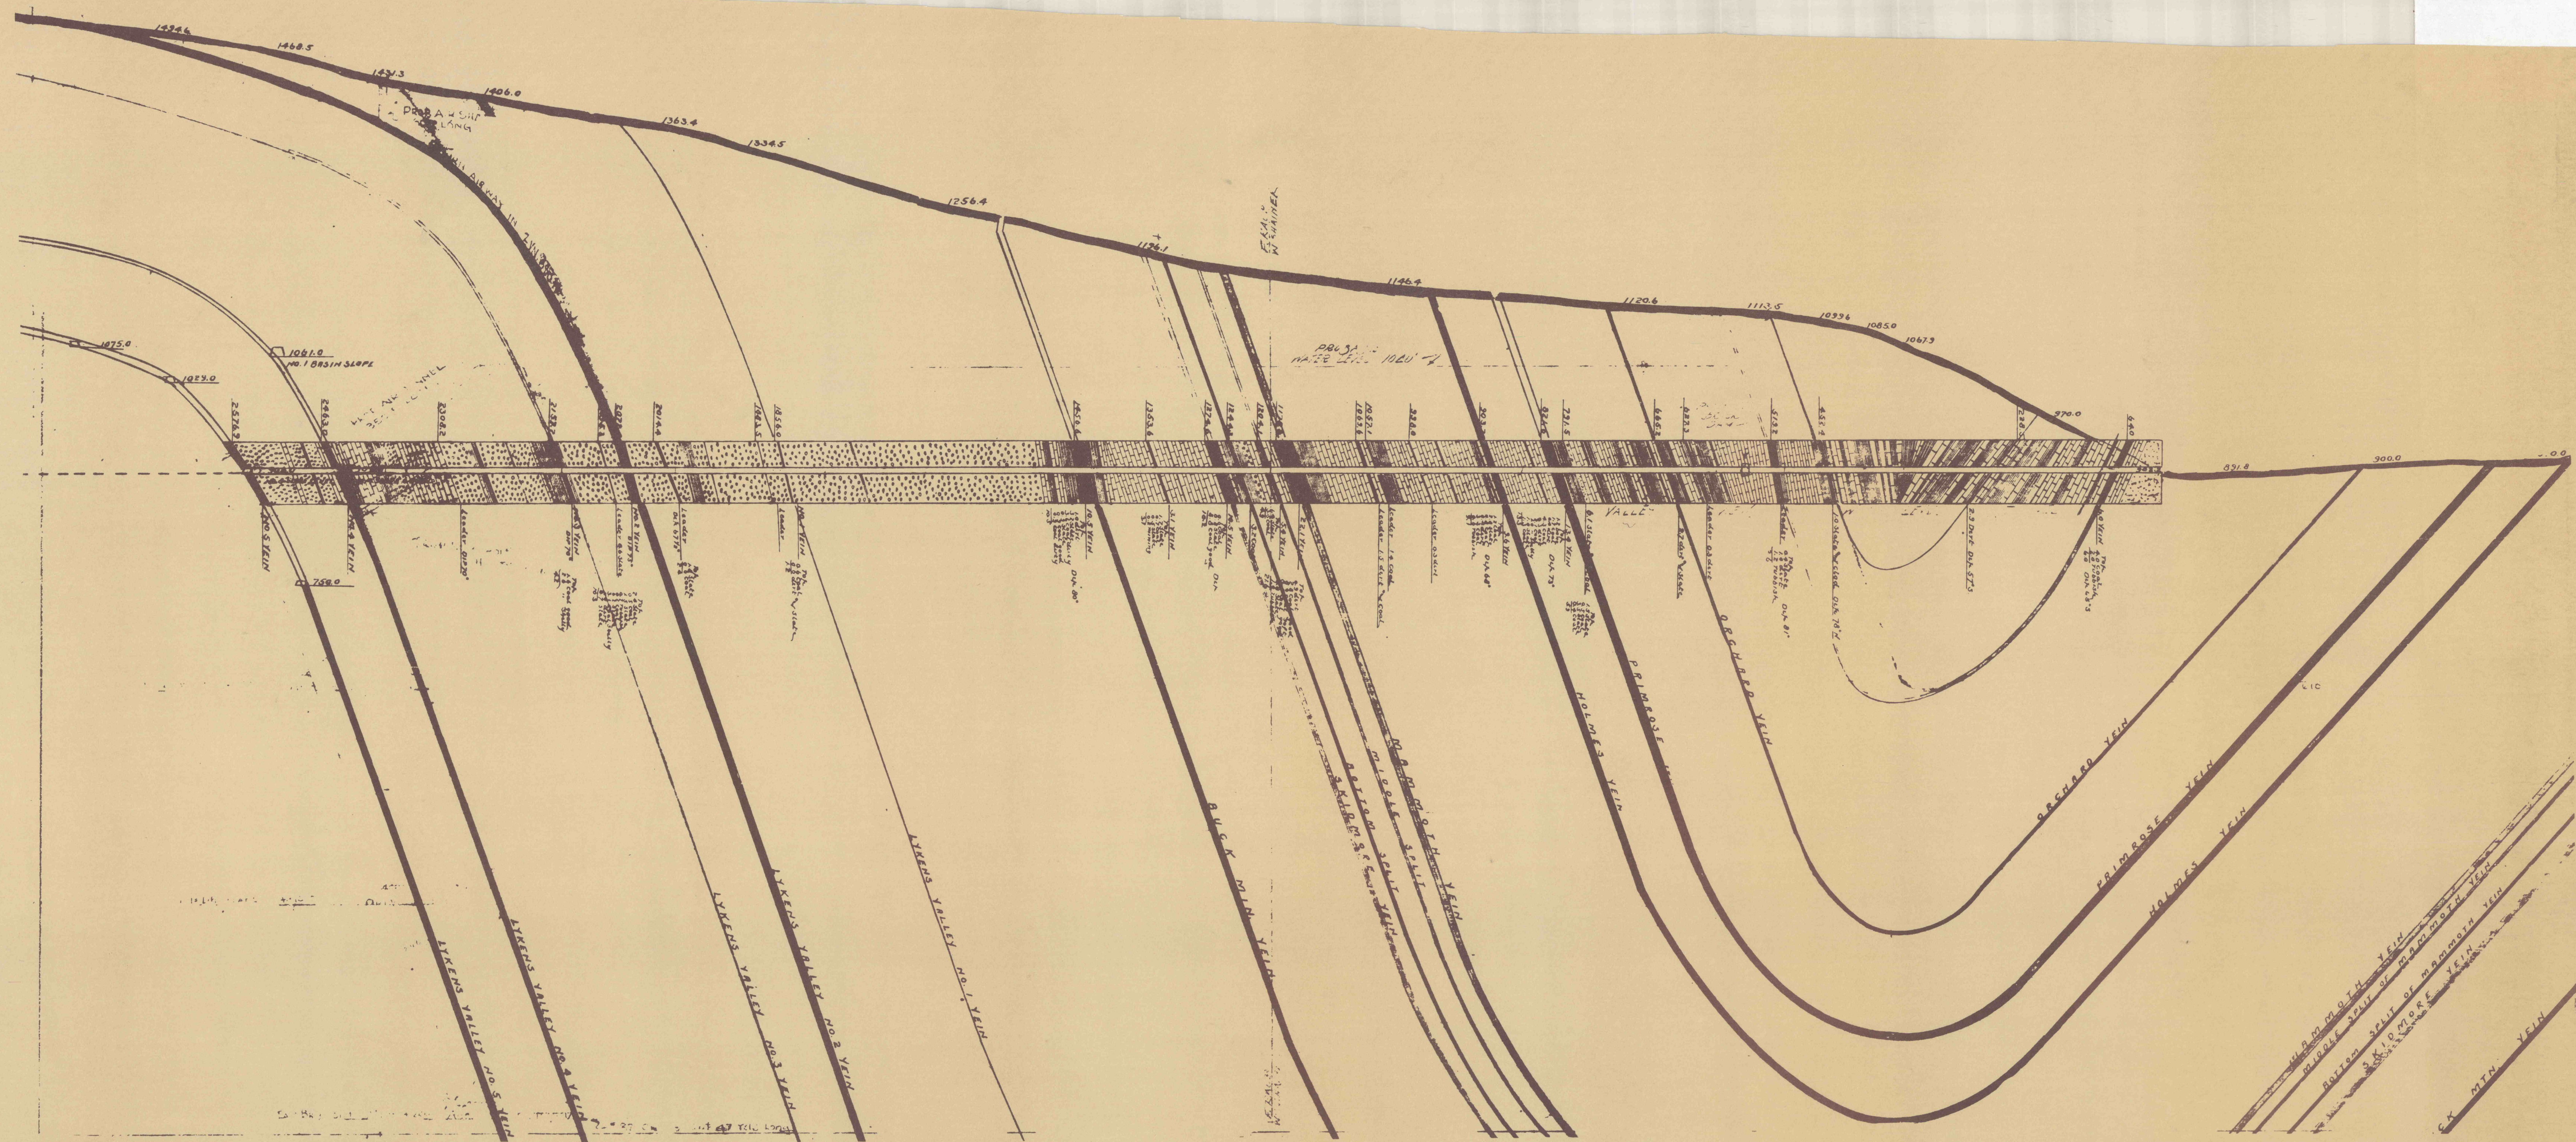


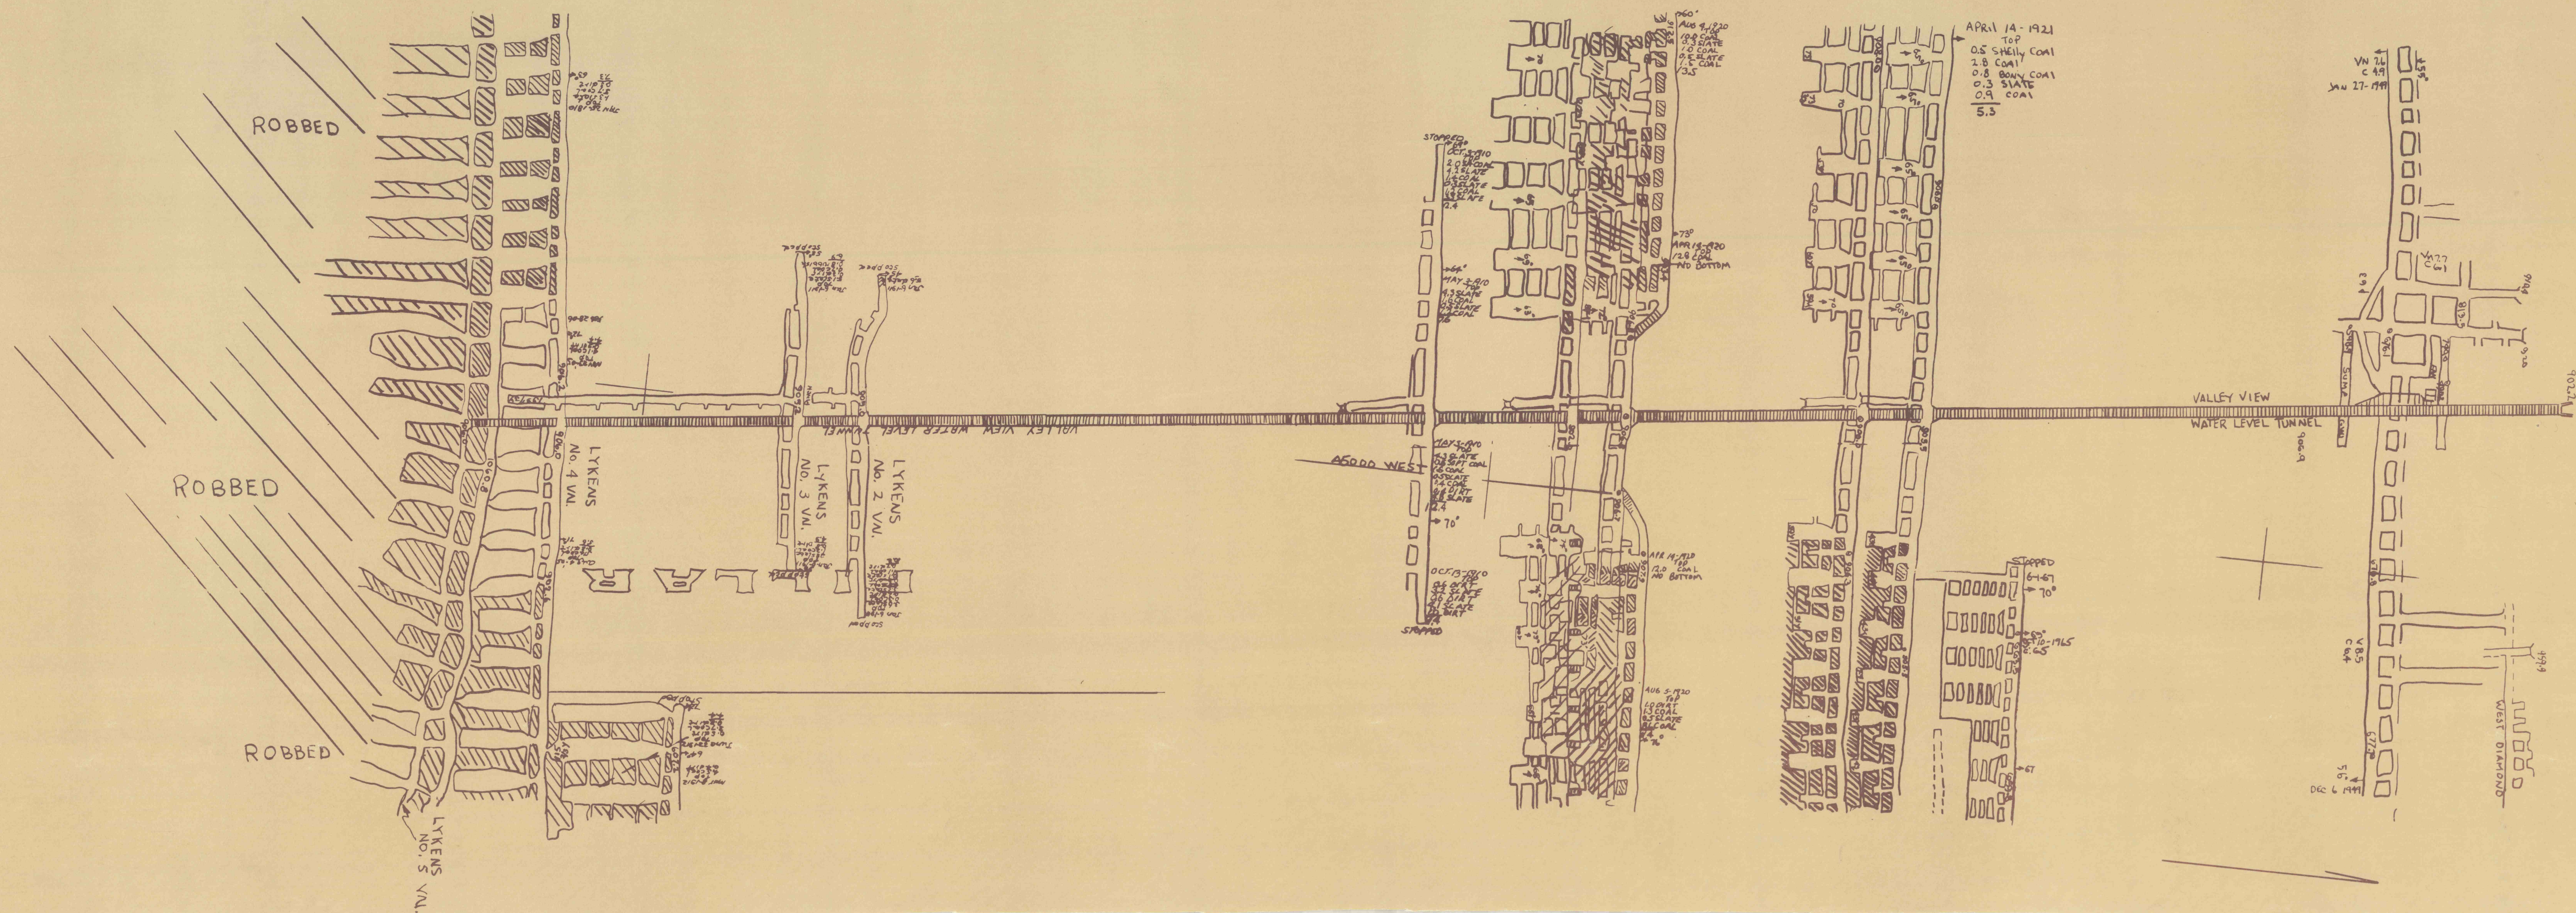

VALLEY VIEW TUNNEL
PLAN & SECTION 1"=100'
JULY 1989

UNTOUCHED ORIGINAL

VALLEY VIEW TUNNEL
PLAN & SECTION 1"=100'
JULY 1989