


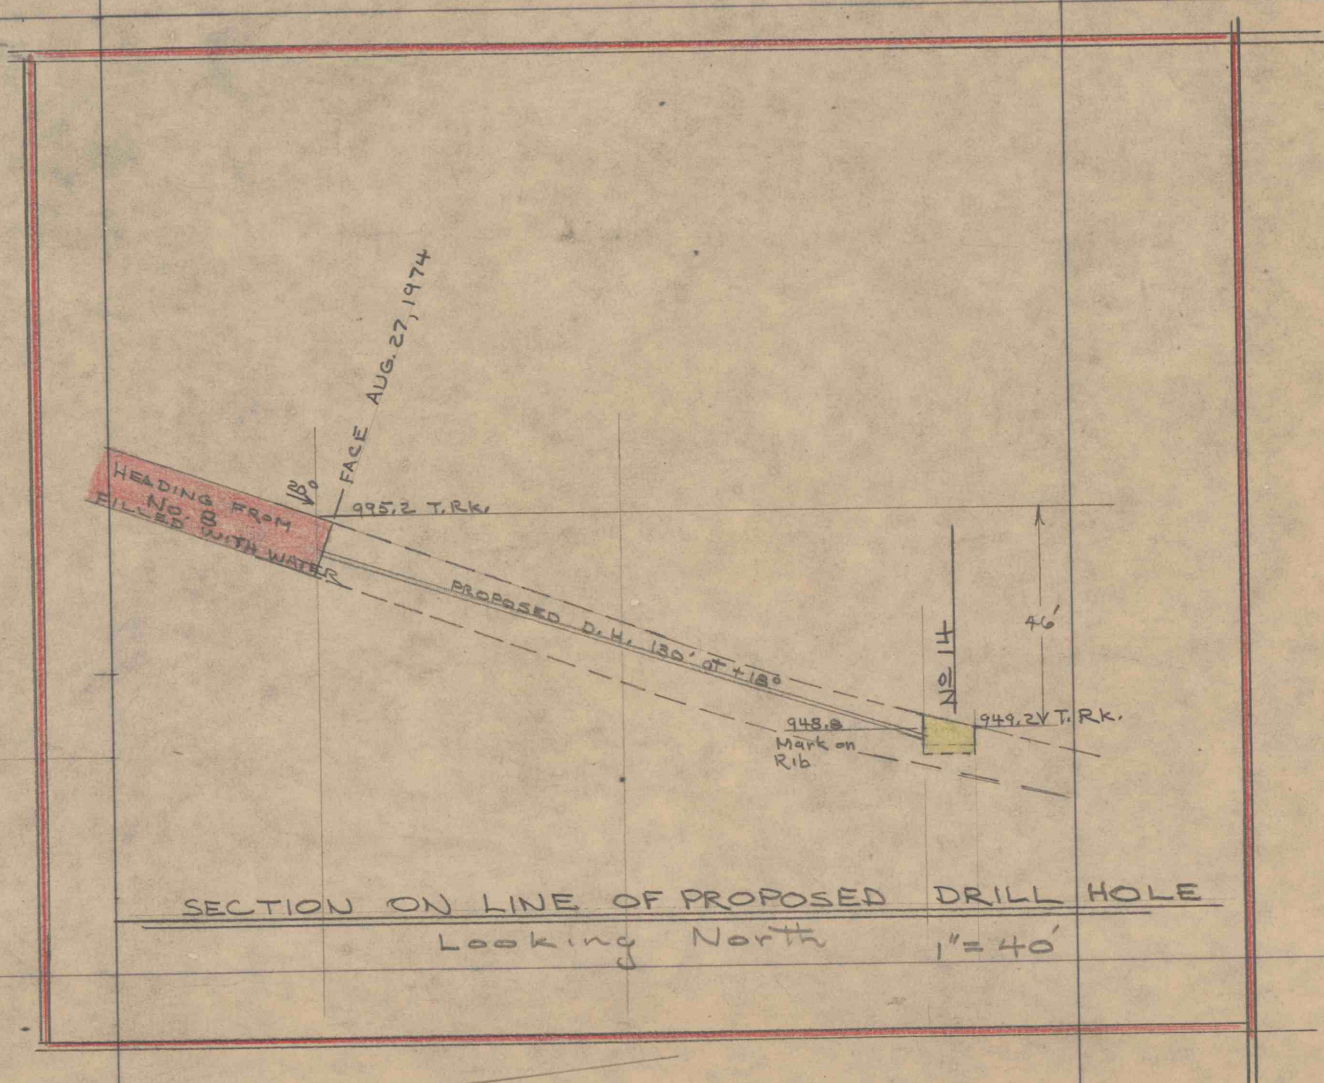

SCALE: 1" = 40'