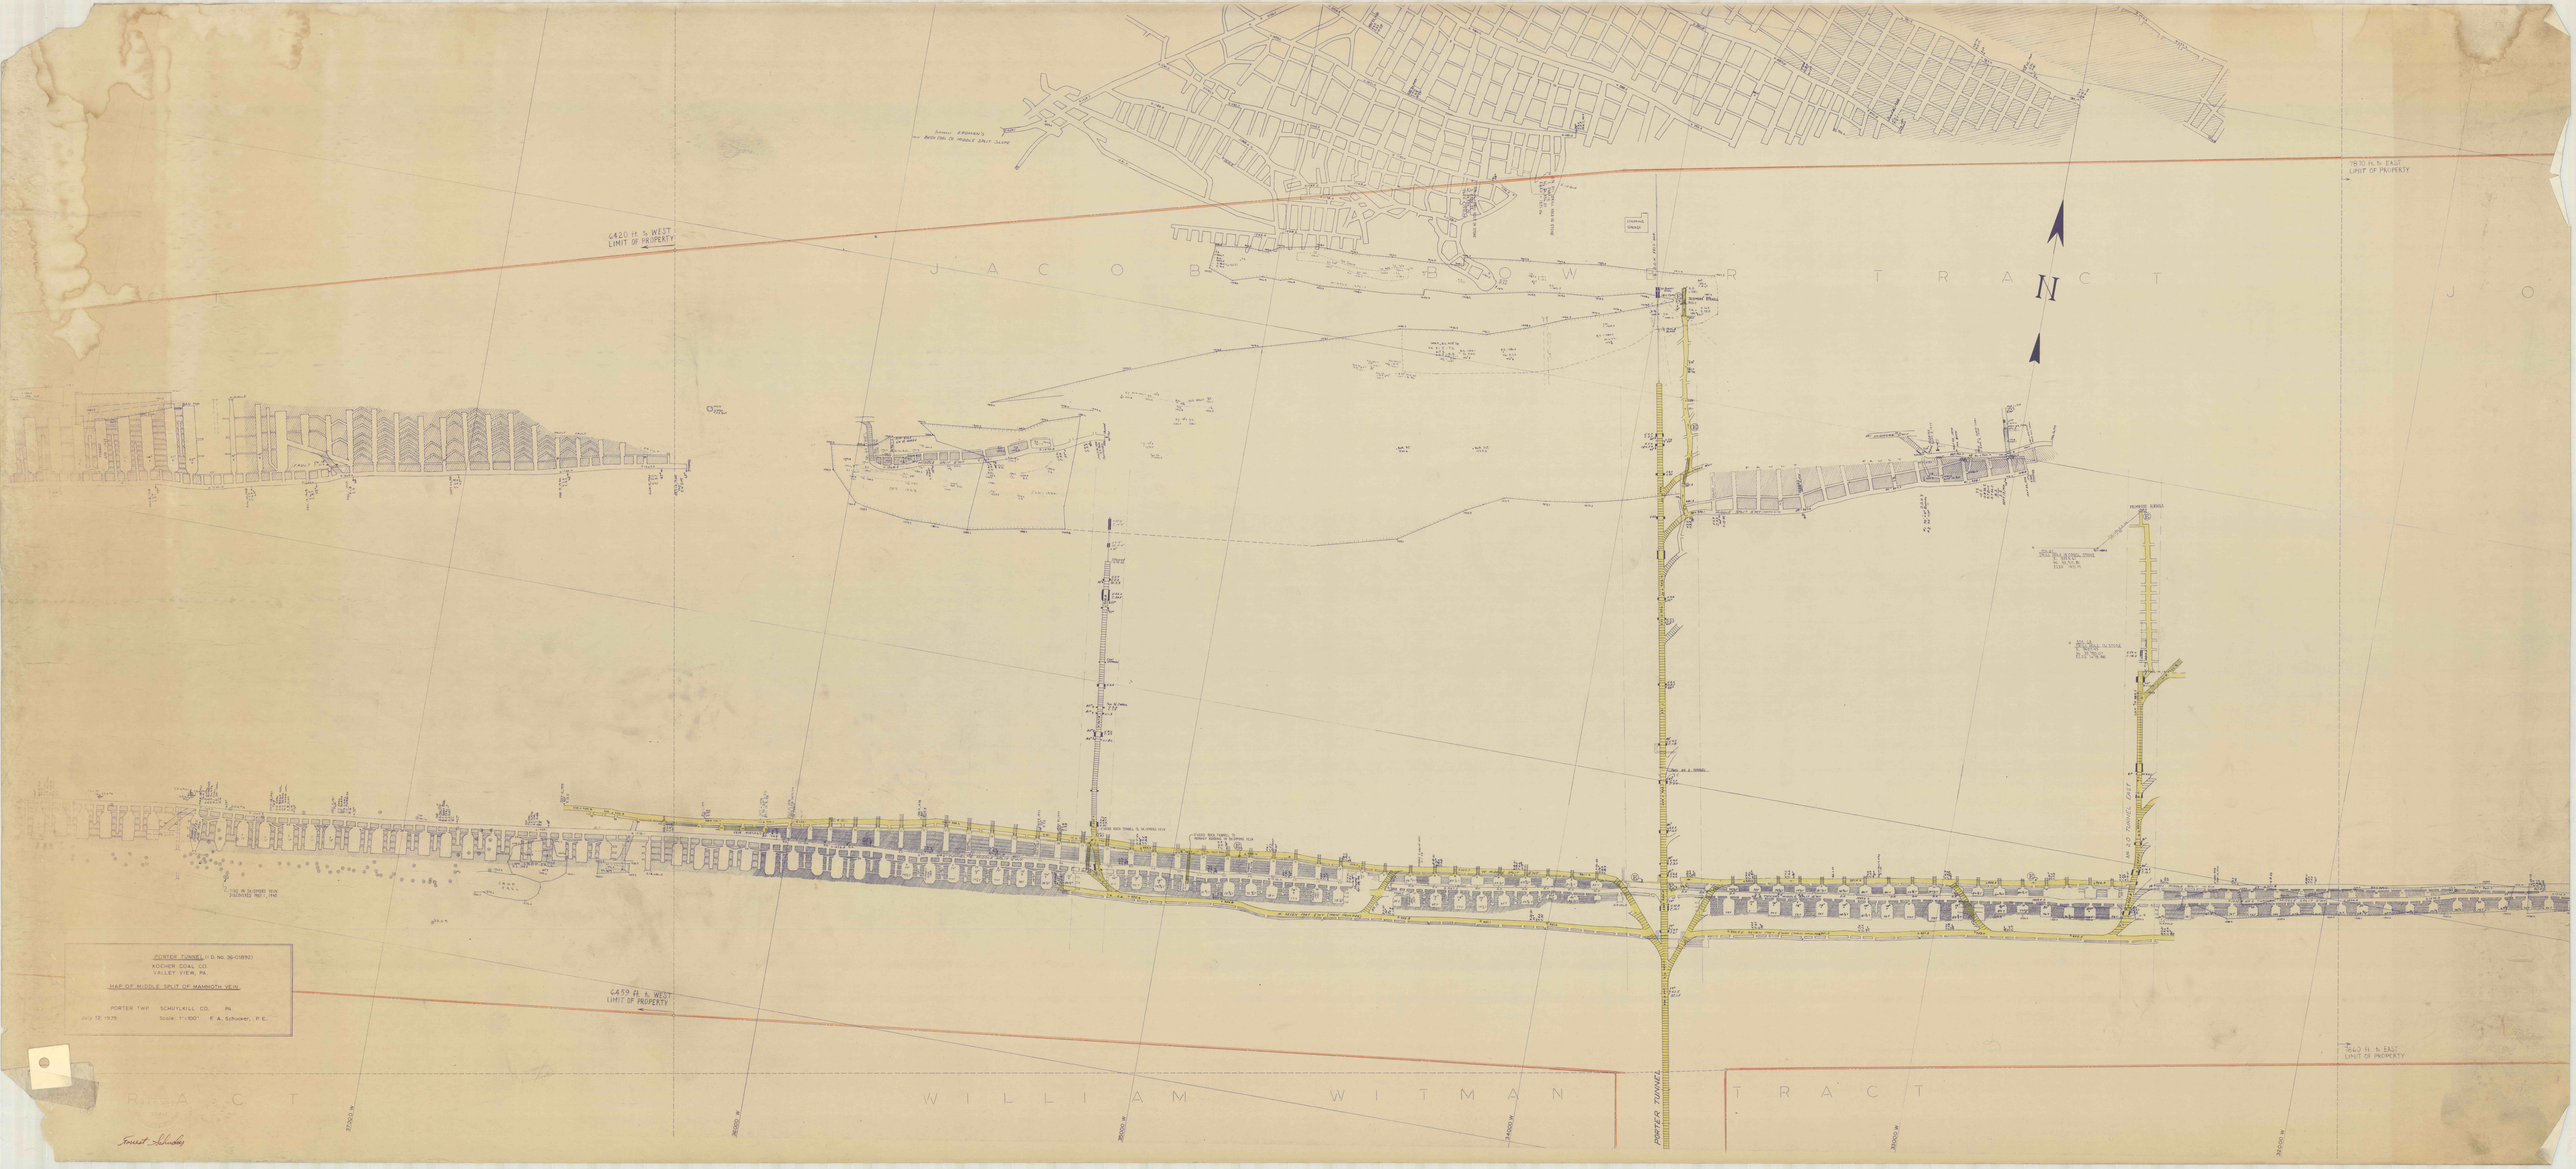
PORTER TUNNEL (I.D. No. 36-01892)
KOCHER COAL CO.
VALLEY VIEW, PA.
MAP OF MIDDLE SPLIT OF MAMMOTH VEIN.
PORTER TWP. SCHUYLKILL CO. PA.
JULY 12, 1979 Scale: 1"=100' E.A. Schuster, P.E.
6420 ft. S. WEST LIMIT OF PROPERTY
6459 ft. S. WEST LIMIT OF PROPERTY
1970 ft. N. EAST LIMIT OF PROPERTY
640 ft. N. EAST LIMIT OF PROPERTY
JACOB BOWER TRACT
WILLIAM WITMAN TRACT
PORTER TUNNEL
N