


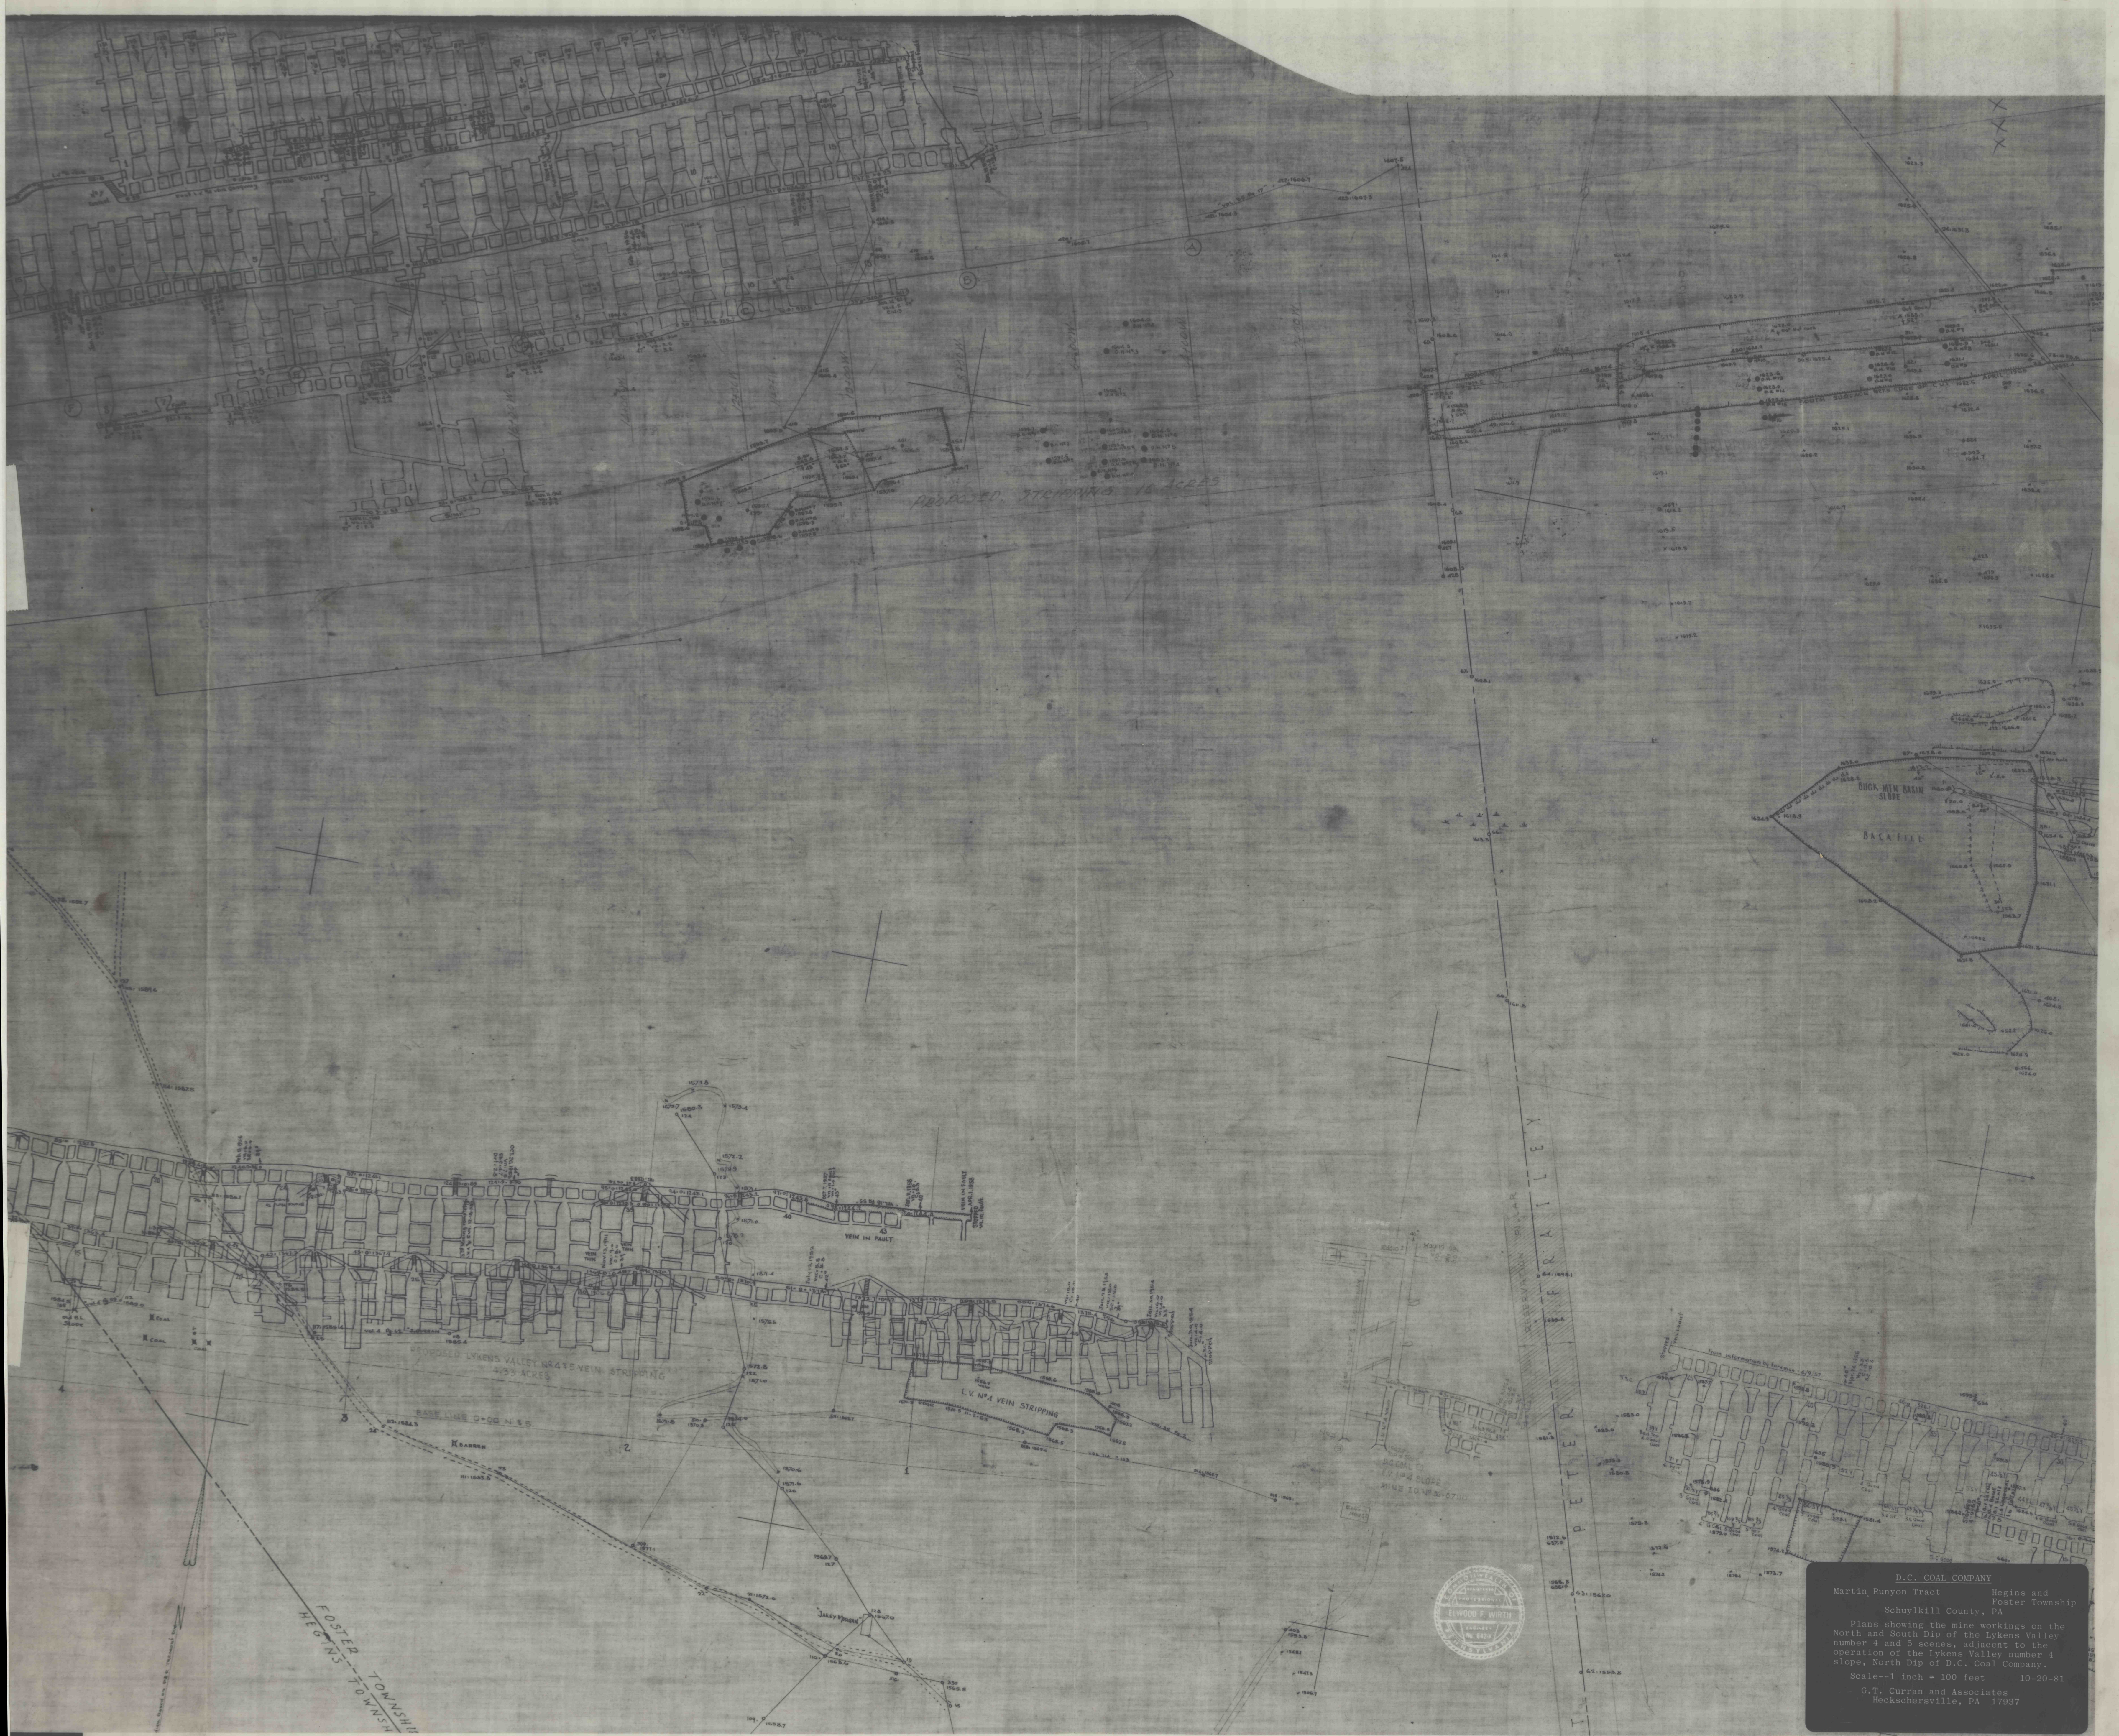

D.C. COAL COMPANY
Martin Runyon Tract
Hegins and
Foster Township
Schuylkill County, PA
Plans showing the mine workings on the
North and South Dip of the Lykens Valley
number 4 and 5 scenes, adjacent to the
operation of the Lykens Valley number 4
slope, North Dip of D.C. Coal Company.
Scale--1 inch = 100 feet 10-20-81
G.T. Curran and Associates
Heckerscherville, PA 17937