

GOOD SPRING COLLIERY - N°3 SLOPE - COLUMNAR BED SECTIONS OF VEINS

SCALE 1" = 10 FEET


TREMONT, PA, JAN 6th 1923

T. V. MONAHAN, DIV. ENGR.

ORCHARD - 1ST LIFT



ORCHARD - 2ND LIFT

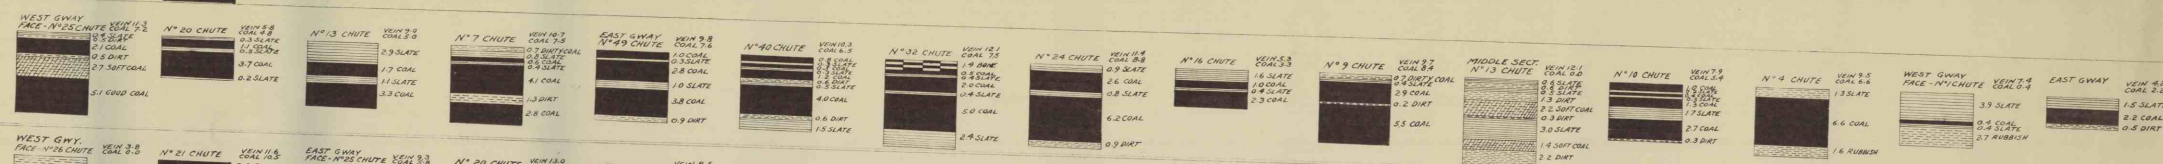


PRIMROSE - 1ST LIFT




PRIMROSE - 2ND LIFT




HOLMES - 1ST LIFT

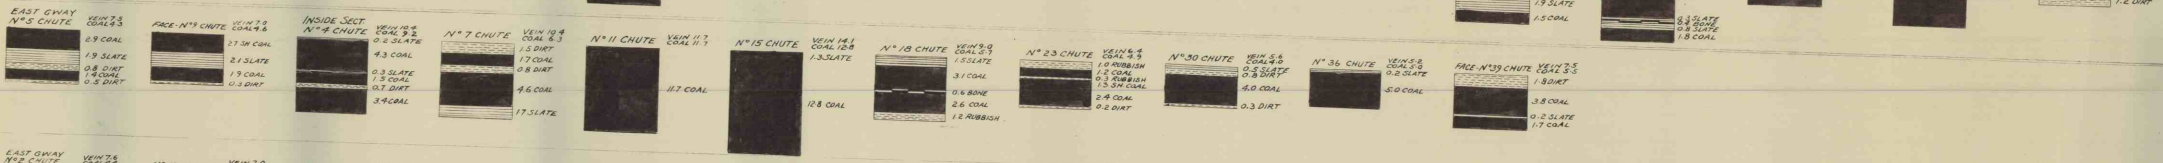


HOLMES - 2ND LIFT

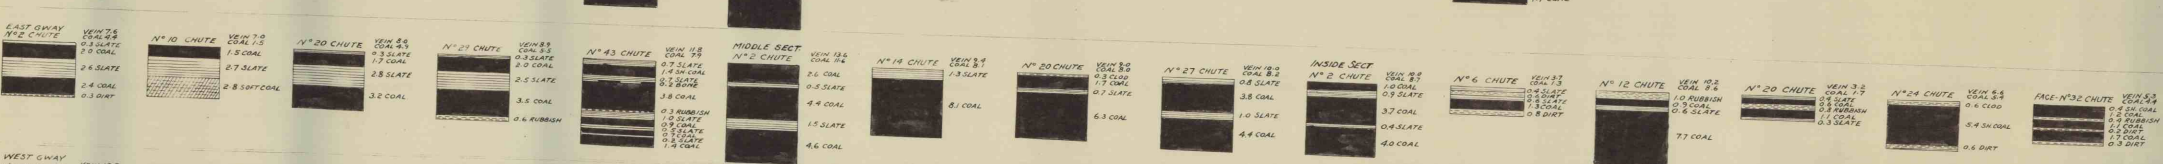


MAMMOTH - 1ST LIFT

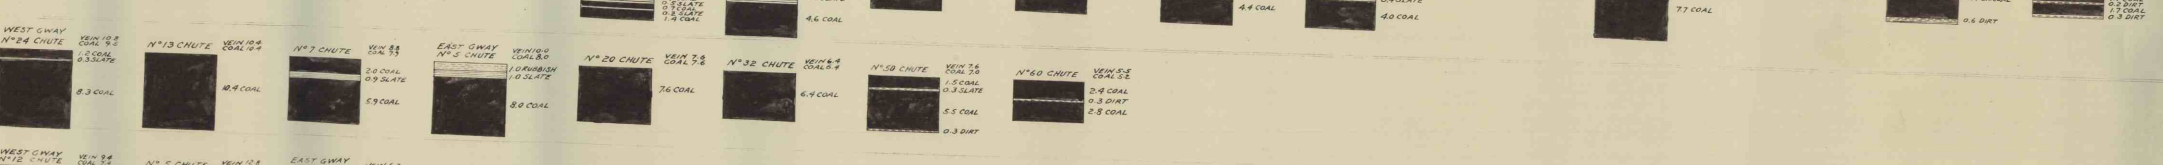


MAMMOTH - 2ND LIFT

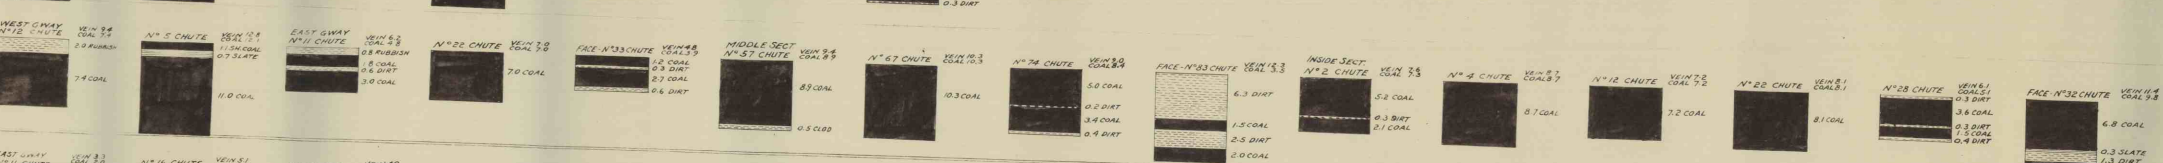


BOTTOM BENCH - 1ST LIFT

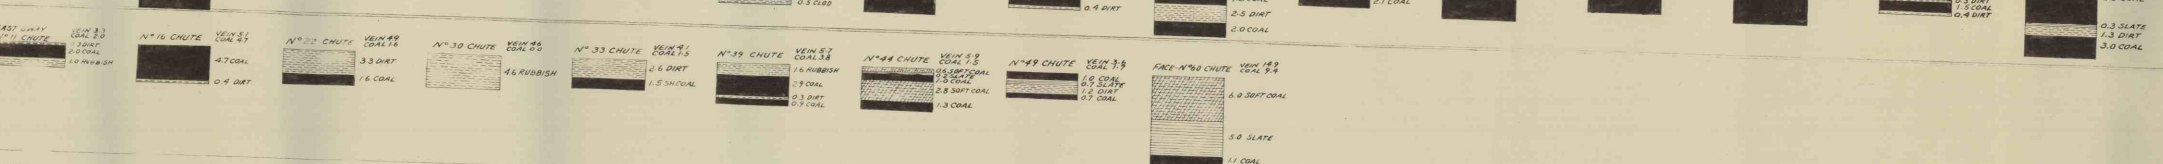


BOTTOM BENCH - 2ND LIFT

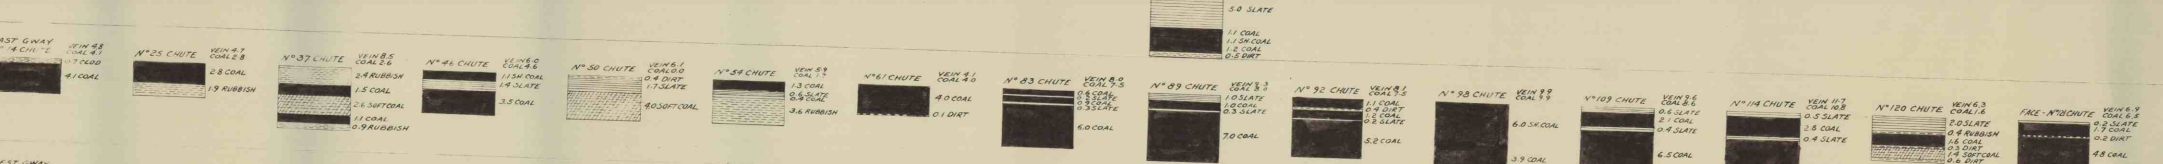


BOTTOM BENCH - 3RD LIFT

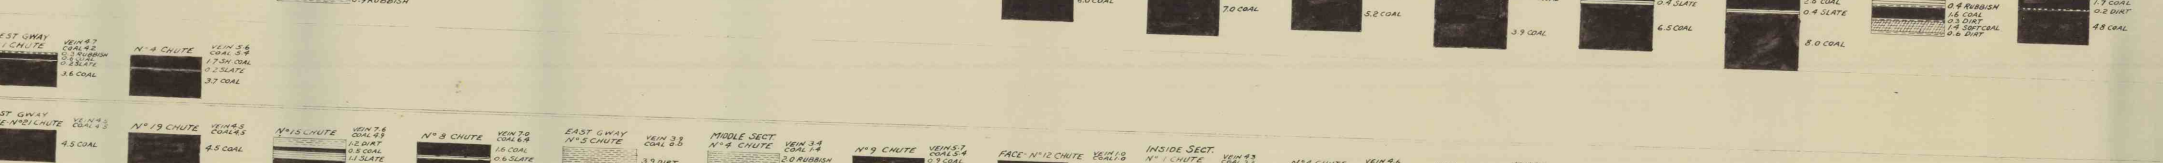


SEVEN FOOT - 1ST LIFT

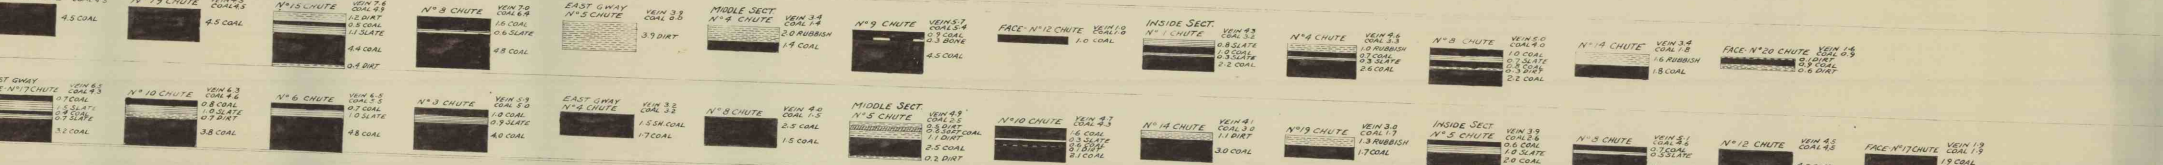


SEVEN FOOT - 2ND LIFT

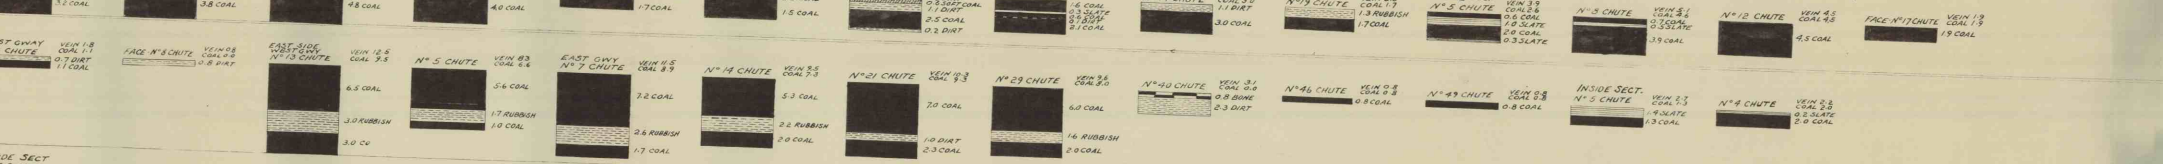


SKIDMORE - 1ST LIFT

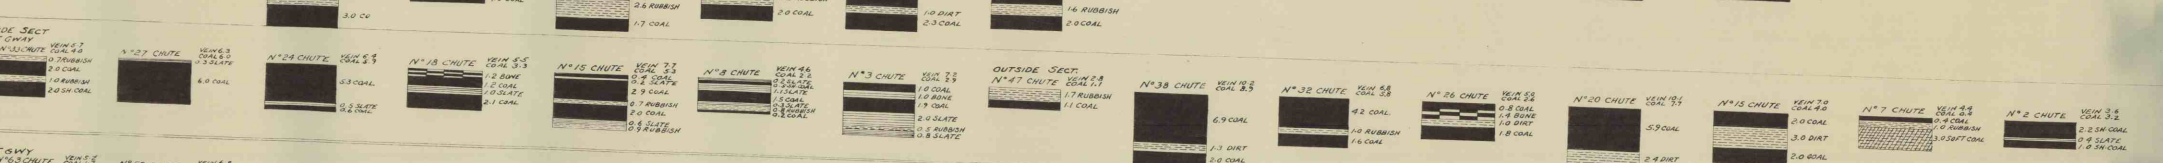


SKIDMORE - 2ND LIFT

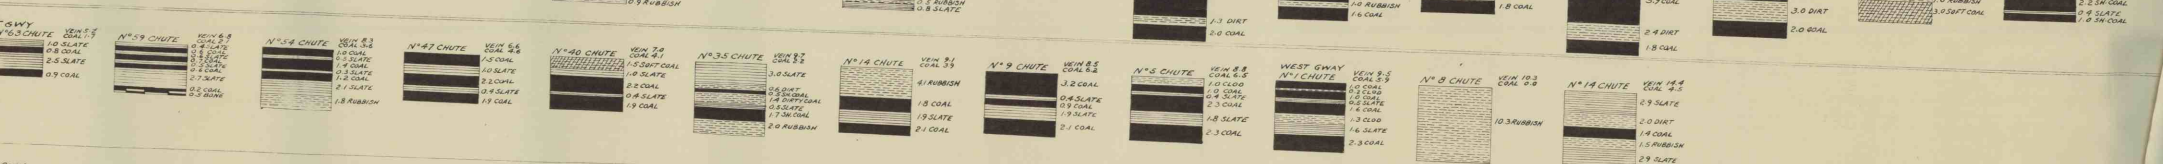

BUCK MTN - 1ST LIFT

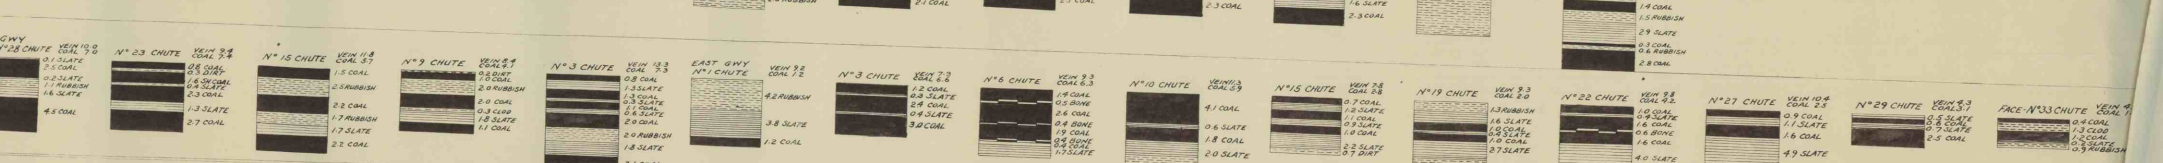

BUCK MTN - 2ND LIFT

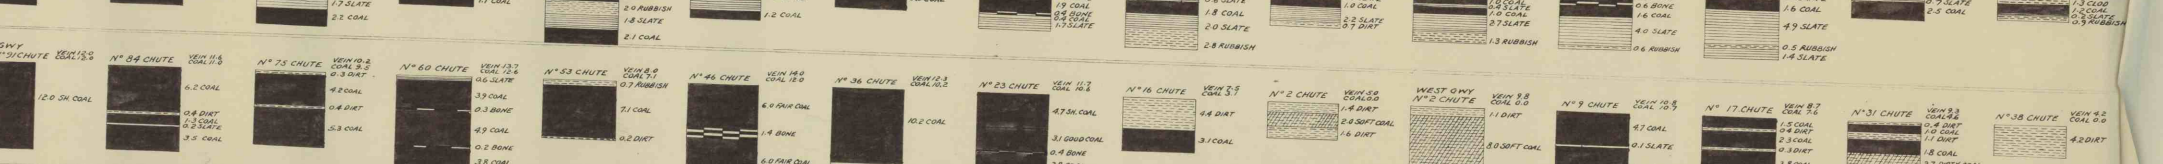

LYKENS VALLEY N°2 - W.L.



LYKENS VALLEY N°4 - W.L.

