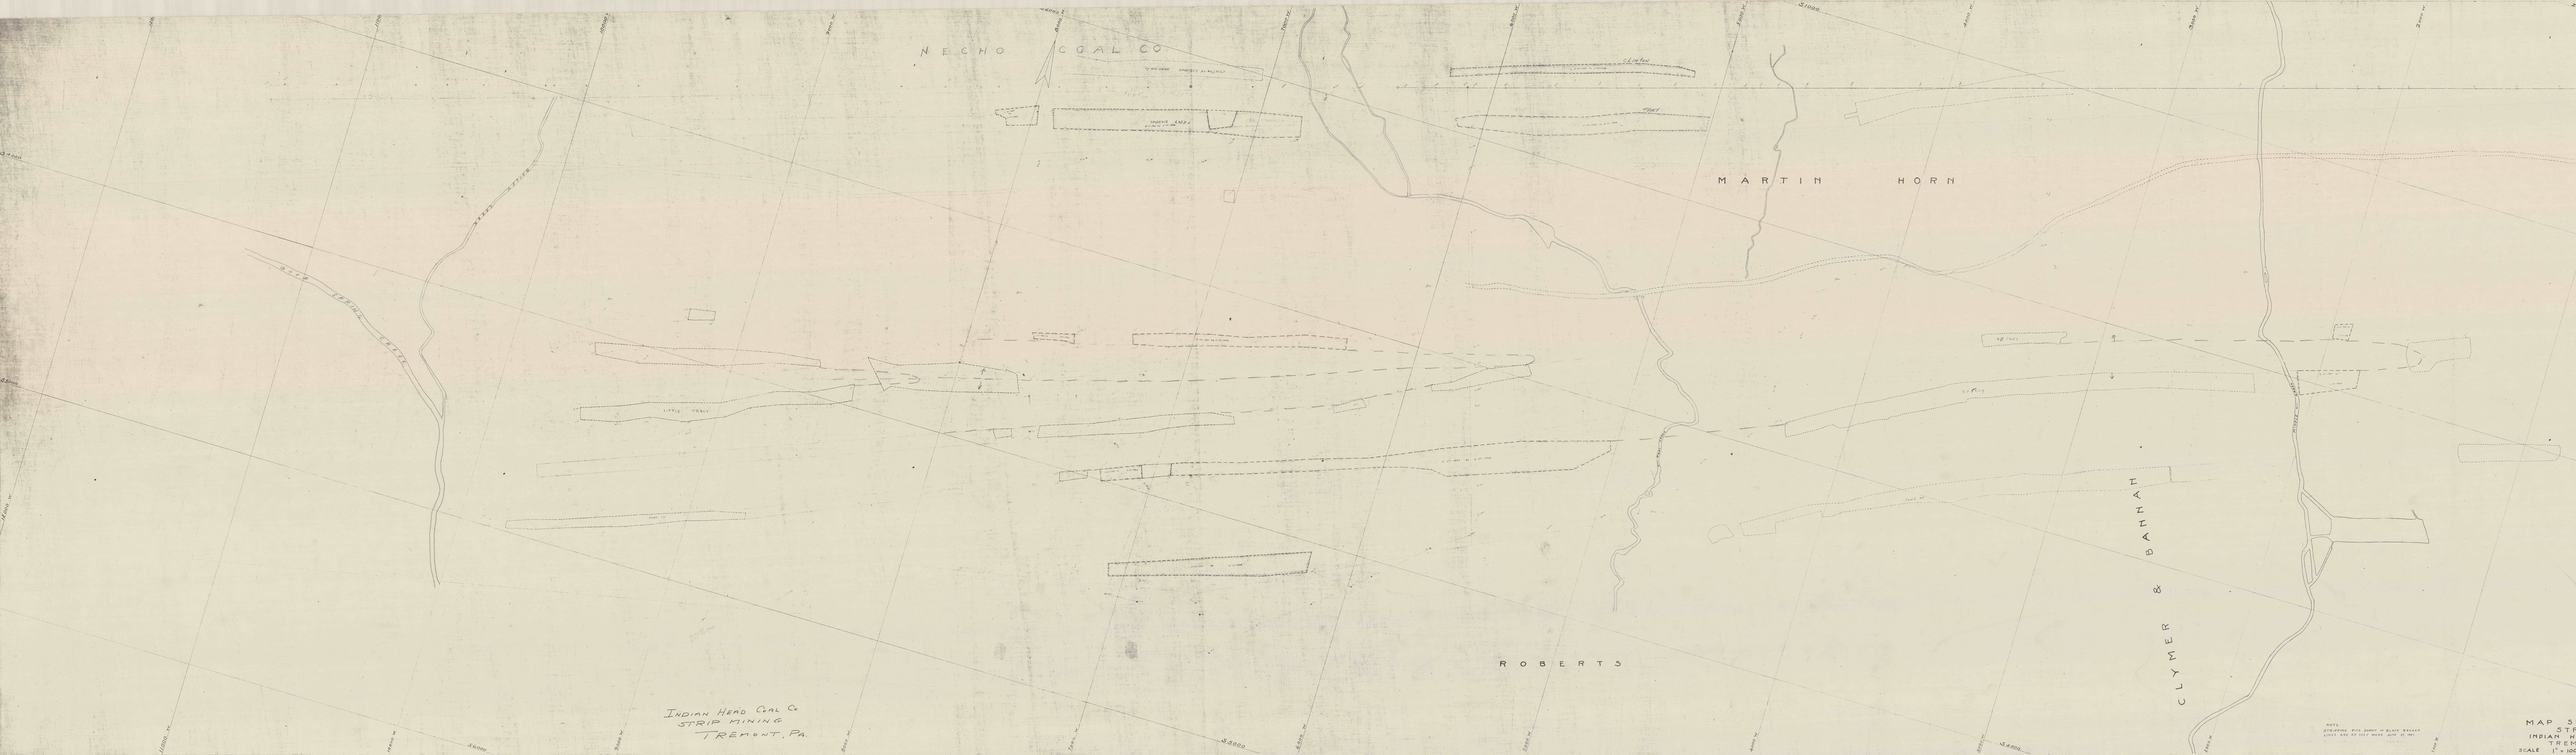

NECHO COAL CO
MARTIN HORN
ROBERTS
CLYMER & BANNAN
LITTLE TRAIL
INDIAN HEAD COAL Co
STRIP MINING
TREMONT, PA.