THOMASTON #4

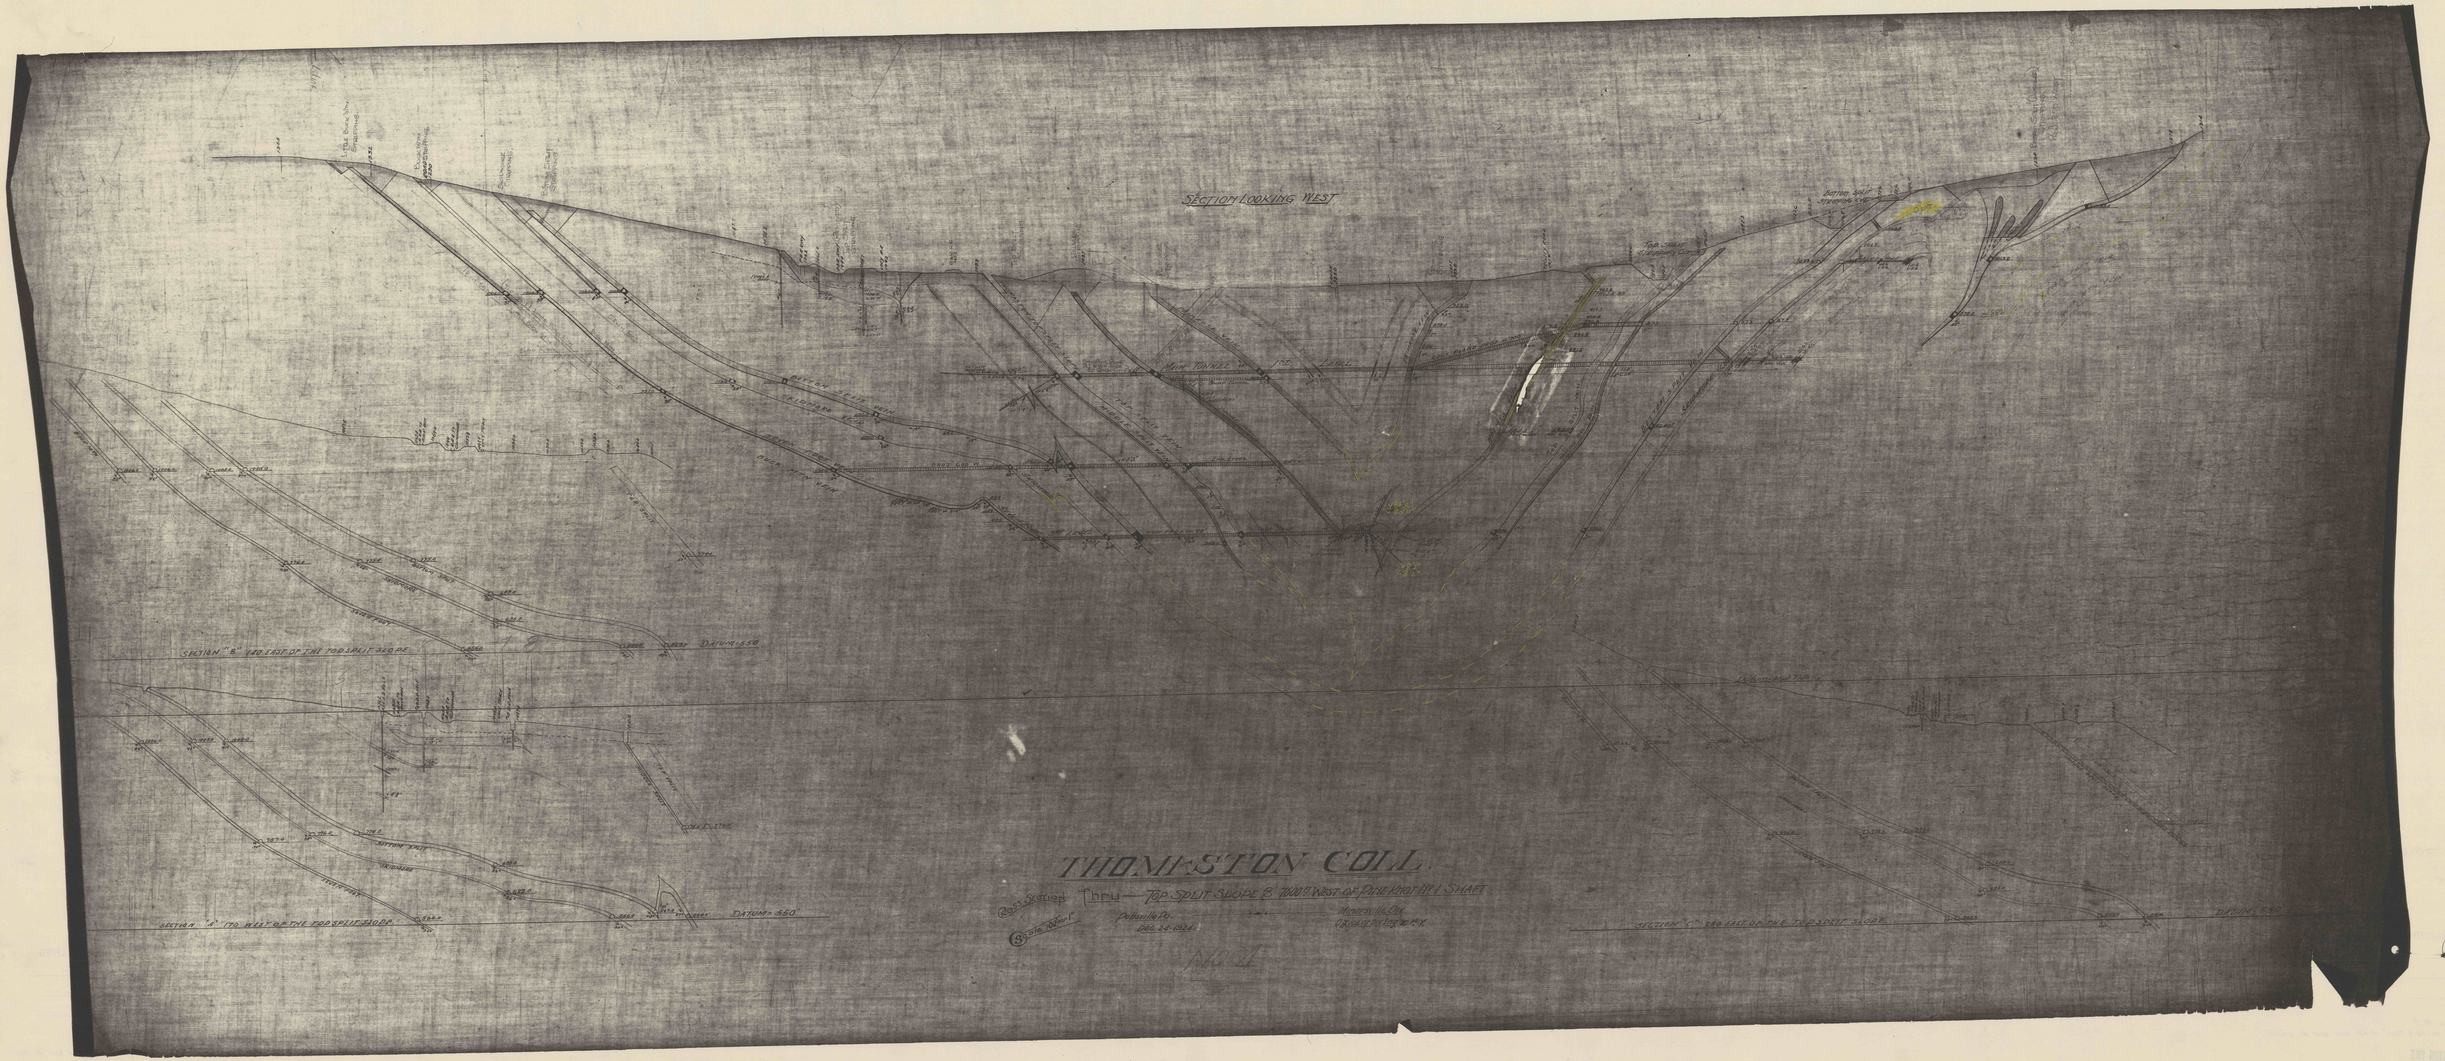

Thomaston #4