A.B. RIEDEL ASSOCIATES ⚒ MINING ENGINEERS

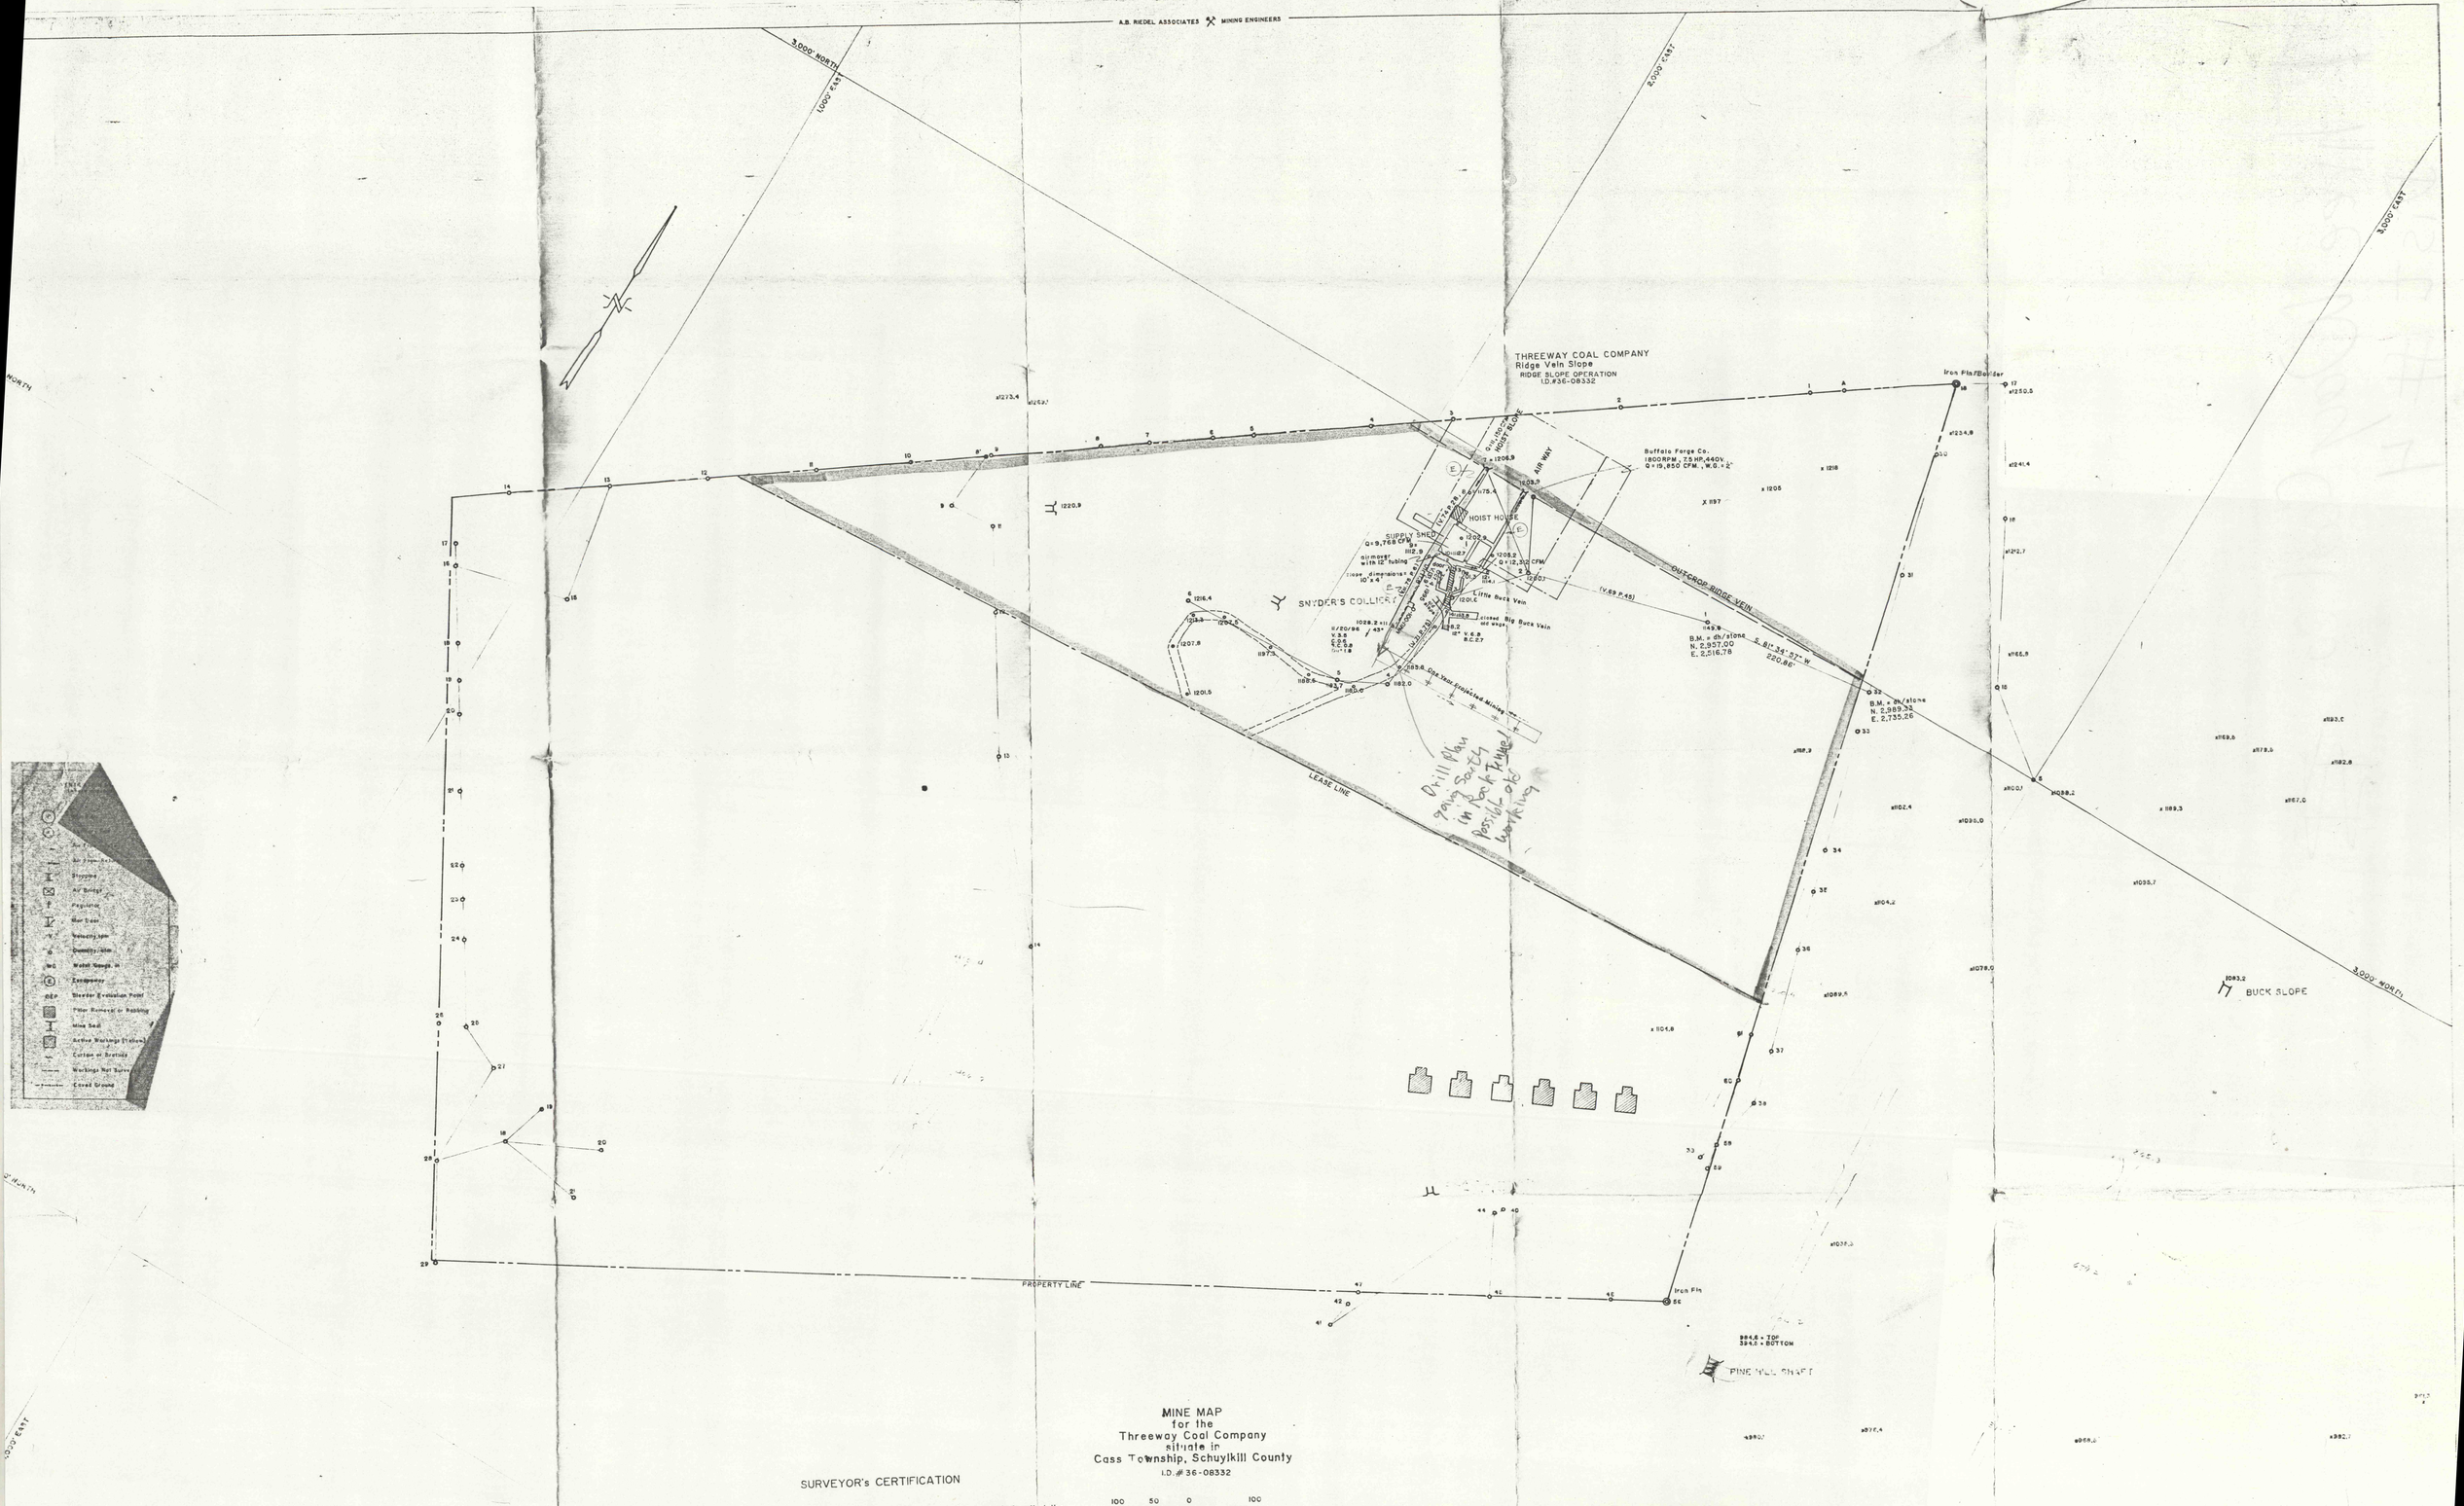

MINE OPERATOR's CERTIFICATION

I depose and say that the mine ventilation information shown on this map meets the requirements of 30 CFR Part 75.372 and was prepared by me or under my direction for which I accept full responsibility.

Robert Williams
Mine Foreman

SURVEYOR's CERTIFICATION

I hereby certify that to the best of my knowledge that the areas that I have surveyed are true and correct as to the requirements of 30 CFR Part 75.1200. All other information shown has been derived from the best available information but can not be field checked. Therefore, surveyor makes no certification to their accuracy.

David L. Williams
Surveyor

MINE MAP
for the
Threeway Coal Company
situate in
Cass Township, Schuylkill County
I.D.# 36-08332

100 50 0 100
Scale 1 inch = 100 feet
SURVEY - OCT. 4, 1995
Nov 20, 1996