


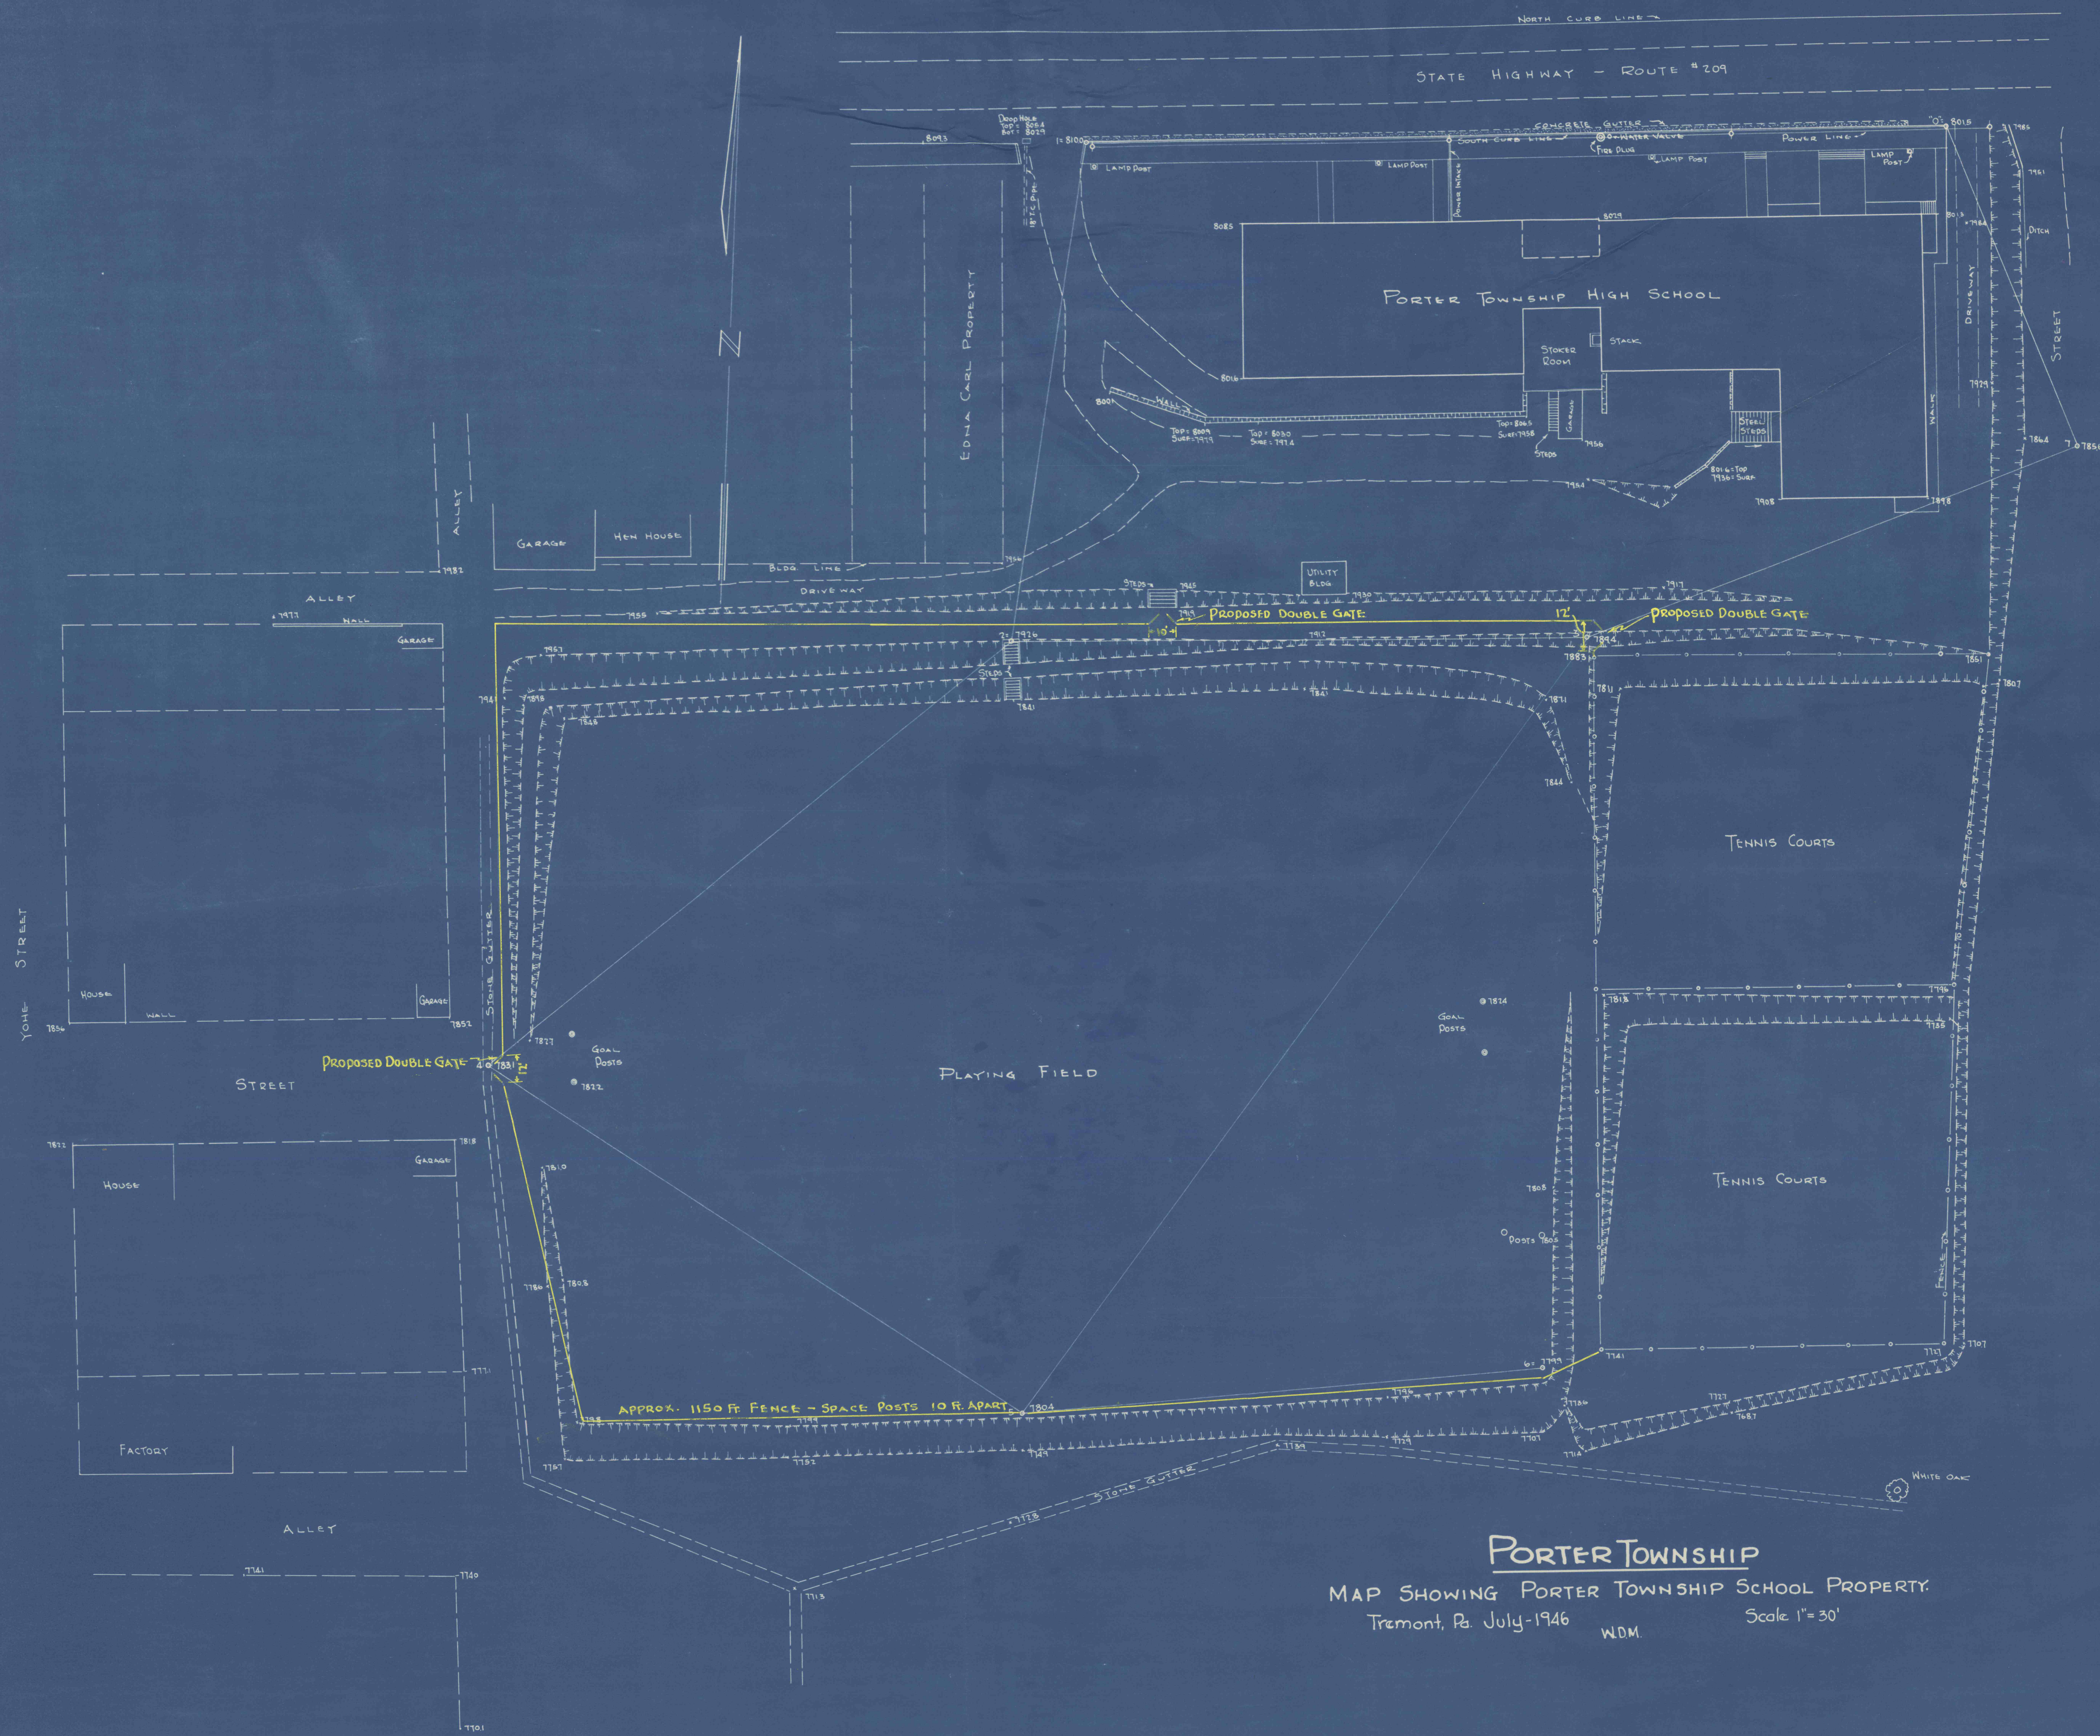

PORTER TOWNSHIP
 MAP SHOWING PORTER TOWNSHIP SCHOOL PROPERTY.
 Tremont, Pa. July-1946 WDM Scale 1"=30'

