


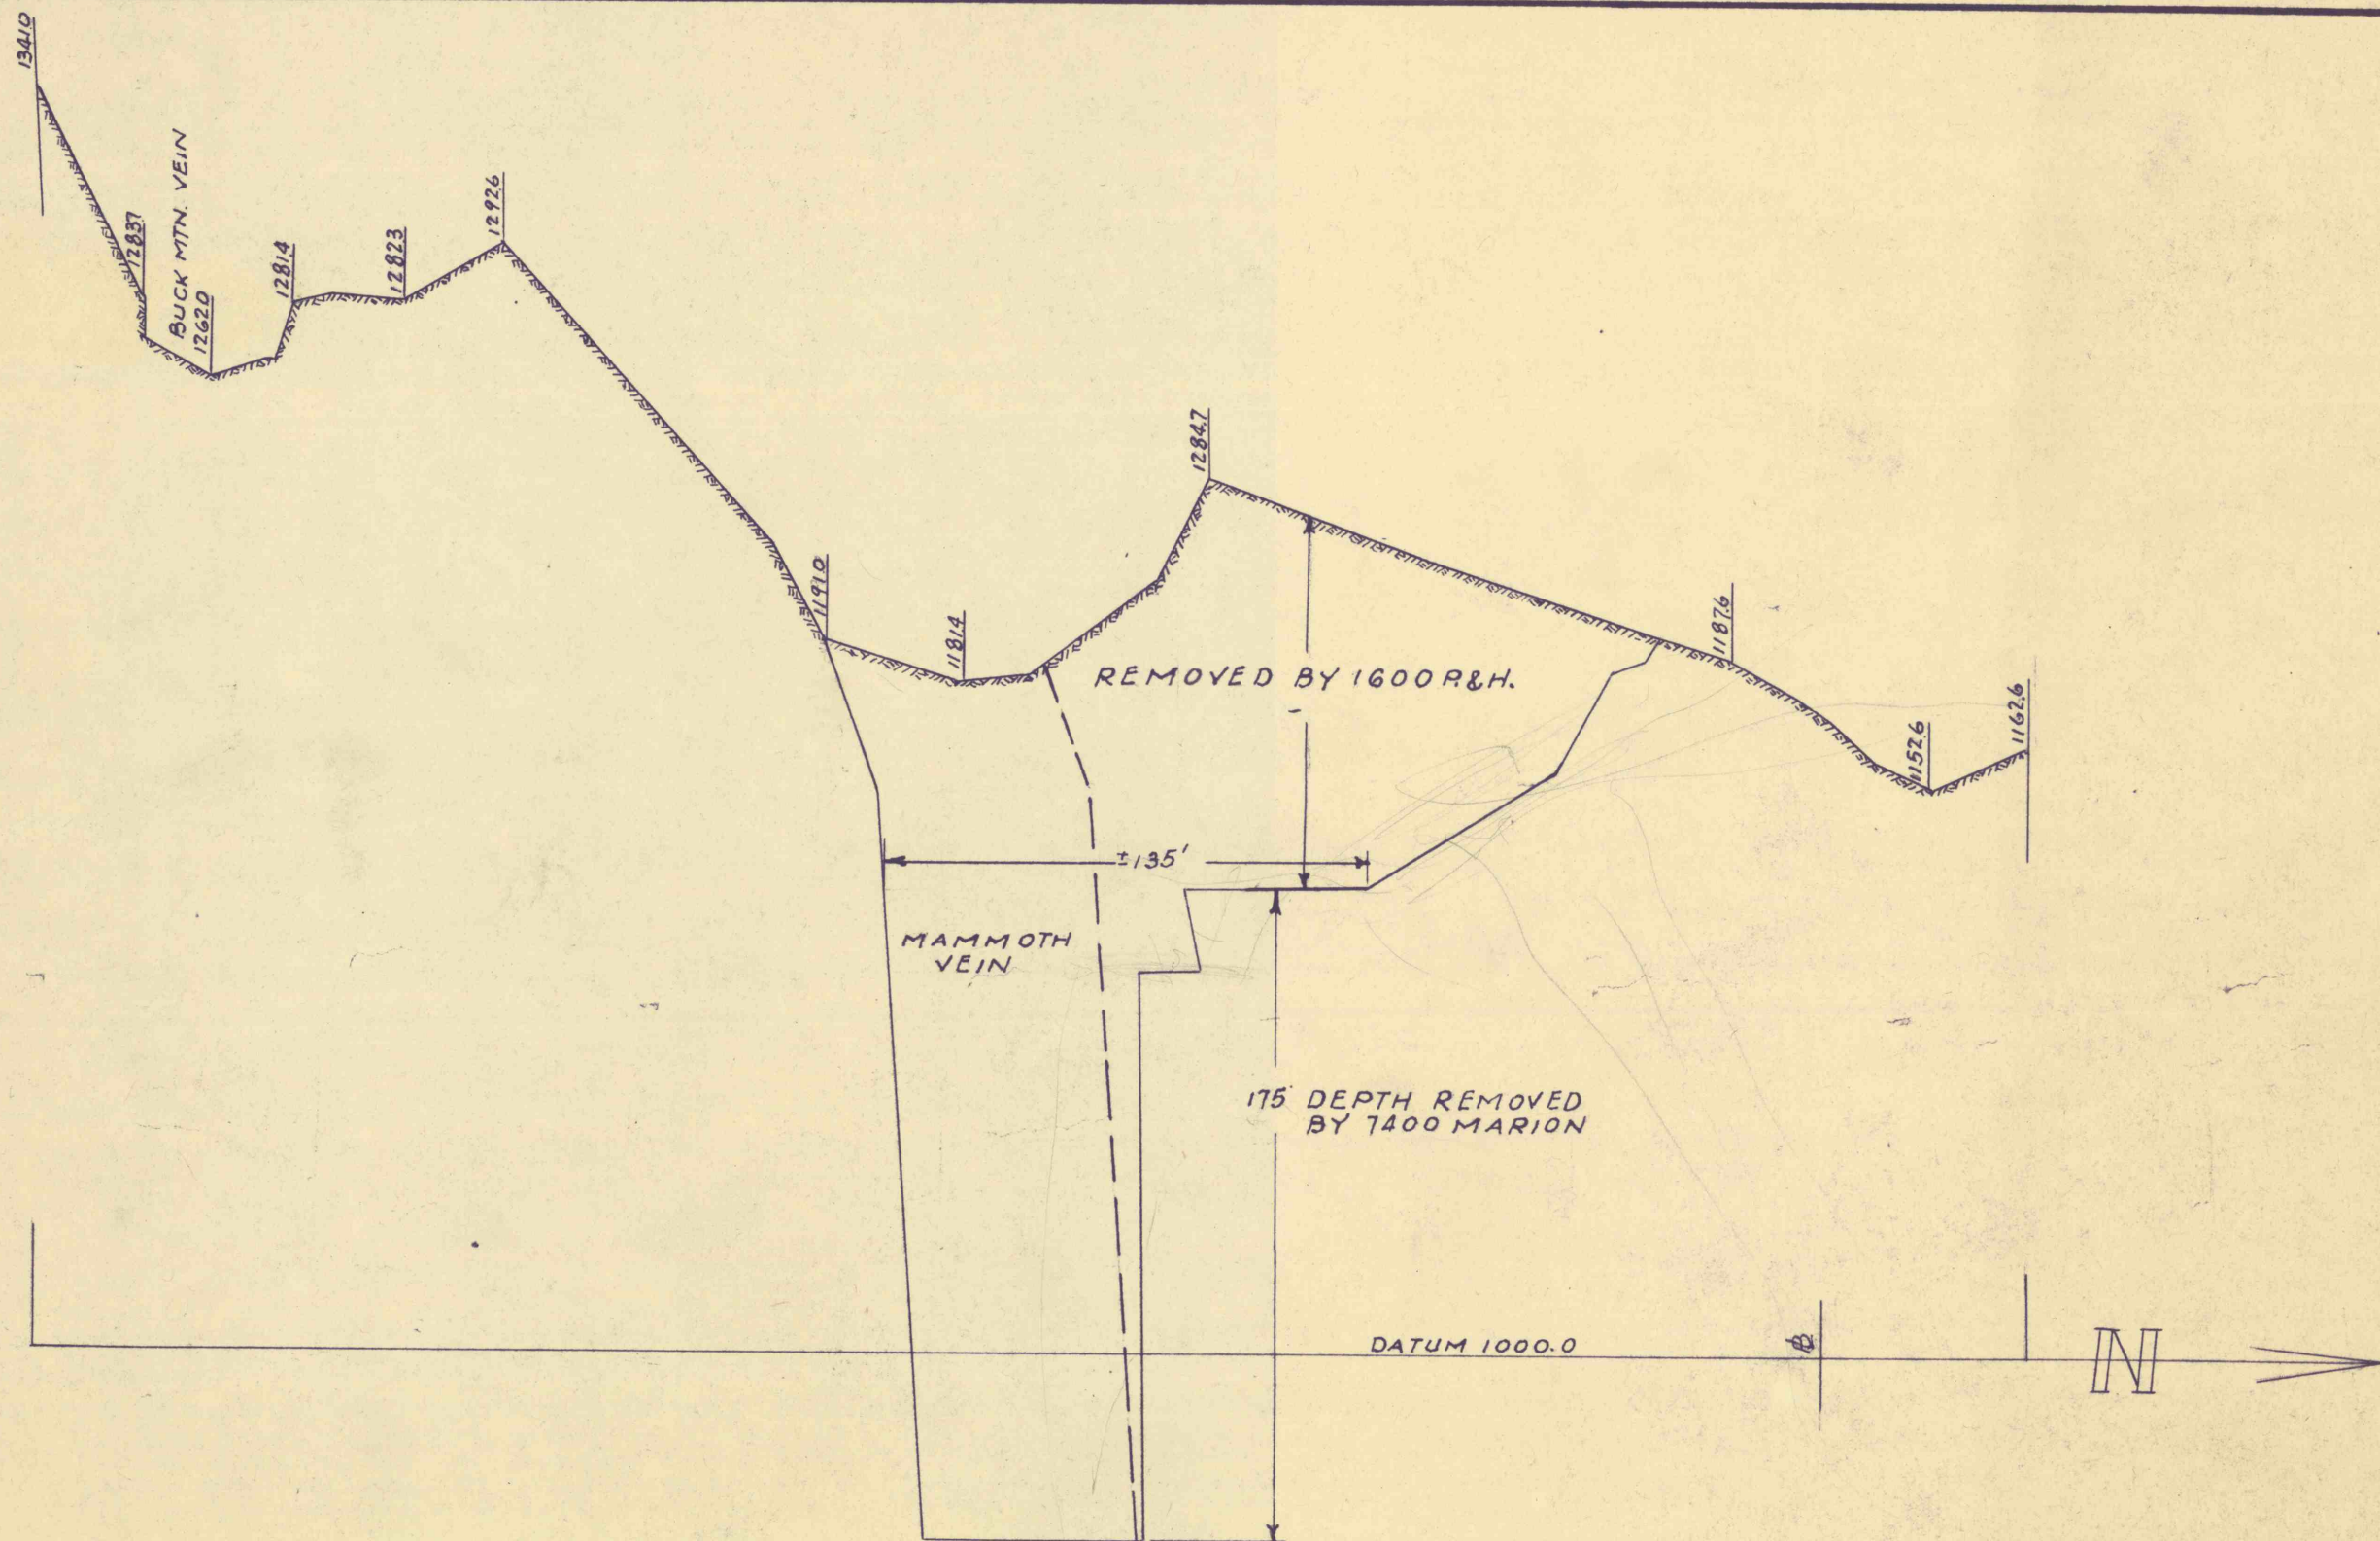

ASHTON SOUTH SIDE STRIPPING
TYPICAL SECTION THROUGH
COMPLETED STRIPPING
SCALE 1 IN = 50 FT.
ENG. DEPT.

FEB. 6-1954
J. ROBERT BAZLEY INC.