

CHECKER VEIN

WEST PITSTON
CEMETERY

MAIN SHAFT OF CLEAR SPRING COLLY.

3600'
ELEV. OF WATER

WHEN RE-OPENED BY ST.C.C. IN 1934


RIVER

S
U
S
Q
U
E
H
A
N
N
A

CHECKER VEIN,
Sullivan Trail Coal Co.

WEST PITSTON, PA.

Scale 1 in. = 100 ft.

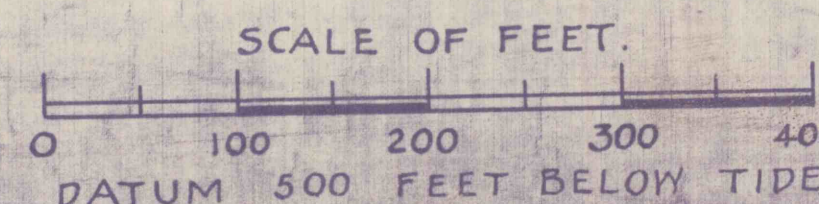

NOTE:
INDICATES NO LEASE.
INDICATES NO LEASE BUT RIGHT
TO PASS THROUGH PRESENT WORKINGS
WITH MINE CAR TRACKS, MAN-WAYS,
AIR WAYS, ETC.

CHECKER VEIN.