

TOP CLARK VEIN

LEHIGH VALLEY COAL CO.

STEVENS COLL'Y.

BARREER PILLAR

WEST PITSTON
CEMETERY

SHAFT-RESERVATION
TOP-CLARK


COLL'Y.
SENECA
R

TOP CLARK VEIN.

Sullivan Trail Coal Co.

WEST PITSTON, PA.

Scale 1 in. = 100 ft.

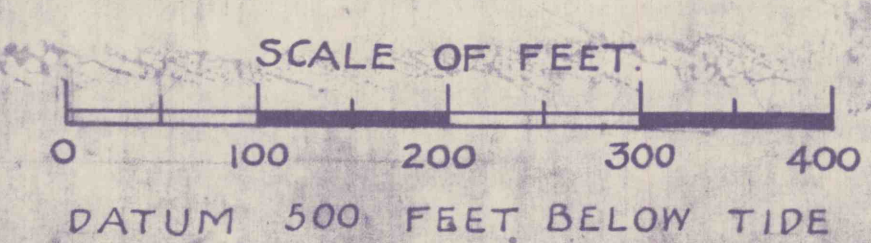

NOTE:
INDICATES NO LEASE
INDICATES NO LEASE, BUT RIGHT
TO PASS THROUGH PRESENT WORKINGS
WITH MINE CAR TRACKS, MAINWAYS,
AIRWAYS, ETC.

TOP CLARK VEIN