


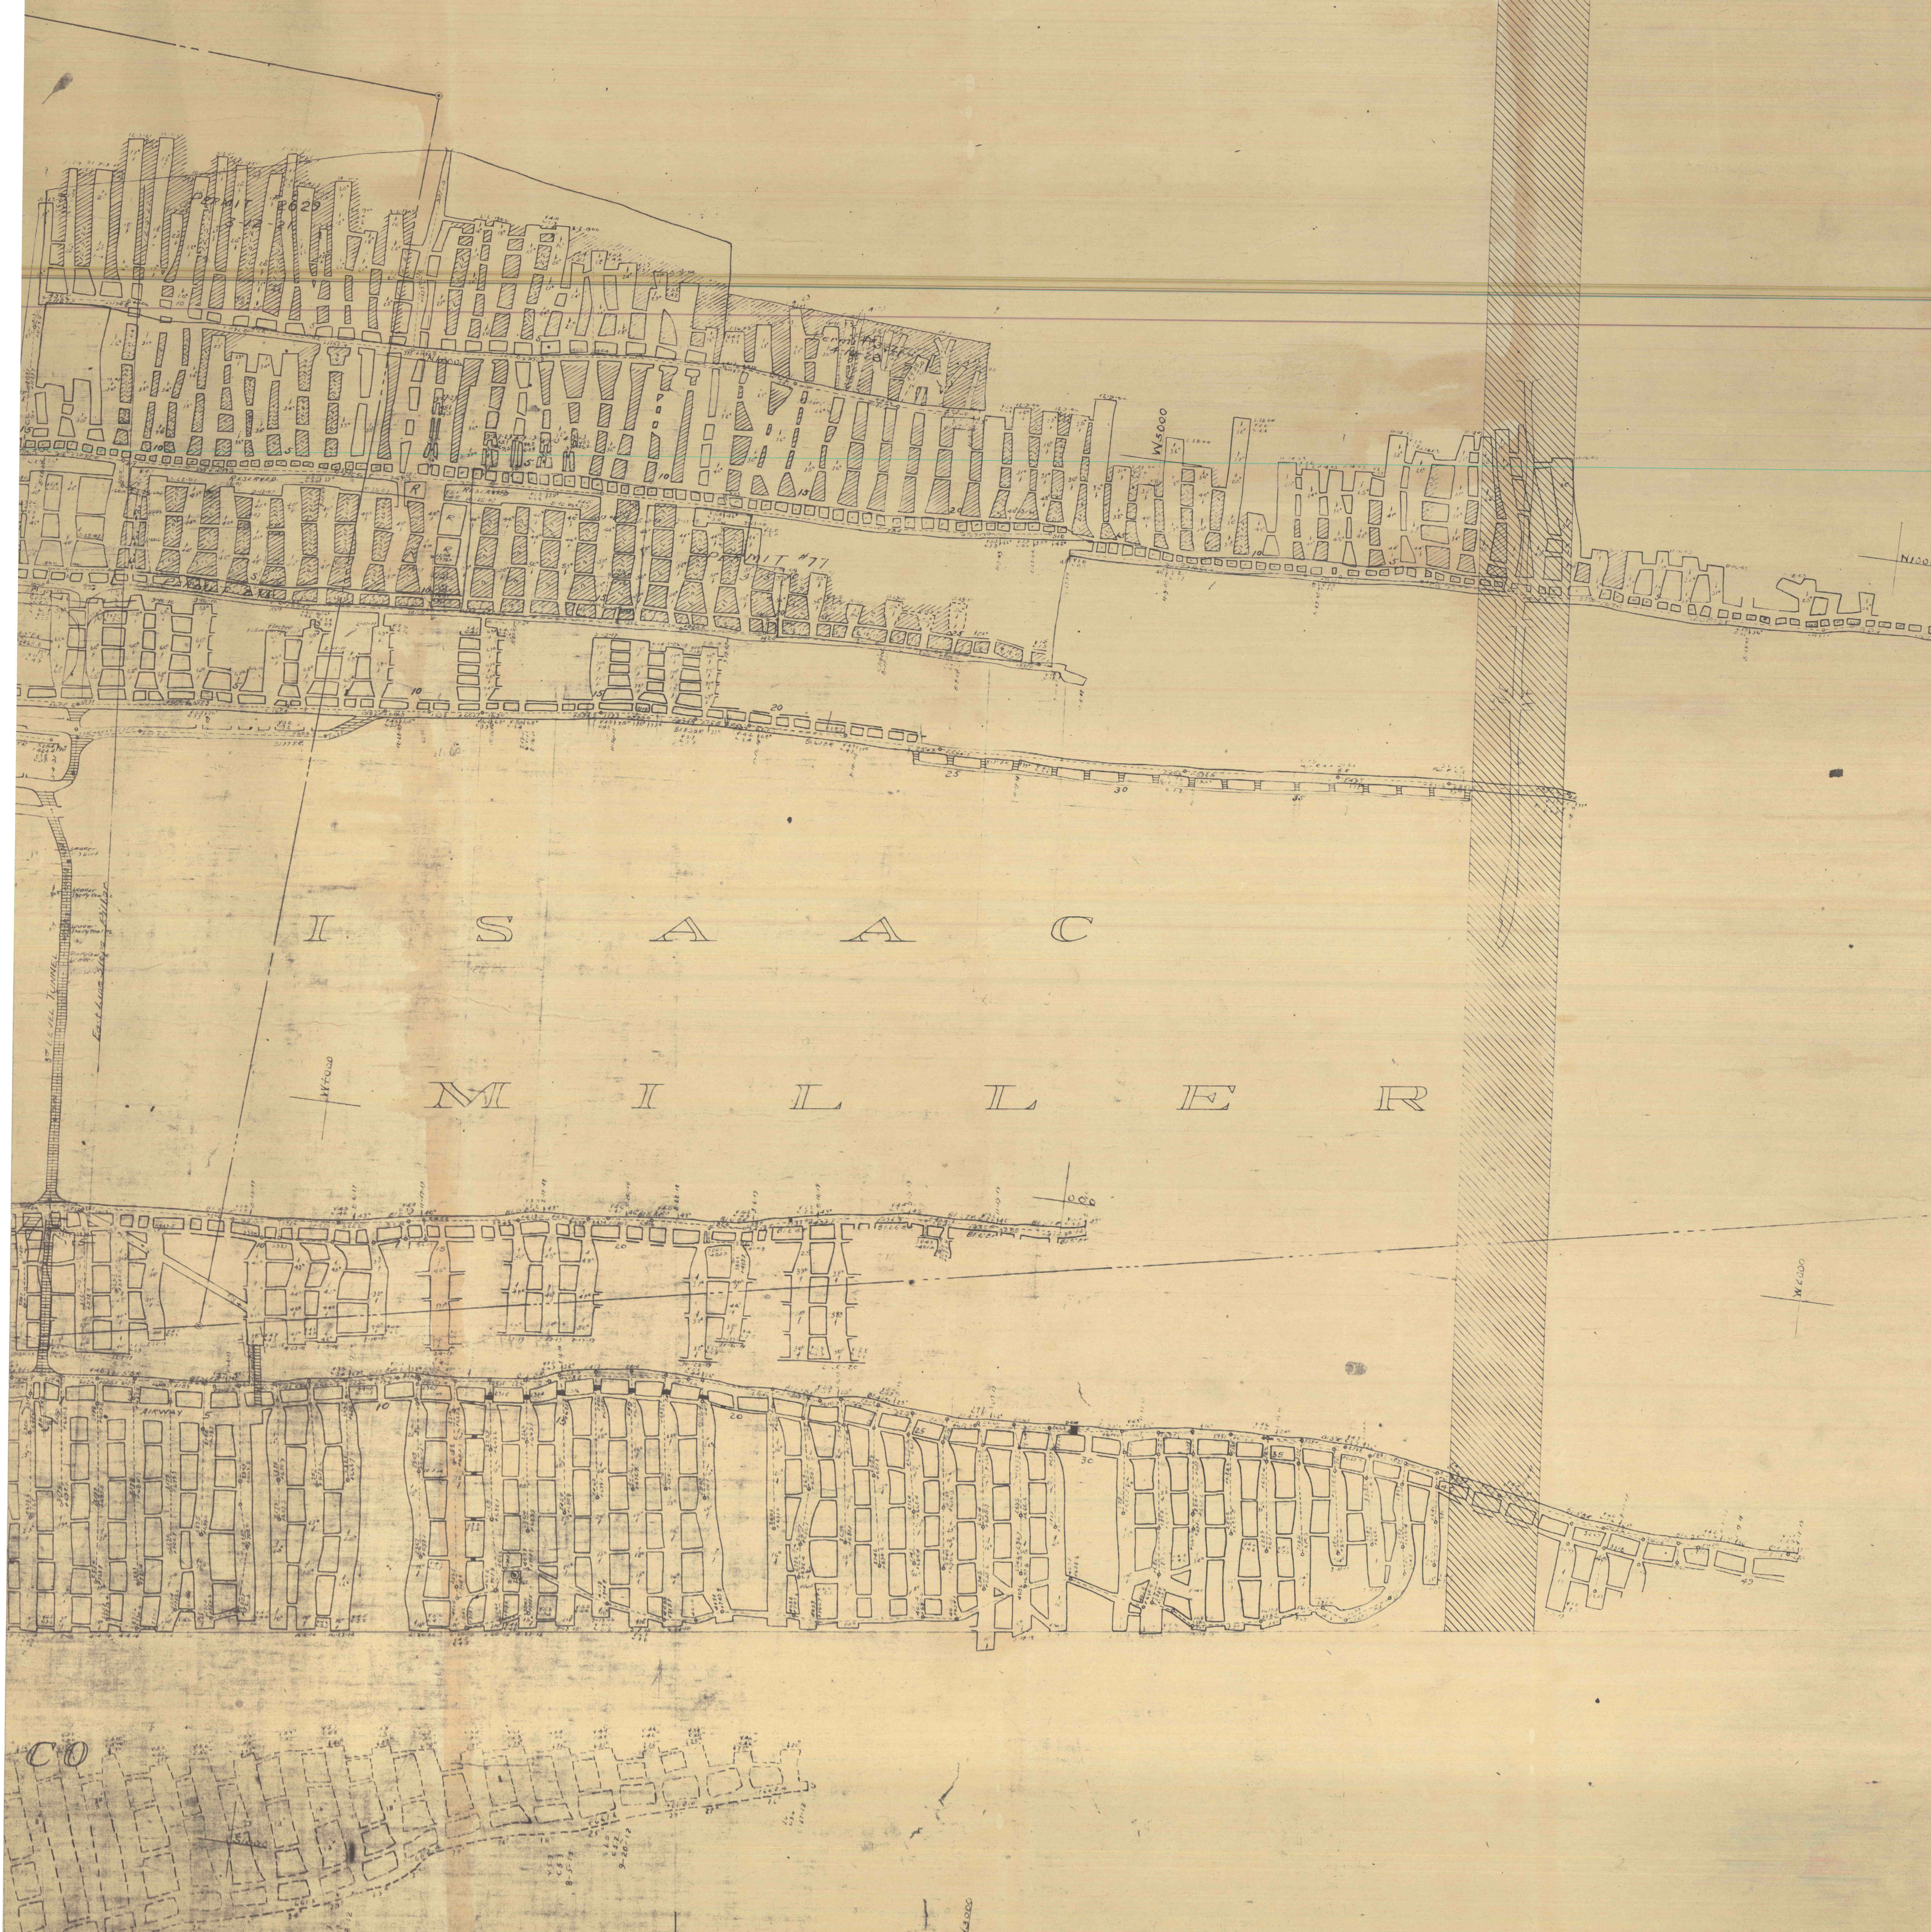

SEVEN FOOT VEIN
— at —
SIOUX No. 3 COLLIERY
— OF THE —
Lehigh Valley Coal Company
ENGINEERING DEPARTMENT L.V.C. CO. LOCOMOTIVE