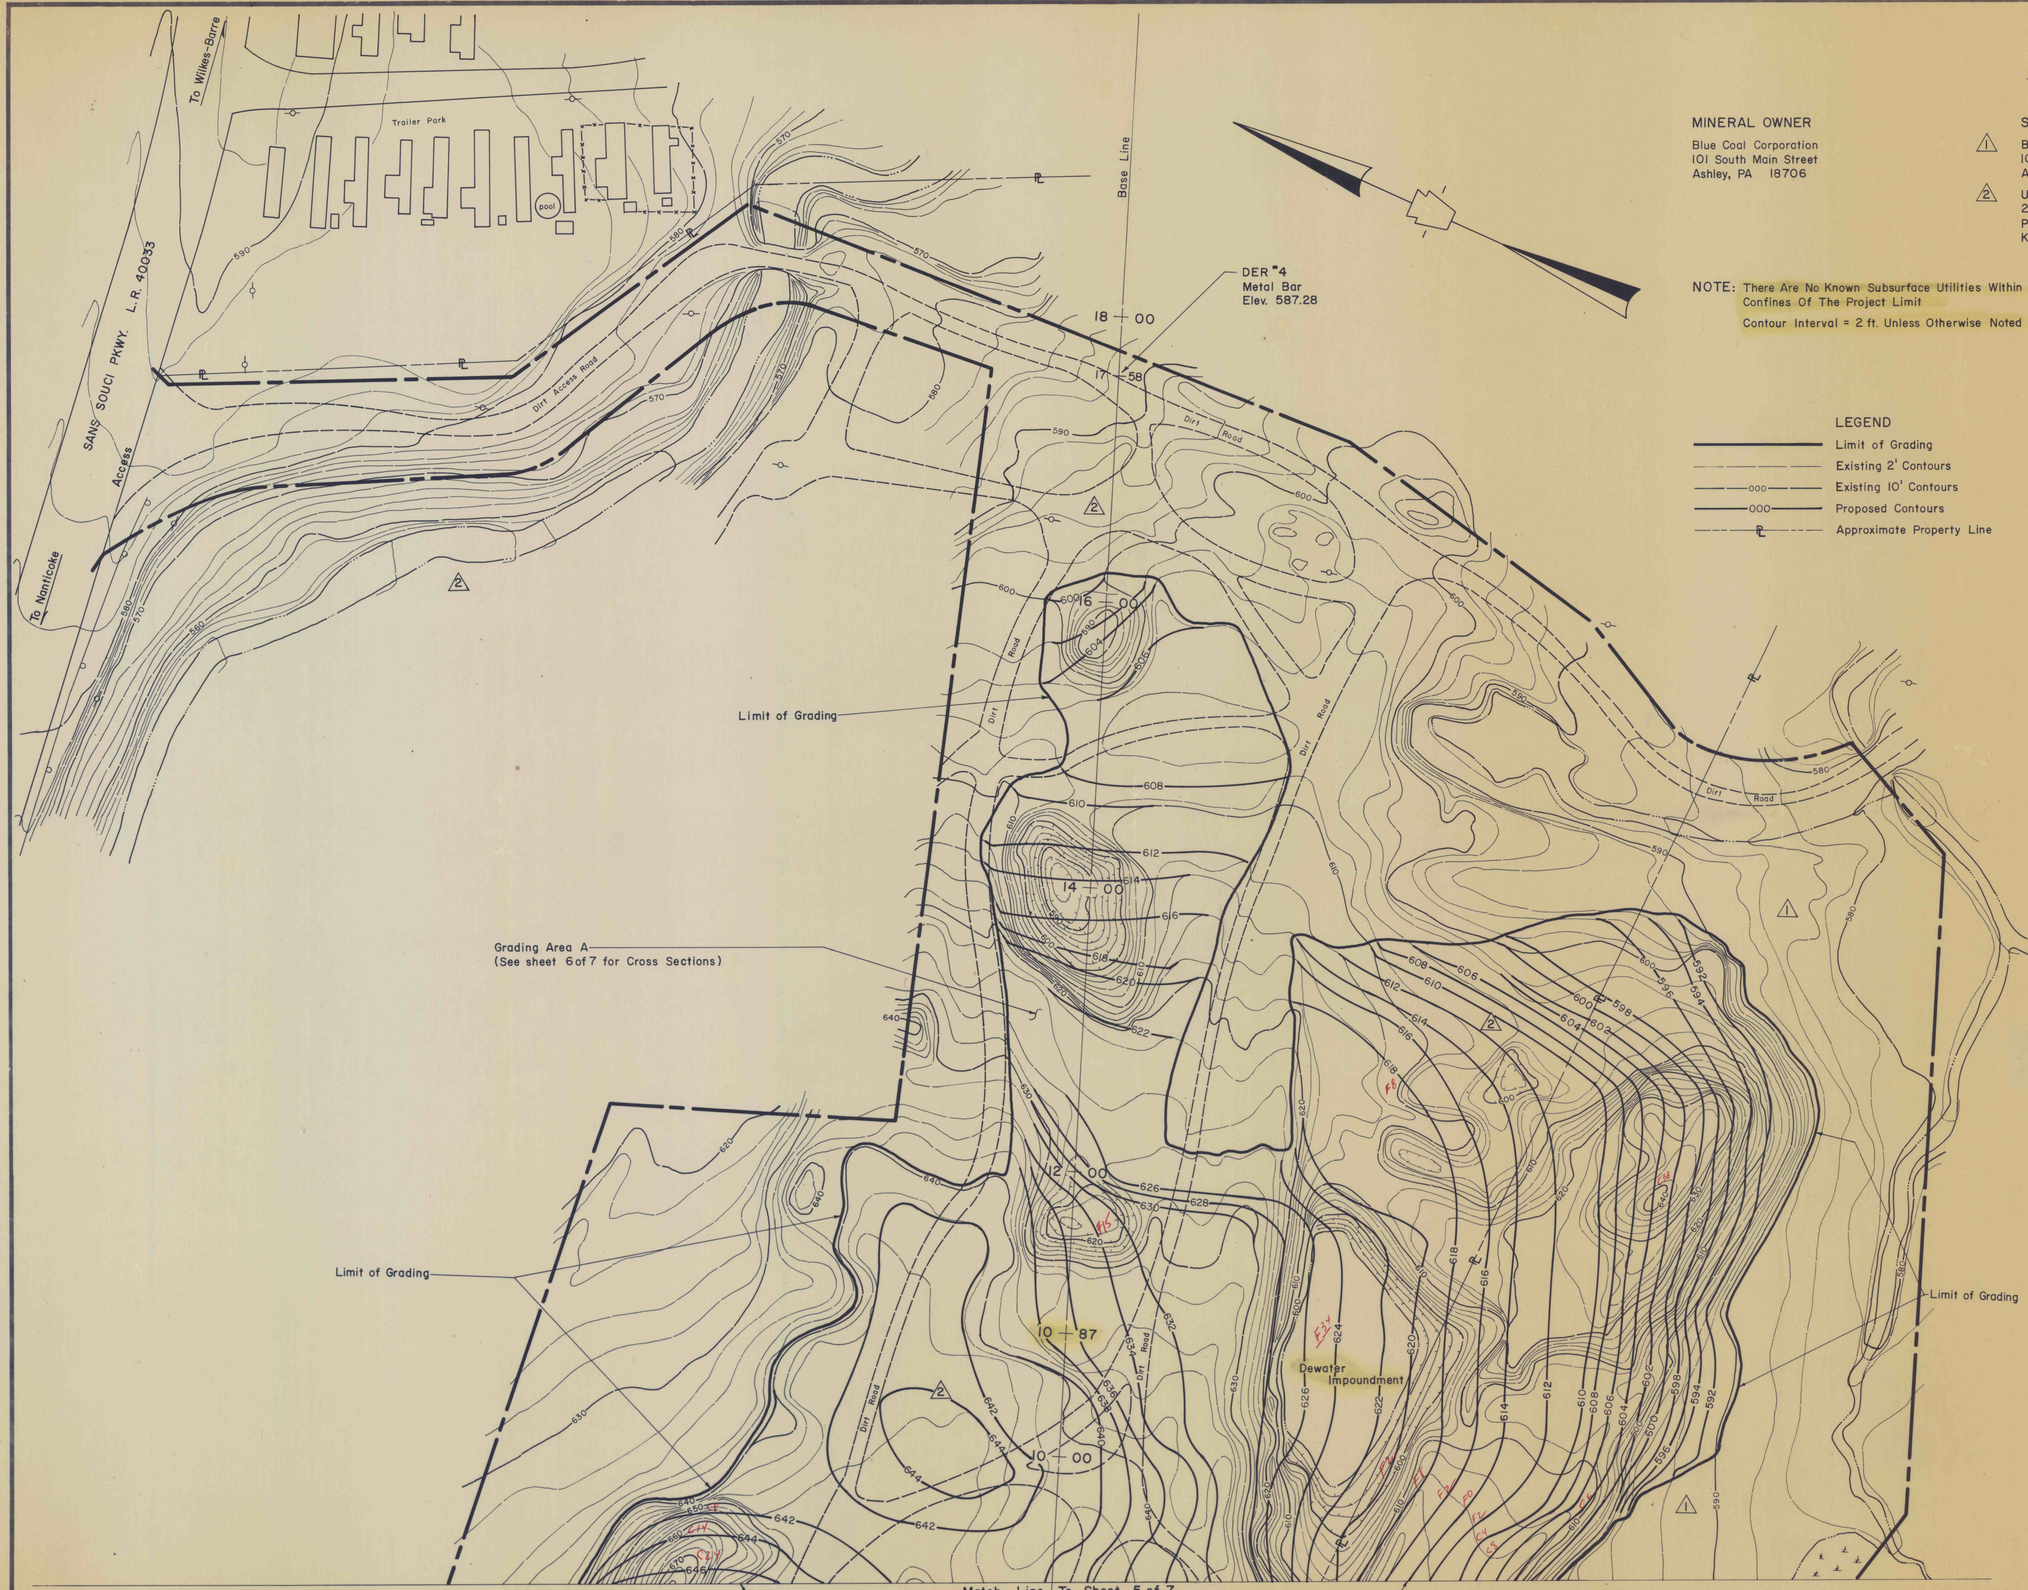

MINERAL OWNER

Blue Coal Corporation
101 South Main Street
Ashley, PA 18706

SURFACE OWNERS

1 Blue Coal Corporation
101 South Main Street
Ashley, PA 18706

2 UGI Corporation
247 Wyoming Avenue
P.O. Box 1389
Kingston, PA 18704-0389

NOTE: There Are No Known Subsurface Utilities Within The Confines Of The Project Limit

Contour Interval = 2 ft. Unless Otherwise Noted

LEGEND

- Limit of Grading
- Existing 2' Contours
- Existing 10' Contours
- Proposed Contours
- Approximate Property Line

TOPOGRAPHY BY:
The EADS Group
EADS
1126 Eighth Avenue
P.O. Box 1887
Altoona, PA 16603
Using Aerial Photography
Dated 3-18-86

NO.	DATE	REVISION	APPR.

SUBMITTED Charles J. Fisher
CHIEF, DESIGN SECTION, WILKES-BARRE

APPROVED Michael R. Ferko
DISTRICT ENGINEER, WILKES-BARRE

APPROVED Richard J. Hoffman
DIRECTOR, BUREAU OF ABANDONED MINE RECLAMATION

COMMONWEALTH OF PENNSYLVANIA REGISTERED PROFESSIONAL THEODORE J. FISHER, JR. ENGINEER No. 23704-E

COMMONWEALTH OF PENNSYLVANIA REGISTERED PROFESSIONAL MICHAEL R. FERKO ENGINEER No. 22180-E

COMMONWEALTH OF PENNSYLVANIA
DEPARTMENT OF ENVIRONMENTAL RESOURCES
OFFICE OF RESOURCES MANAGEMENT

PROJECT NO. OSM 40(2119)101.1

BACKFILLING STRIP PITS
LOOMIS COLLIERY
HANOVER TOWNSHIP
LUZERNE COUNTY, PENNSYLVANIA

SURFACE MAP

DRAWN BY	DATE	DRAWING NO.
D. G. D.	June 3, 1987	4 of 7
CHECKED BY	SCALE	
C. L.	1 in. = 50 ft.	

ALL DIMENSIONS AND EXISTING CONDITIONS SHALL BE CHECKED AND VERIFIED BY CONTRACTOR AT THE SITE.