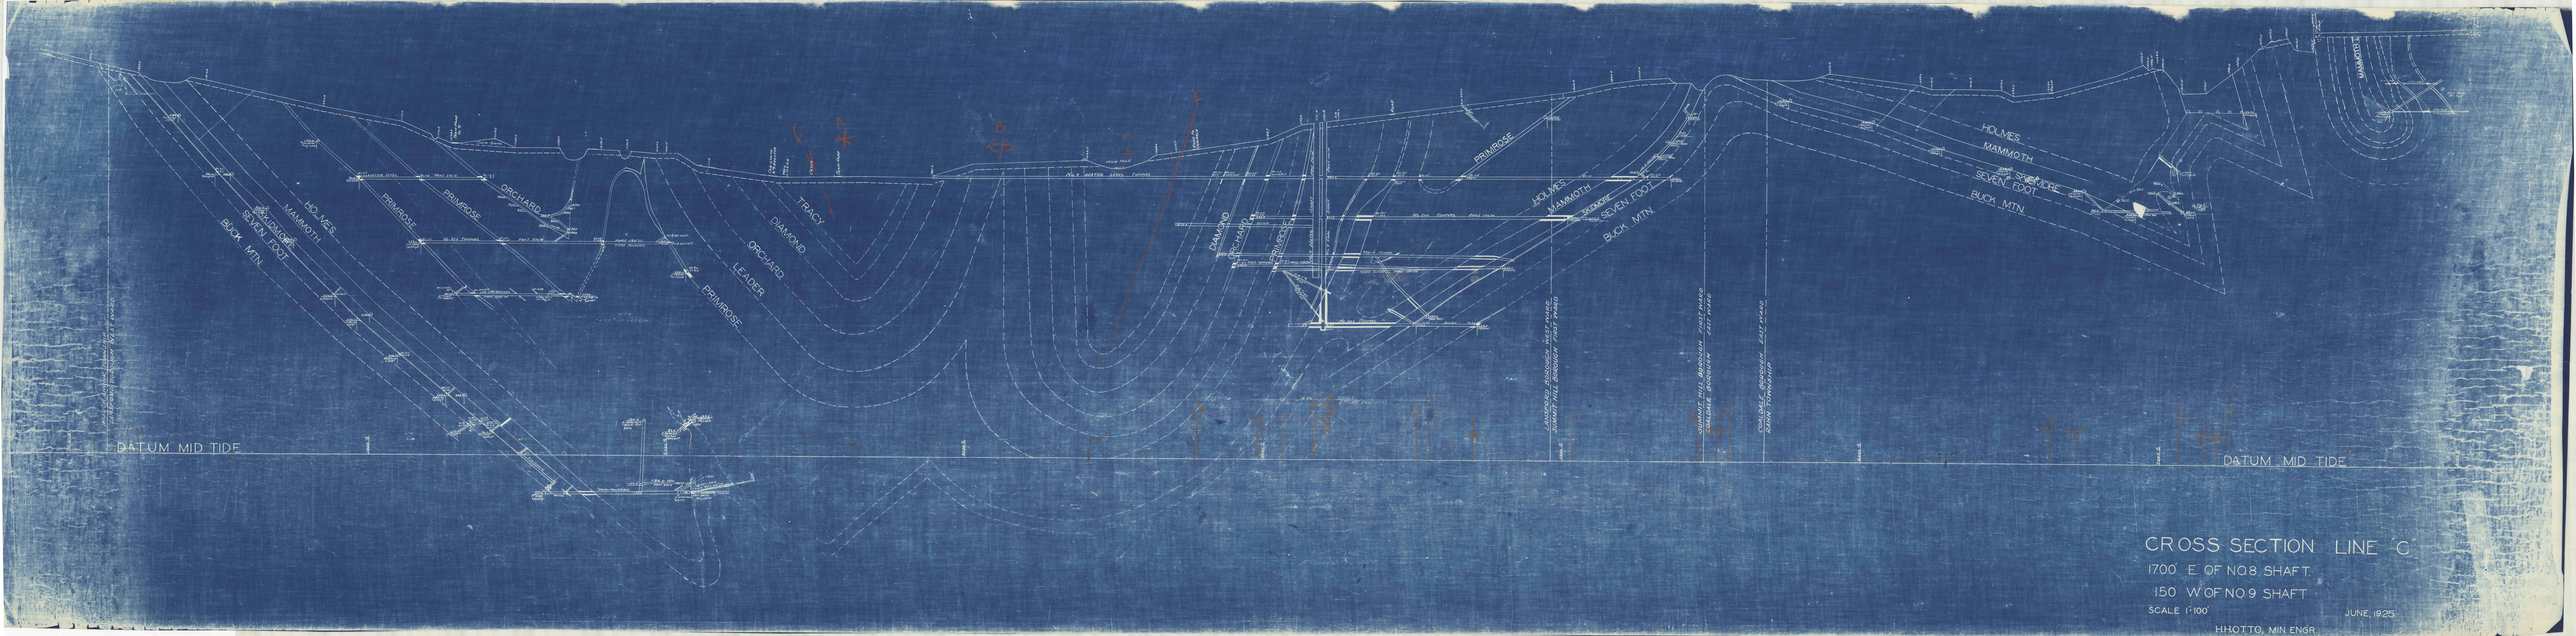
DATUM MID TIDE
DATUM MID TIDE
HOLMES
MAMMOTH
SEVEN FOOT
BUCK MTN
PRIMROSE
ORCHARD
TRACY
DIAMOND
LEADER
CROSS SECTION LINE C
1700' E. OF NO.8 SHAFT.
150' W. OF NO.9 SHAFT
SCALE 1"=100'
JUNE, 1925.
H.H.OTTO, MIN. ENGR.