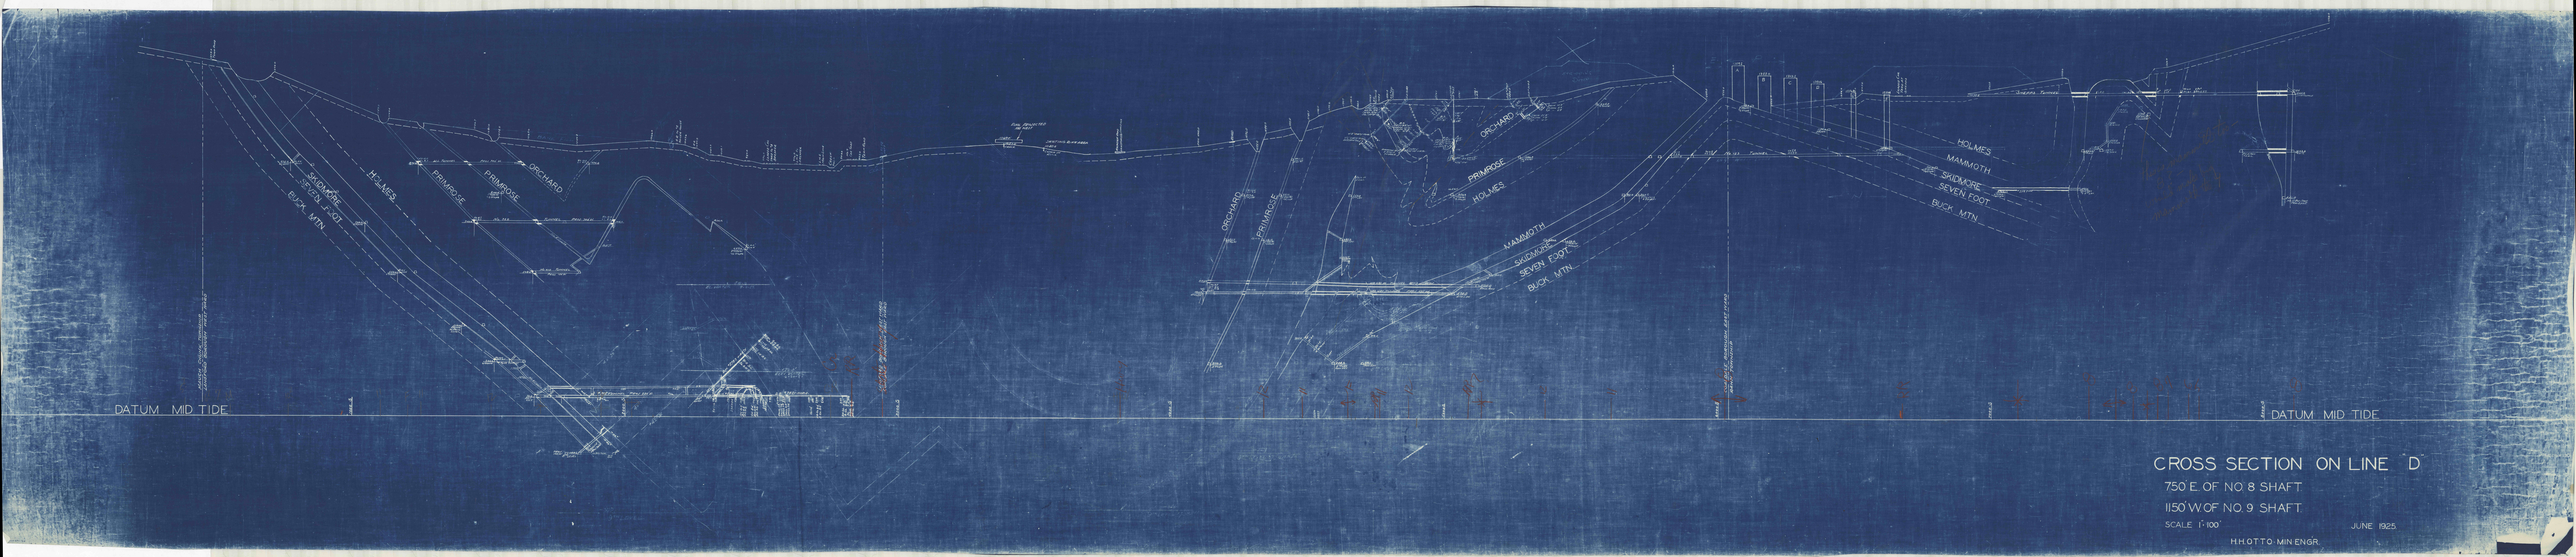

CROSS SECTION ON LINE "D"

750' E. OF NO. 8 SHAFT

1150' W. OF NO. 9 SHAFT

SCALE 1"=100' JUNE 1925

H.H. OTTO MIN. ENGR.