


B.M. #25 Elev. 1647.941
R.R. Spike in 6" Oak
220' Rt. 831+00 N.B.

DISTRICT	COUNTY	ROUTE	SECTION	SHEET
5-0	SCHUYLKILL	1005	S-5	30 of 51
FOSTER TOWNSHIP				

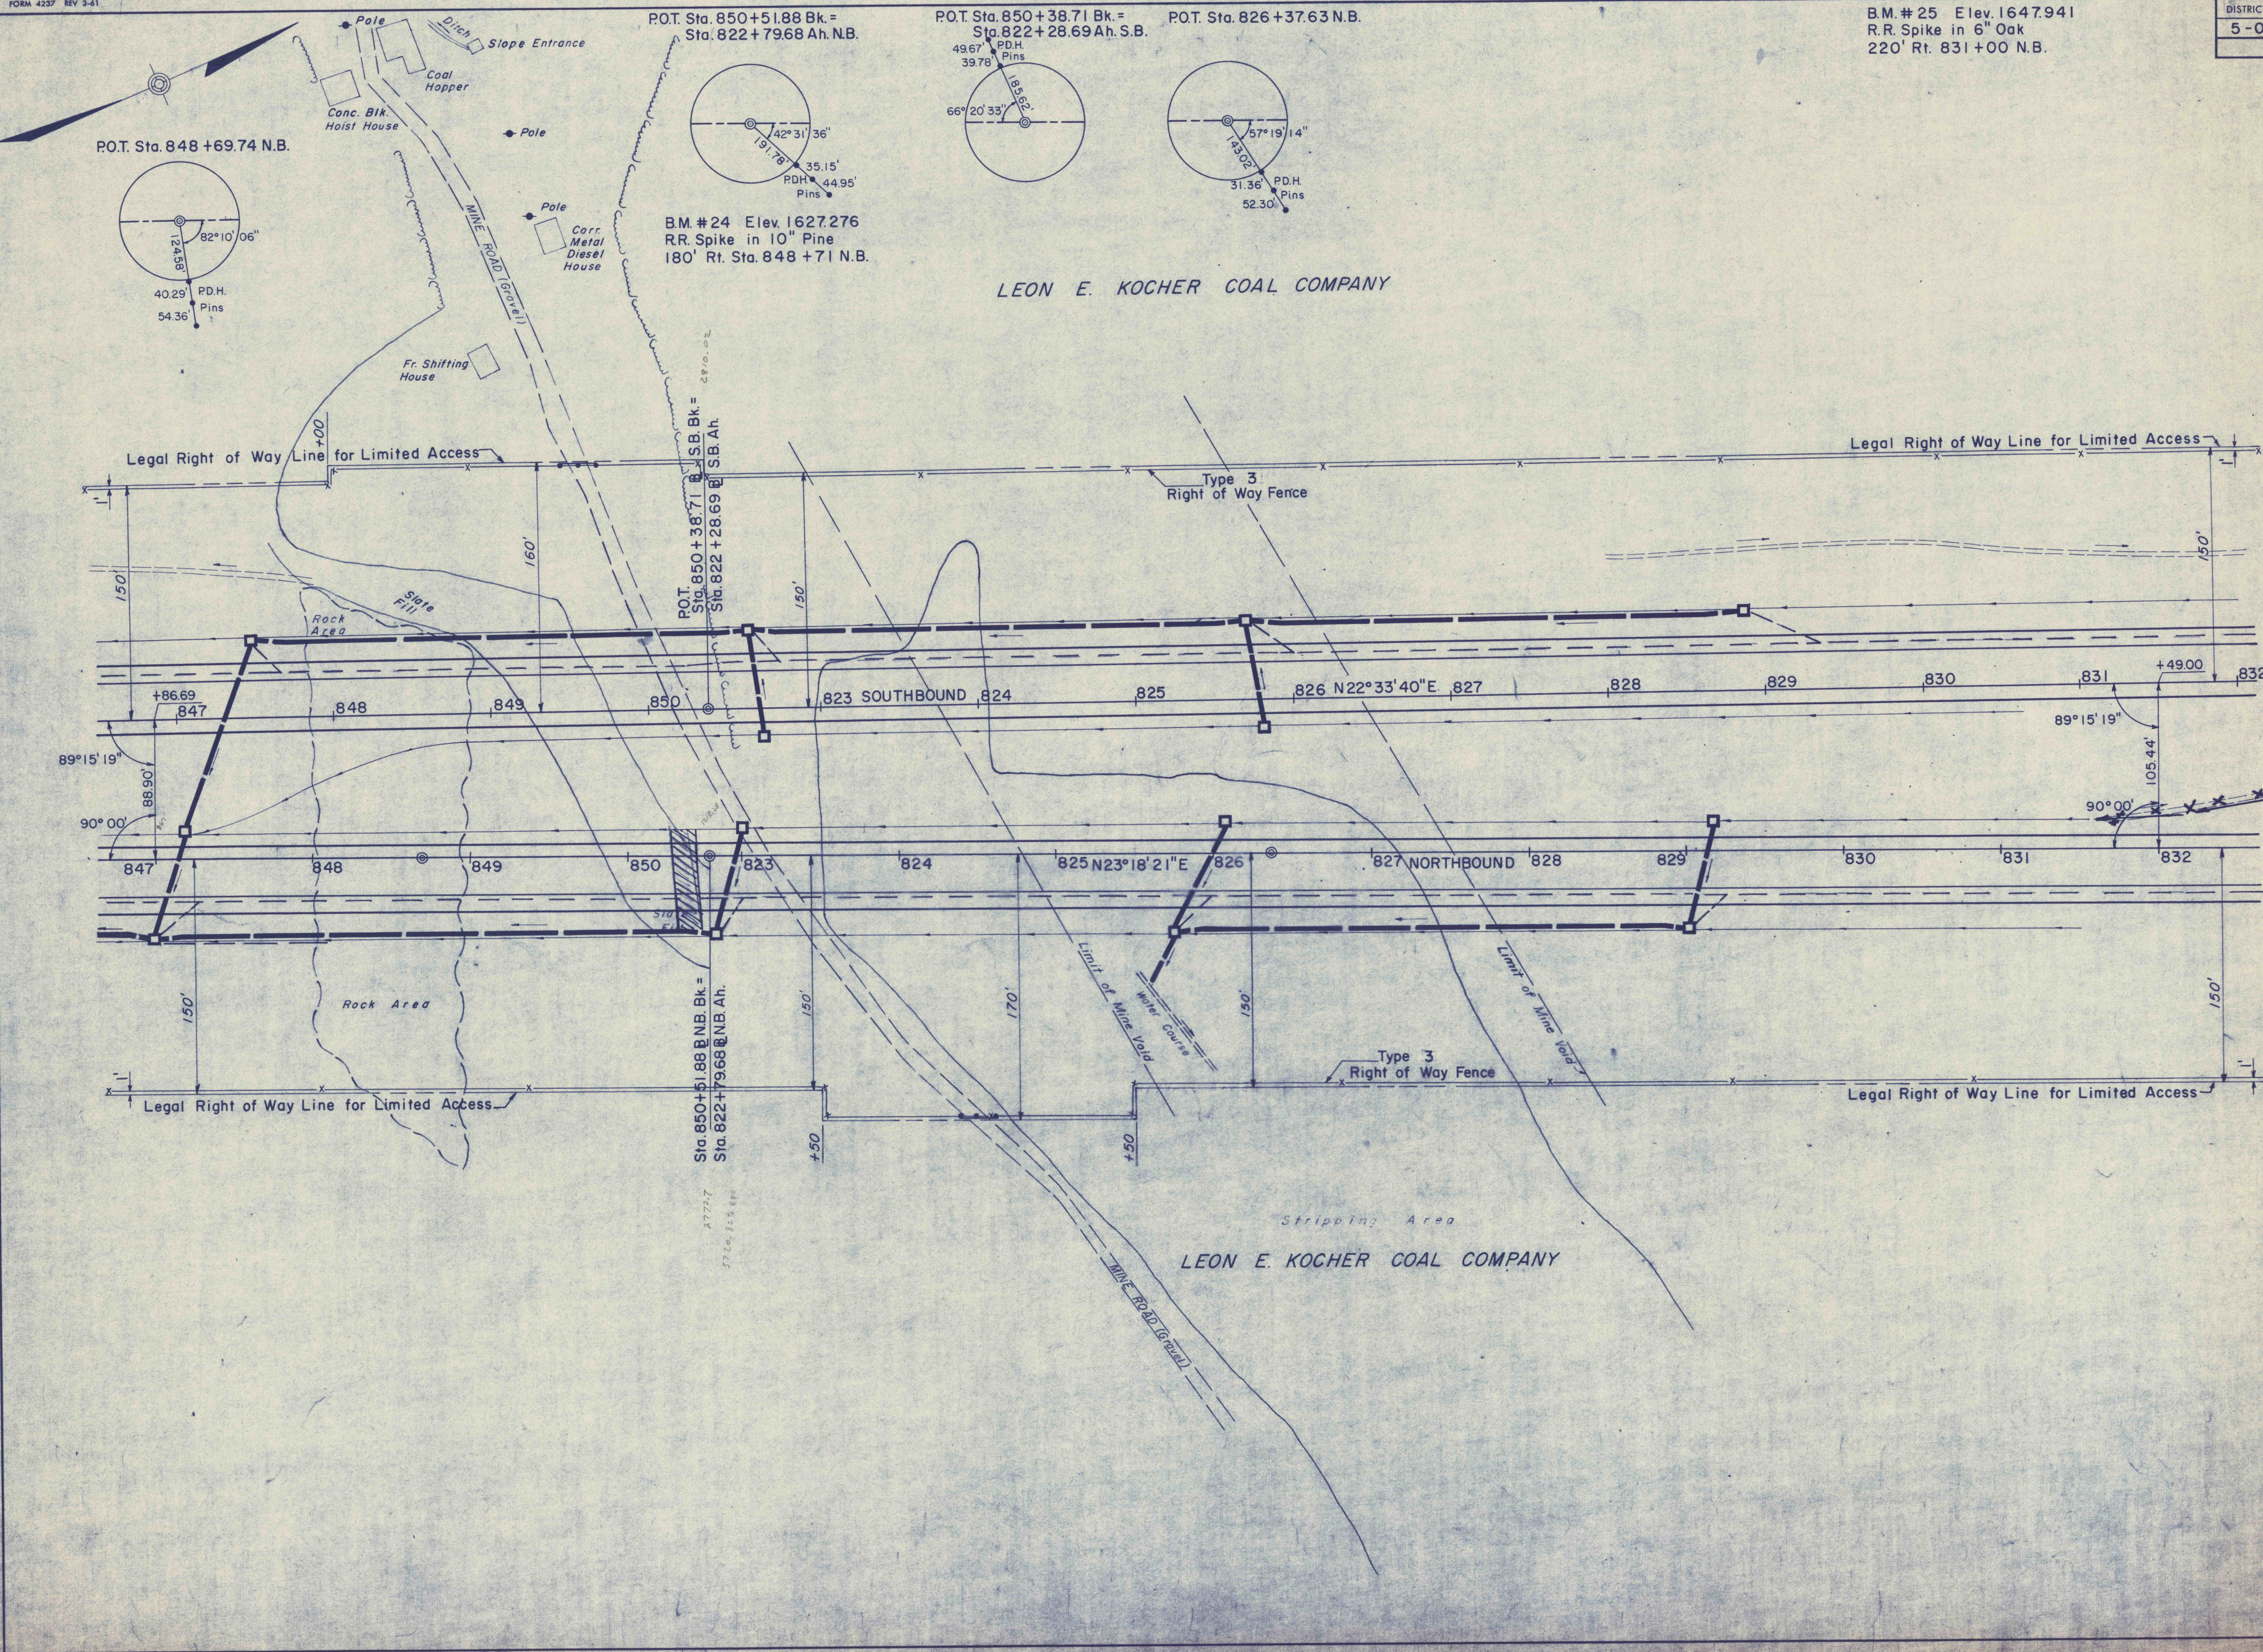

FINAL QUANTITIES	REQUIRED LIST
27	Sta. 847+15, N.B. 68 L.F. 24" Cl. III R.C.C. Pipe 1 Type H Inlet, Lt. 1 Type 4 Ft. Inlet, Lt. 28 C.Y. Granular Material 47 C.Y. Cl. 2 Exc. (Pipe & Cl. C Bedding) (For Details See Sheet No. 9)
57	Sta. 847+30, S.B. 126 L.F. 24" Cl. III R.C.C. Pipe 1 Type H Inlet, Lt. 52 C.Y. Granular Material 134 C.Y. Cl. 2 Exc. (Pipe & Cl. C Bedding) (For Details See Sheet No. 9)
352	Sta. 847+00 to Sta. 822+84 Ah. Rt. N.B. Storm Sewer 340 L.F. 18" Extra Str. P.C.C. Pipe or Extra Str. V.C. Pipe or C.M. Pipe 162 C.Y. Cl. 2 Exc. (Pipe & Cl. C Bedding)
162	Sta. 847+50 to Sta. 825+70 Ah. Lt. S.B. Storm Sewer 622 L.F. 24" Extra Str. P.C.C. Pipe or Extra Str. V.C. Pipe or C.M. Pipe 397 C.Y. Cl. 2 Exc. (Pipe & Cl. C Bedding)
619	Sta. 849+50 to Sta. 849+74, Lt. S.B. 24 L.F. Permanent Barricade, Type B
397	Sta. 822+60, S.B. 66 L.F. 18" Cl. III R.C.C. Pipe 2 Type H Inlets, Lt. & Rt. 21 C.Y. Granular Material 43 C.Y. Cl. 2 Exc. (Pipe & Cl. C Bedding) (For Details See Sheet No. 7)
43	Sta. 822+96, N.B. 66 L.F. 18" Cl. III R.C.C. Pipe 2 Type H Inlets, Lt. & Rt. 21 C.Y. Granular Material 46 C.Y. Cl. 2 Exc. (Pipe & Cl. C Bedding) (For Details See Sheet No. 9)
46	Sta. 824+32 to Sta. 824+56, Rt. N.B. 24 L.F. Permanent Barricade, Type B
158	Sta. 825+70 to Sta. 828+85, Lt. S.B. Storm Sewer 312 L.F. 18" Extra Str. P.C.C. Pipe or Extra Str. V.C. Pipe or C.M. Pipe 100 C.Y. Cl. 2 Exc. (Pipe & Cl. C Bedding)
319	Sta. 825+75 to Sta. 829+00, Rt. N.B. Storm Sewer 320 L.F. 18" Extra Str. P.C.C. Pipe or Extra Str. V.C. Pipe or C.M. Pipe 127 C.Y. Cl. 2 Exc. (Pipe & Cl. C Bedding)
127	Sta. 825+78, S.B. 66 L.F. 18" Cl. III R.C.C. Pipe 2 Type H Inlets, Lt. & Rt. 21 C.Y. Granular Material 53 C.Y. Cl. 2 Exc. (Pipe & Cl. C Bedding) (For Details See Sheet No. 9)
53	Sta. 826+00, N.B. 74 L.F. 18" Cl. III R.C.C. Pipe 2 Type H Inlets, Lt. & Rt. 24 C.Y. Granular Material 36 C.Y. Cl. 2 Exc. (Pipe & Cl. C Bedding)
25	Sta. 826+00 to Sta. 834+70, Lt. S.B. Storm Sewer 36 L.F. 18" Extra Str. P.C.C. Pipe or Extra Str. V.C. Pipe or C.M. Pipe 18 C.Y. Cl. 2 Exc. (Pipe & Cl. C Bedding)
67	Sta. 829+10, N.B. 62 L.F. 18" Cl. III R.C.C. Pipe 2 Type H Inlets, Lt. & Rt. 20 C.Y. Granular Material 41 C.Y. Cl. 2 Exc. (Pipe & Cl. C Bedding)
22	Sta. 831+63 to Sta. 835+50, Lt. N.B. 76 C.Y. Cl. 2 Exc. (Parallel Ditch, 18" Bottom)
41	Sta. 831+63 to Sta. 835+50, Lt. N.B. 76 C.Y. Cl. 2 Exc. (Parallel Ditch, 18" Bottom)

Required List Continued on Sheet No. 31
Alignment Book Number 16997 S.B., 16765 & 16998 N.B.
Topo Book Number 16792 & 16978
X-Sections Book Number 16775 & 16797