


B.M. #28 Elev. 1636.659
R.R. Spike in 11" Oak
210' Rt. Sta. 861+00 N.B.

P.O.T. Sta. 866+58.16 N.B.

DISTRICT	COUNTY	ROUTE	SECTION	SHEET
5-0	SCHUYLKILL	1005	S-5	36 of 51

FOSTER TOWNSHIP

FINAL QUANTITIES	REQUIRED LIST
700	Sta. 855+00 to Sta. 865+00, Lt. S.B. 152 L.F. Bit Conc. Curb (For Details See Sheet No. 9)
700	Sta. 860+00 to Sta. 871+00, Rt. N.B. 152 L.F. Bit Conc. Curb (For Details See Sheet No. 9)
70	Sta. 863+00, Lt. S.B. 64 L.F. 12" A.C.C.M. Pipe (Slope) 1 Slope Pipe Fitting, Type A 14 C.Y. Cl. 2 Exc. (Pipe & Cl. C Bedding) 1 C.Y. Cl. 2 Exc. (Outlet Ditch)
235	Sta. 864+00, Rt. N.B. 54 L.F. 12" A.C.C.M. Pipe (Slope) 1 Slope Pipe Fitting, Type A 12 C.Y. Cl. 2 Exc. (Pipe & Cl. C Bedding) 1 C.Y. Cl. 2 Exc. (Outlet Ditch)
5	Sta. 864+48, N.B. 174 L.F. 24" Cl. III R.C.C. Pipe 07 C.Y. Cl. B Conc. (Type D Edwl., Lt.) 71 C.Y. Granular Material 242 C.Y. Cl. 2 Exc. (Pipe, Edwl. & Cl. C Bedding) 2 C.Y. Cl. 2 Exc. (Outlet Ditch, Rt.) (Max. Fill Over Pipe 32')
195	Sta. 864+60 to Sta. 867+50, Rt. N.B. 139 C.Y. Cl. 2 Exc. (Parallel Ditch, 24" Bottom)
307	Sta. 866+20 to Sta. 875+48, Lt. S.B. 139 C.Y. Cl. 2 Exc. (Parallel Ditch, 18" Bottom) 139 C.Y. Cl. 2 Exc. (Outlet Ditch)
960	Sta. 866+50, Lt. S.B. 70 L.F. 12" A.C.C.M. Pipe (Slope) 1 Slope Pipe Fitting, Type A 15 C.Y. Cl. 2 Exc. (Pipe & Cl. C Bedding) 1 C.Y. Cl. 2 Exc. (Outlet Ditch)
353	Sta. 867+25, N.B. 352 L.F. 72" A.C.C.M. Pipe, Fully Coated, 8 Gage, Elongated 121 C.Y. Cl. B Conc. (Type DW Edwls., Lt. & Rt.) 345 C.Y. Granular Material 1078 C.Y. Cl. 2 Exc. (Pipe, Edwls. & Cl. C Bedding) 90 C.Y. Cl. 1 Exc. (Inlet & Outlet Ditches, 8' Bottom) (Max. Fill Over Pipe 31')
12.6	Sta. 868+00, Rt. N.B. 84 L.F. 12" A.C.C.M. Pipe (Slope) 1 Slope Pipe Fitting, Type A 19 C.Y. Cl. 2 Exc. (Pipe & Cl. C Bedding) 1 C.Y. Cl. 2 Exc. (Outlet Ditch)
347	Sta. 868+25 to Sta. 869+10, N.B. Roadway Embankment To Be Rock, Available From This Project, To Elev. 1600.0 (See X-Sections & X-Hatched Area On Plan) 871+00
1182	Sta. 868+50 to Sta. 869+10, Lt. N.B. 152 C.Y. Cl. 2 Exc. (Parallel Ditch, 18" Bottom)
94	Sta. 868+80, N.B. 188 L.F. 24" Cl. III R.C.C. Pipe 07 C.Y. Cl. B Conc. (Type D Edwl., Lt.) 77 C.Y. Granular Material 262 C.Y. Cl. 2 Exc. (Pipe, Edwl. & Cl. C Bedding) (Max. Fill Over Pipe 32')
59	Sta. 869+00, Lt. S.B. 52 L.F. 12" A.C.C.M. Pipe (Slope) 1 Slope Pipe Fitting, Type A 11 C.Y. Cl. 2 Exc. (Pipe & Cl. C Bedding) 1 C.Y. Cl. 2 Exc. (Outlet Ditch)
184	Sta. 864+00 to Sta. 865+00, Lt. N.B. 4 C.Y. Cl. 2 Exc. (Parallel Ditch, 24" Bottom)

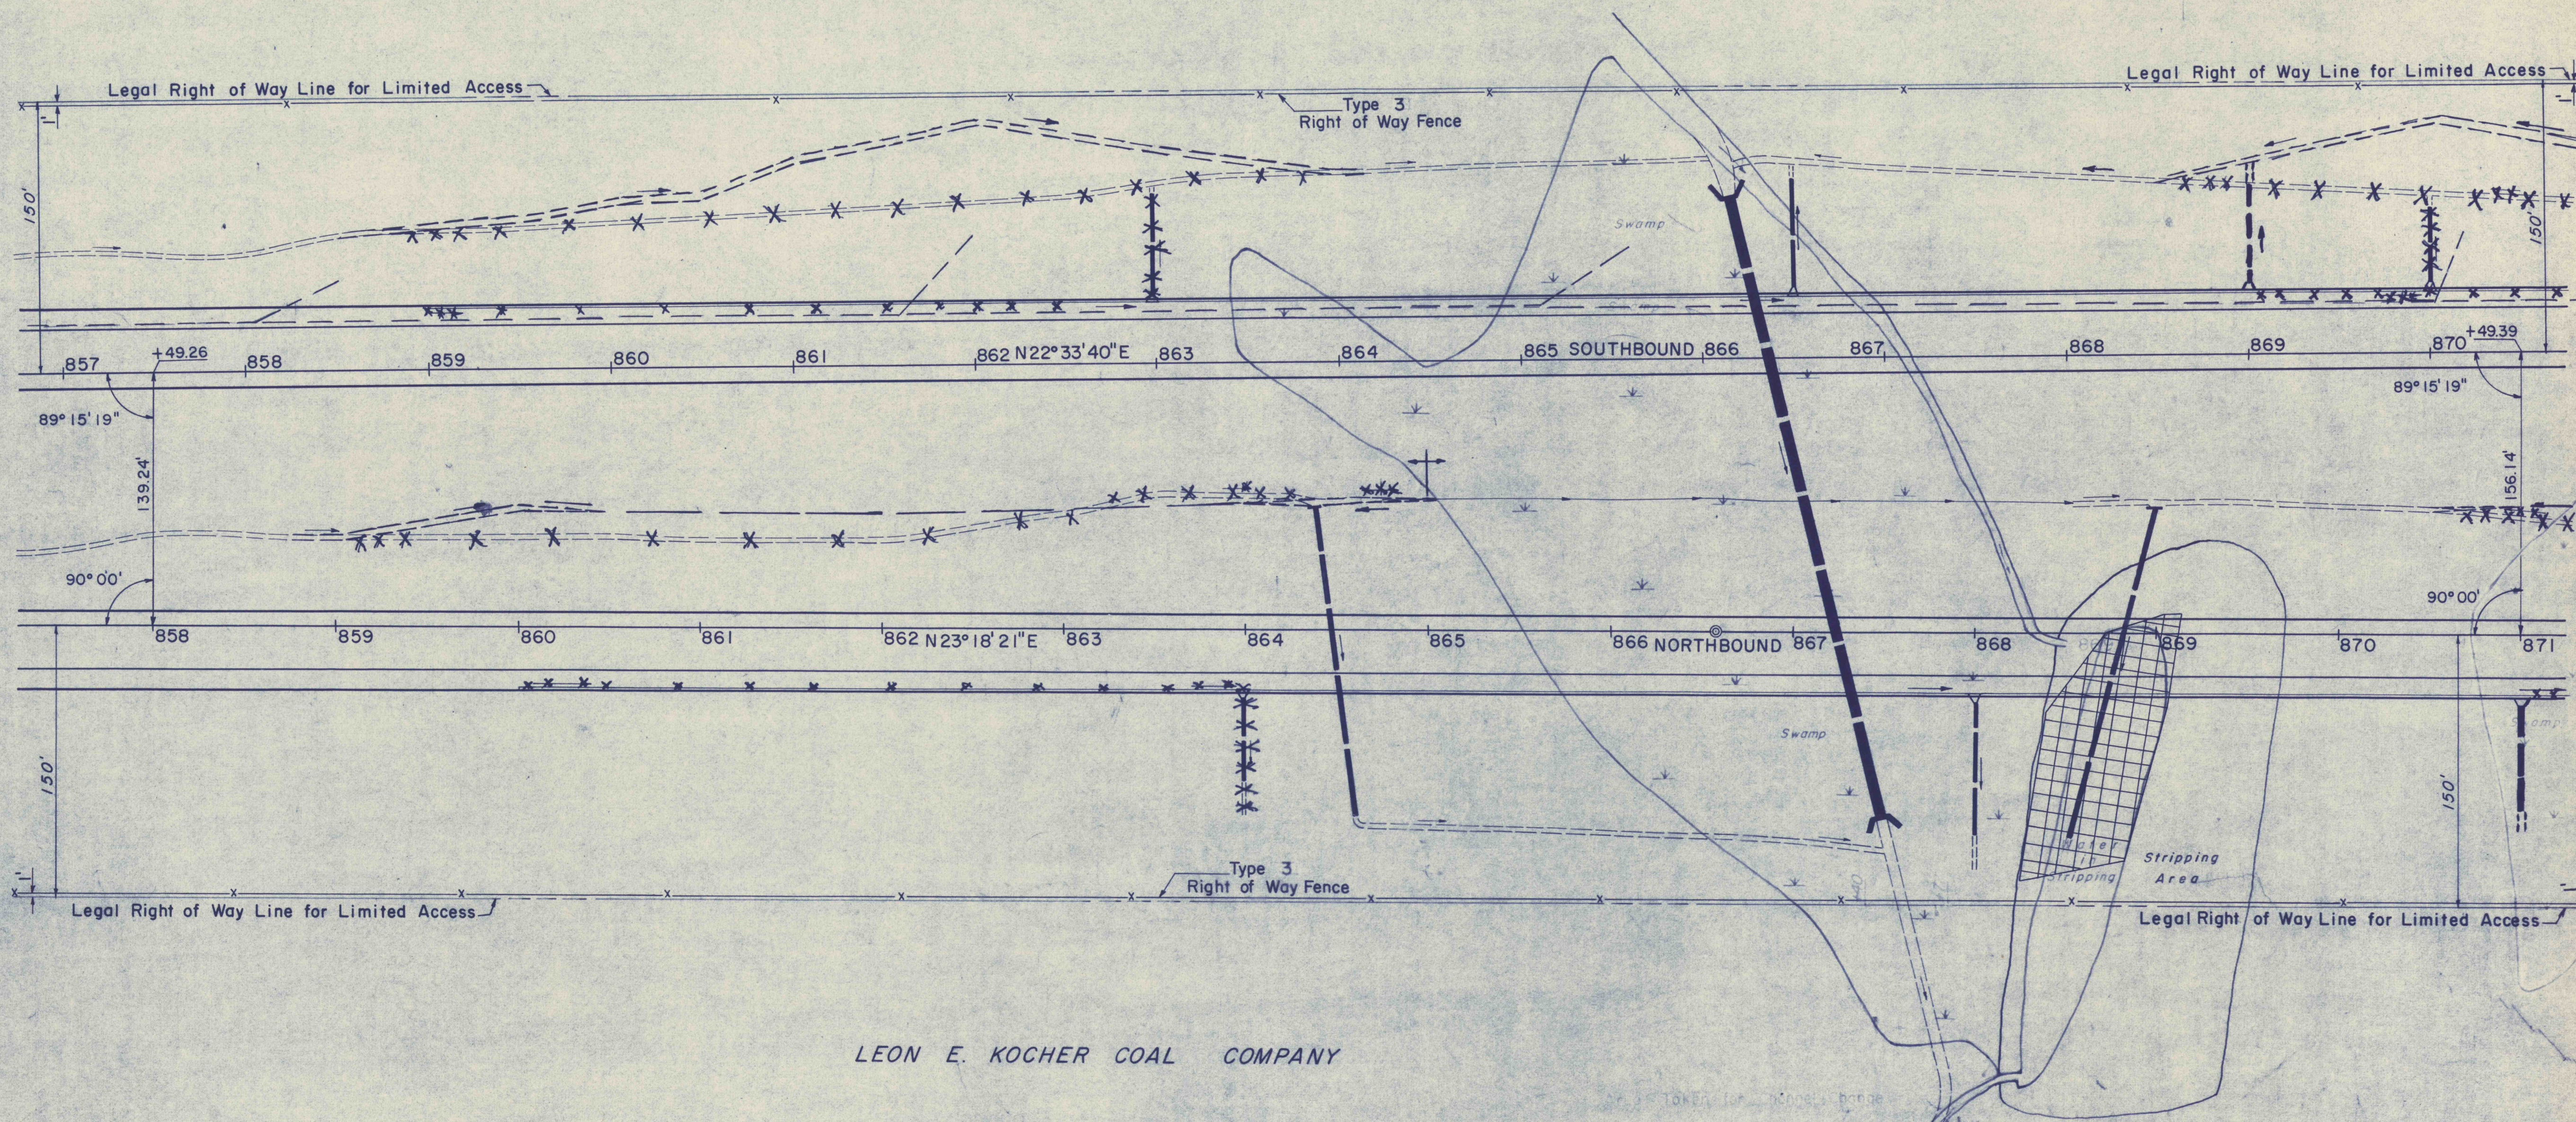

DATUM

Alignment Book Number 16997 S.B., 16765 & 16998 N.B.

Topo Book Number 16792

X-Sections Book Number 16776

TRACED BY
FINAL BY