




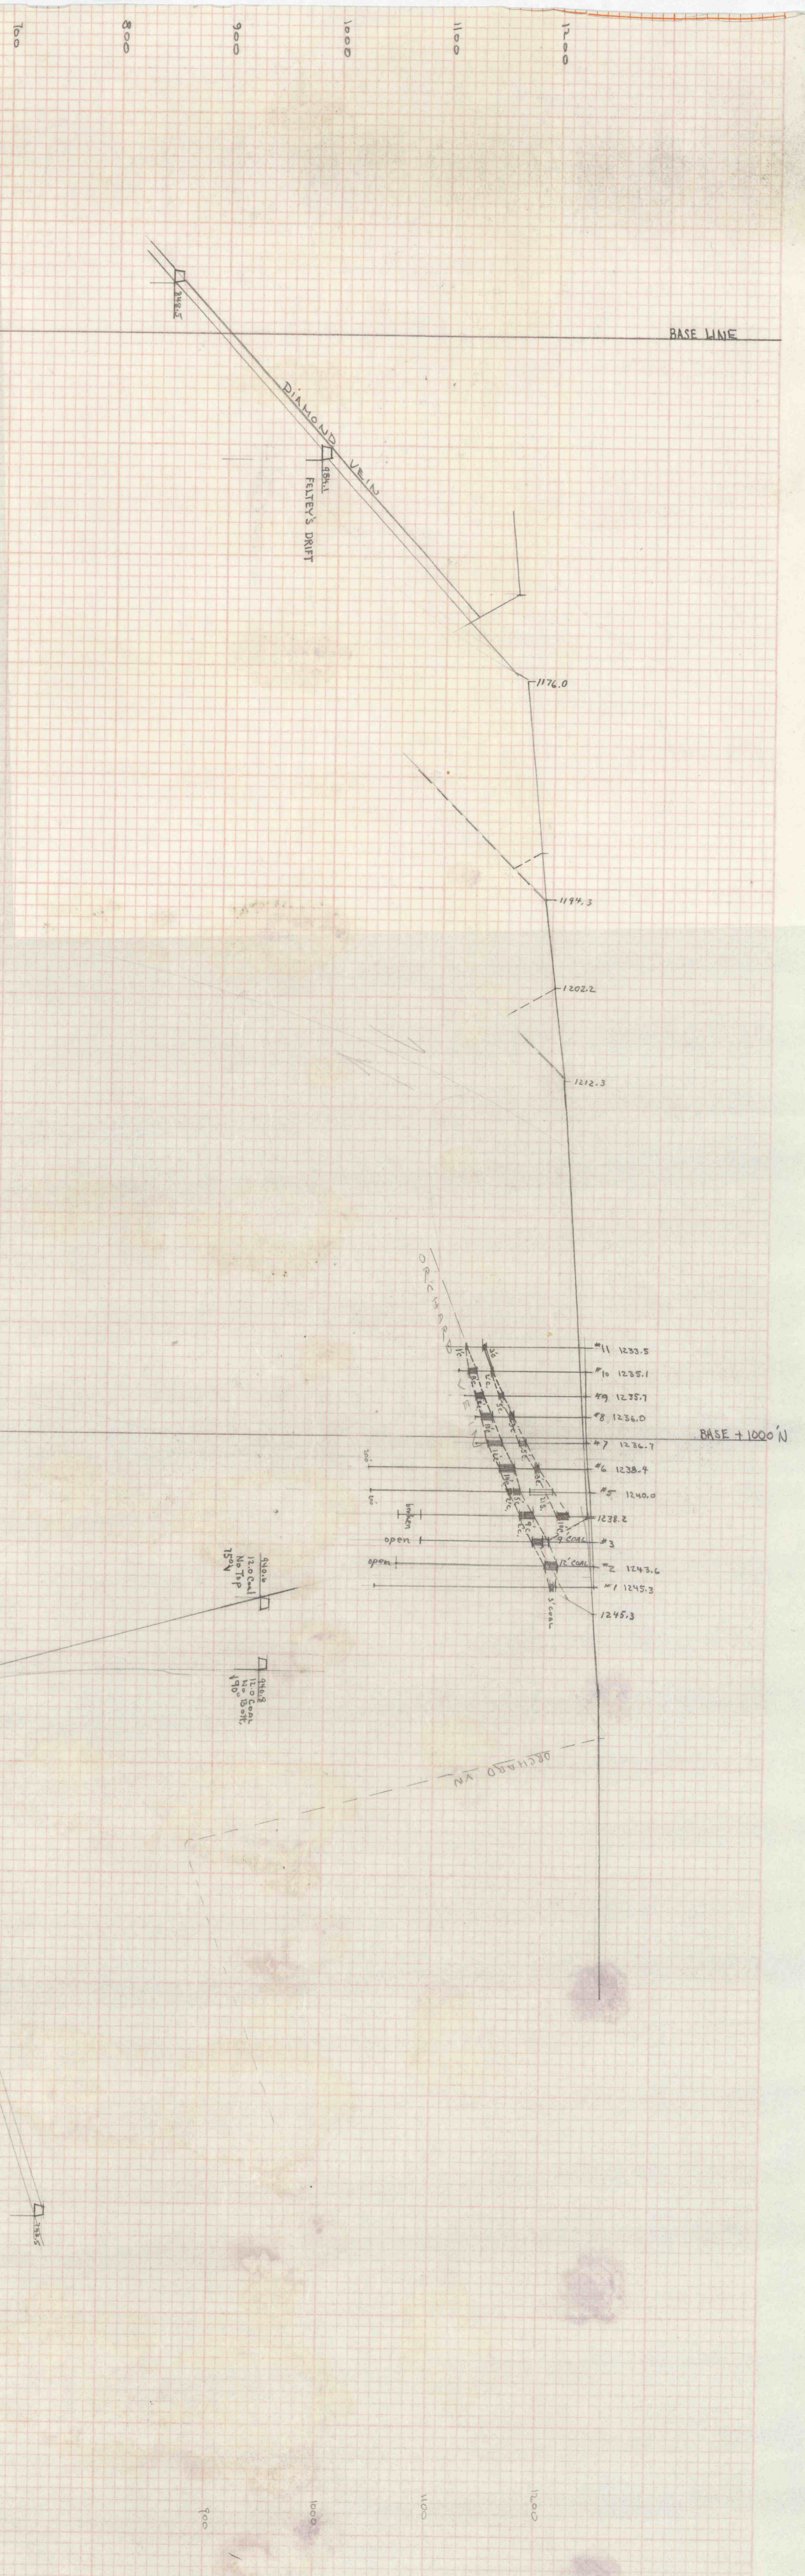

JEWEL RIDGE
SECTION 14+00 E
LOOKING WEST

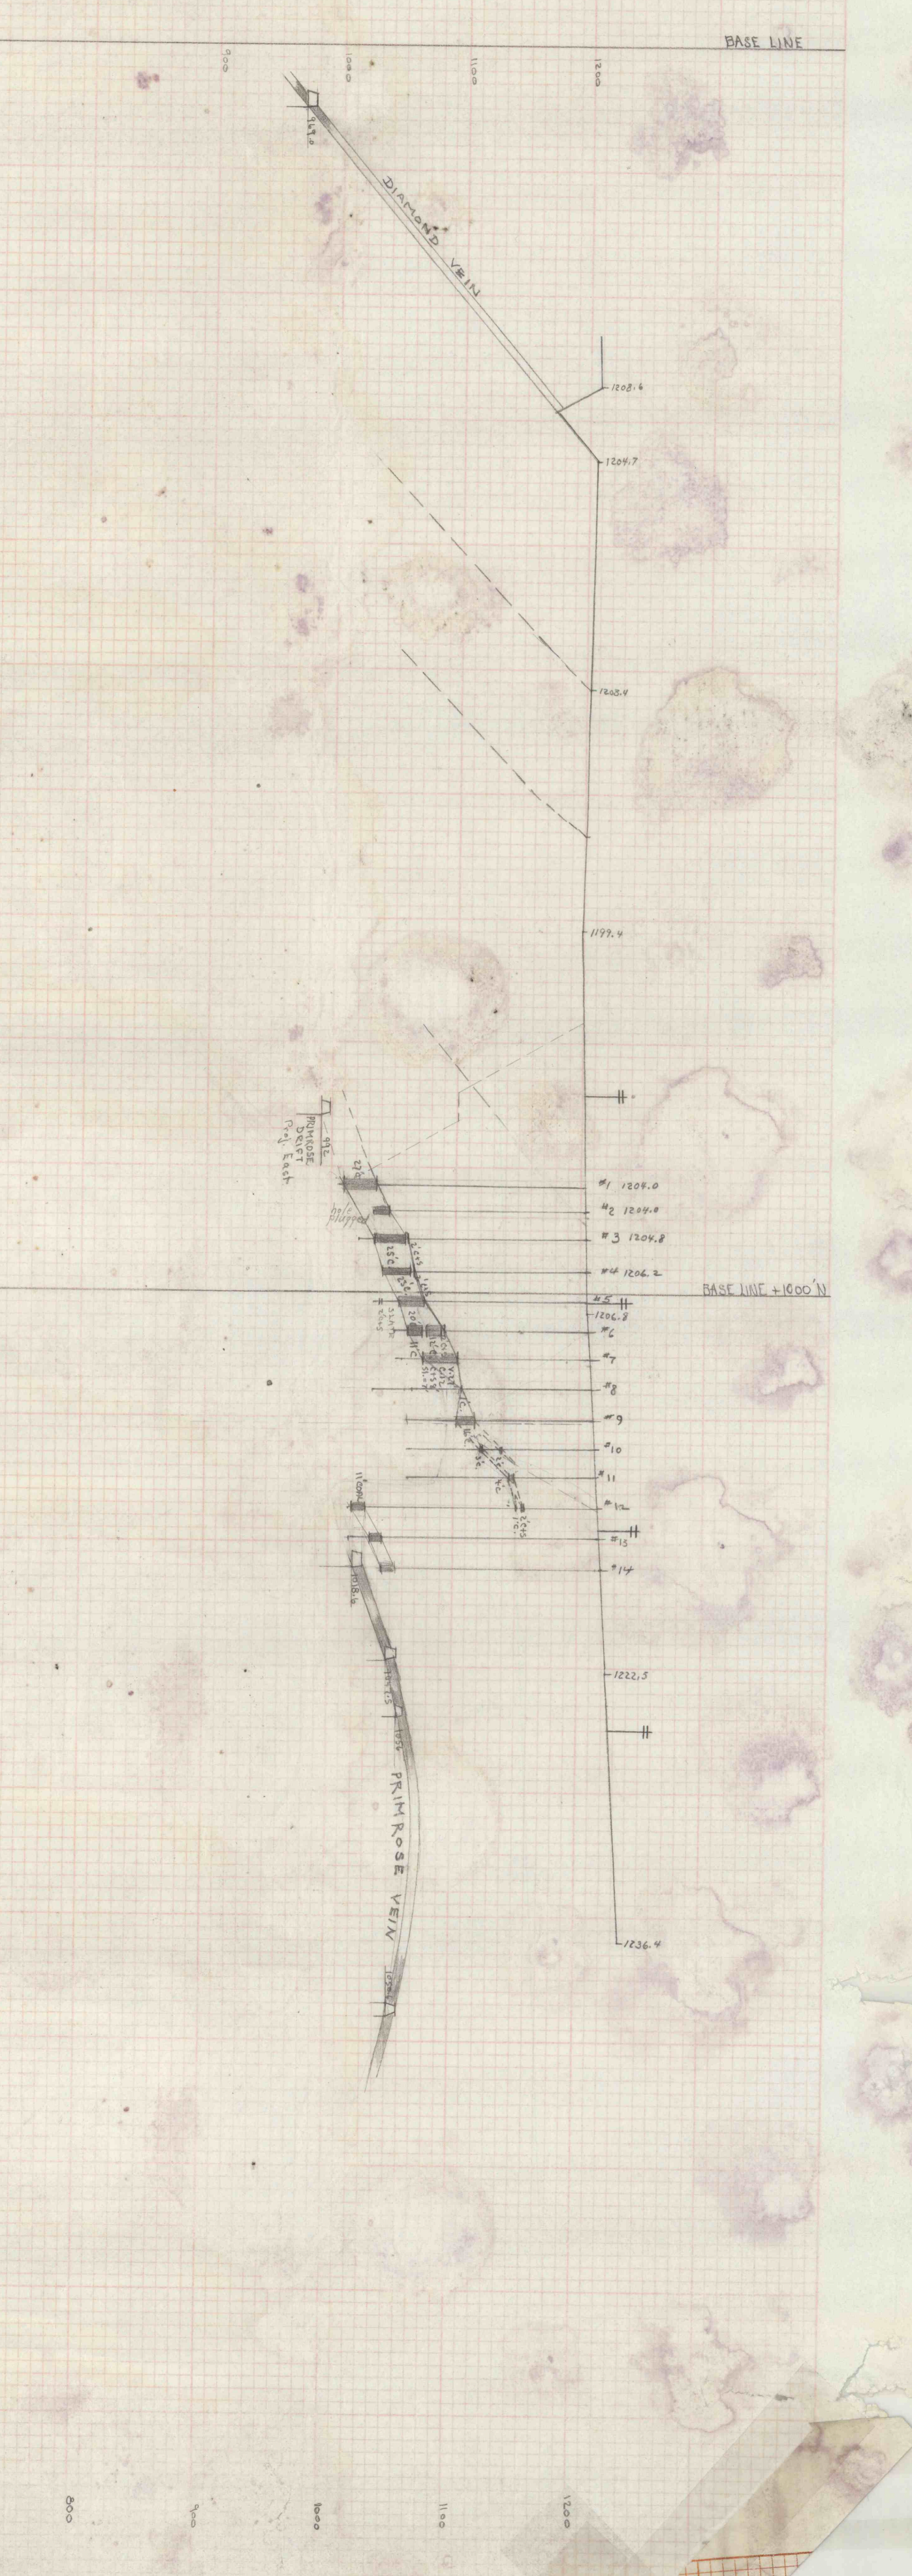

JEWEL RIDGE
SECTION 4+00 E
LOOKING WEST

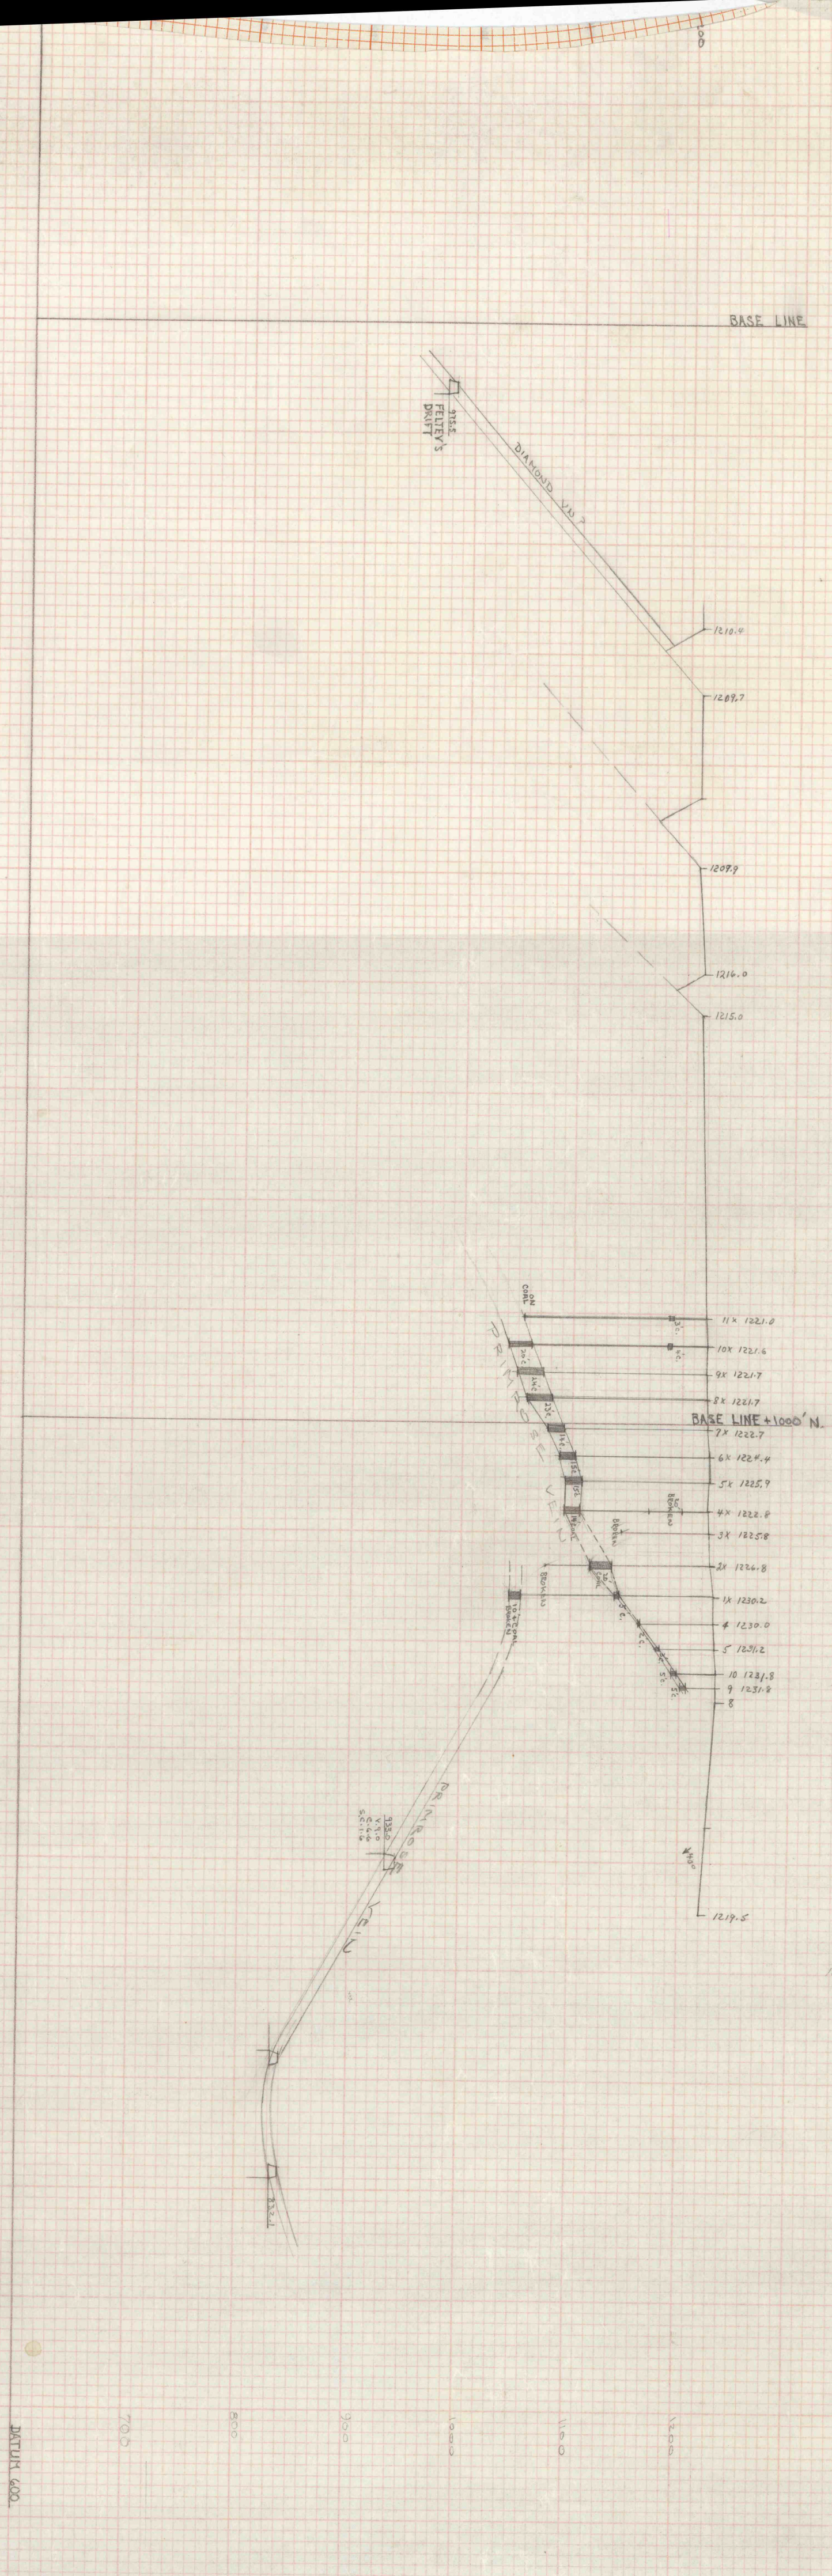

JEWEL RIDGE
SECTION 8+00 E
LOOKING WEST

