


B-B

B-13

Lines of units, faults, etc should not cross Q₁ +
deposits on cross sections.

stream +
bone

names of major stream^s
ridges included above
the surface
major folds also

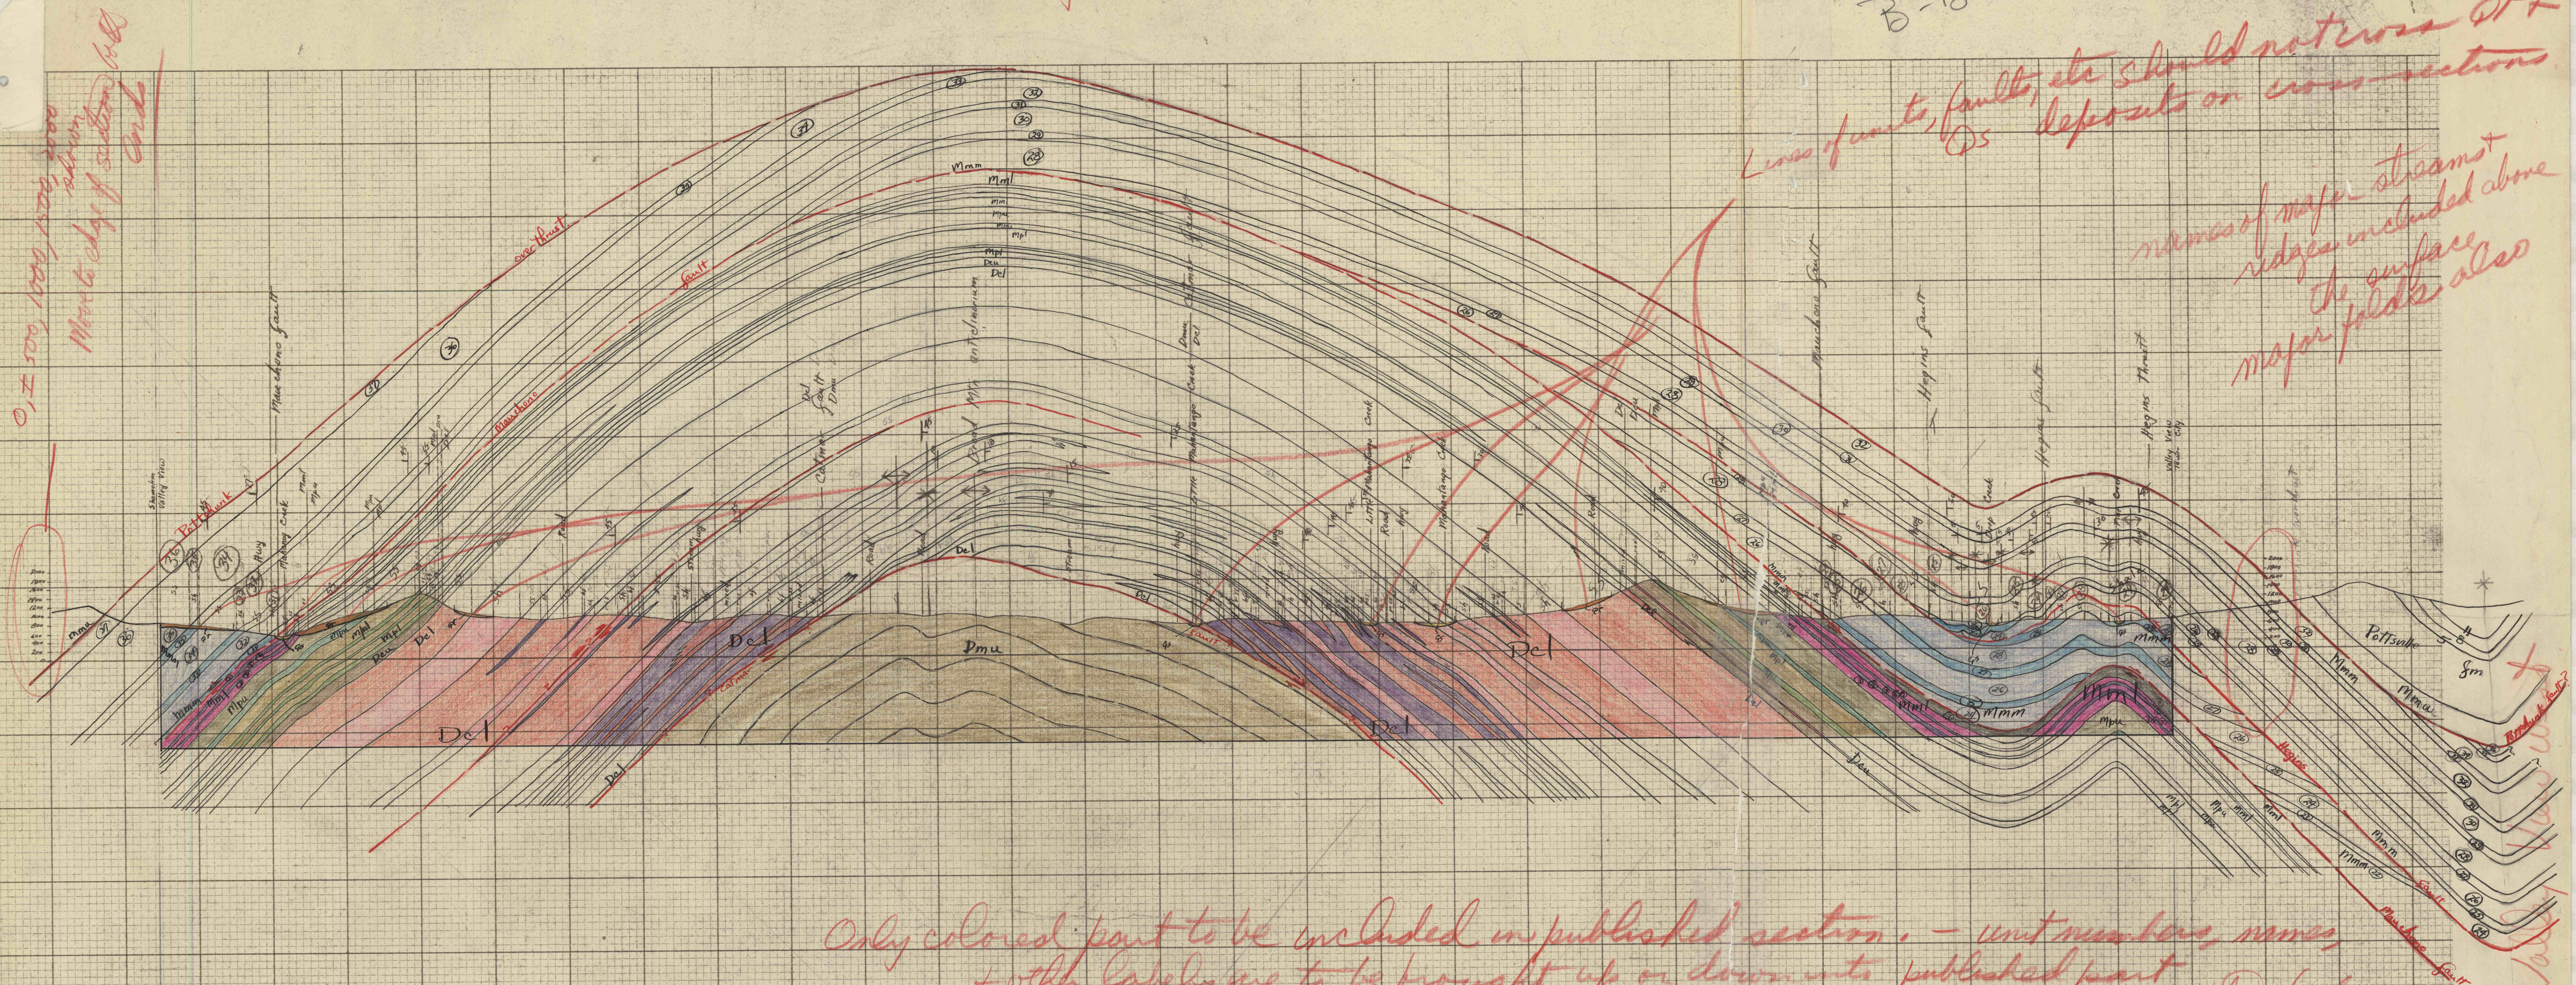

Only colored part to be included in published section. - unit numbers, names, + other labels are to be brought up or down into published part. Outcrops to be checked with map, + lines + unit thicknesses, etc to be smoothed out from my rough freehand drawing.

Scale 1:20,000
final scale will probably be
1:36,000 or 1:48,000

map scale now 1:20,000, will be published at 1:24,000

B-12

(Valley View west)

B-B