



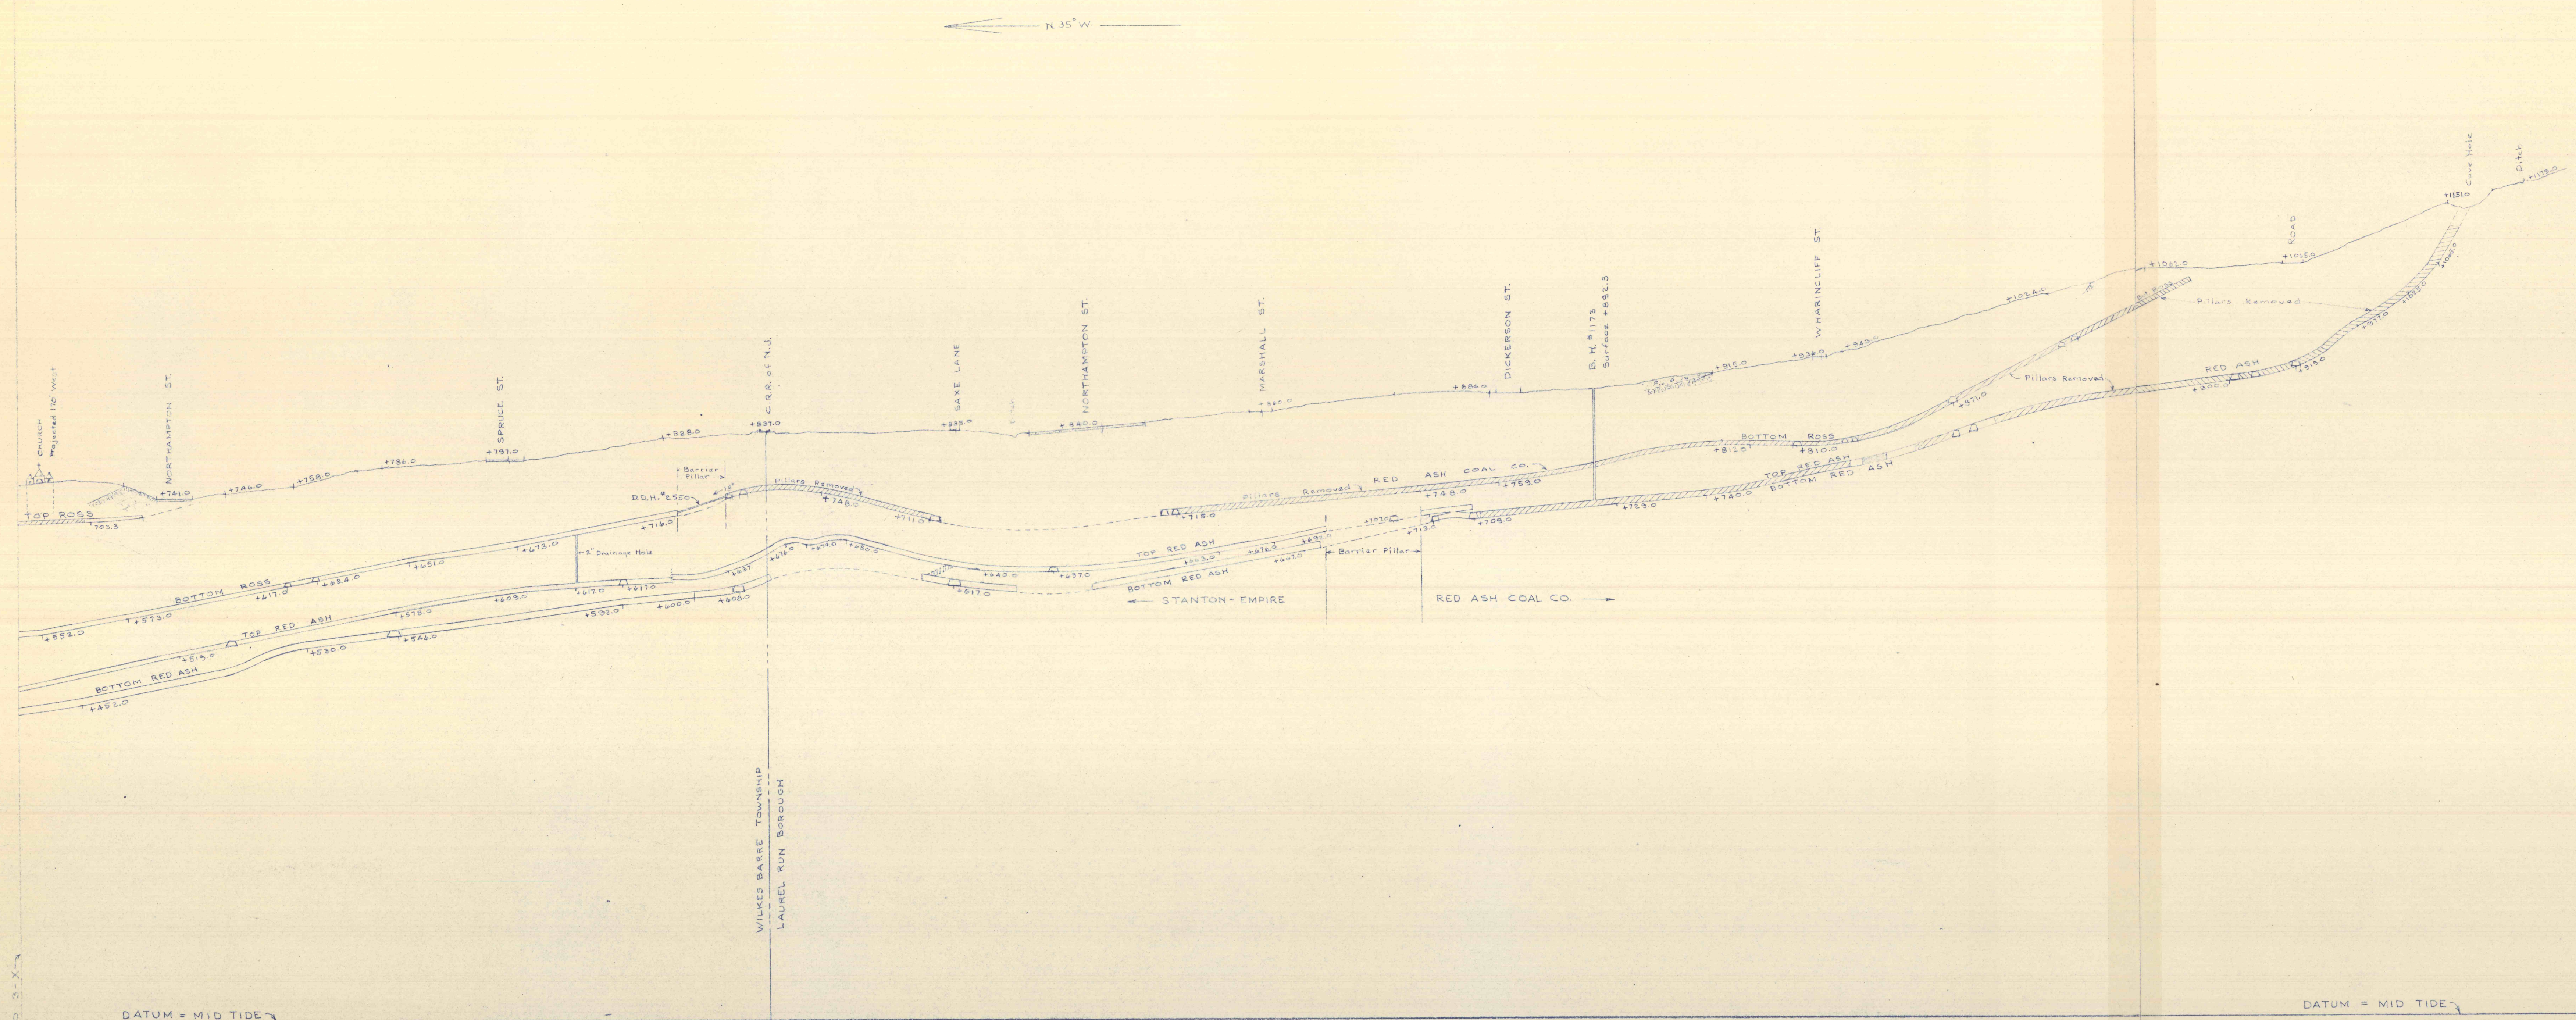

CROSS SECTION FOLIO 3-XX

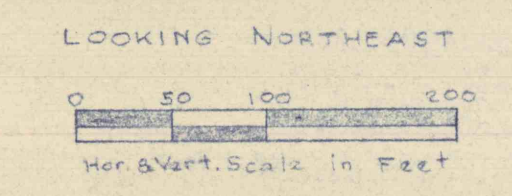

N 35° W

CROSS SECTION FOLIO 3-XXX

