



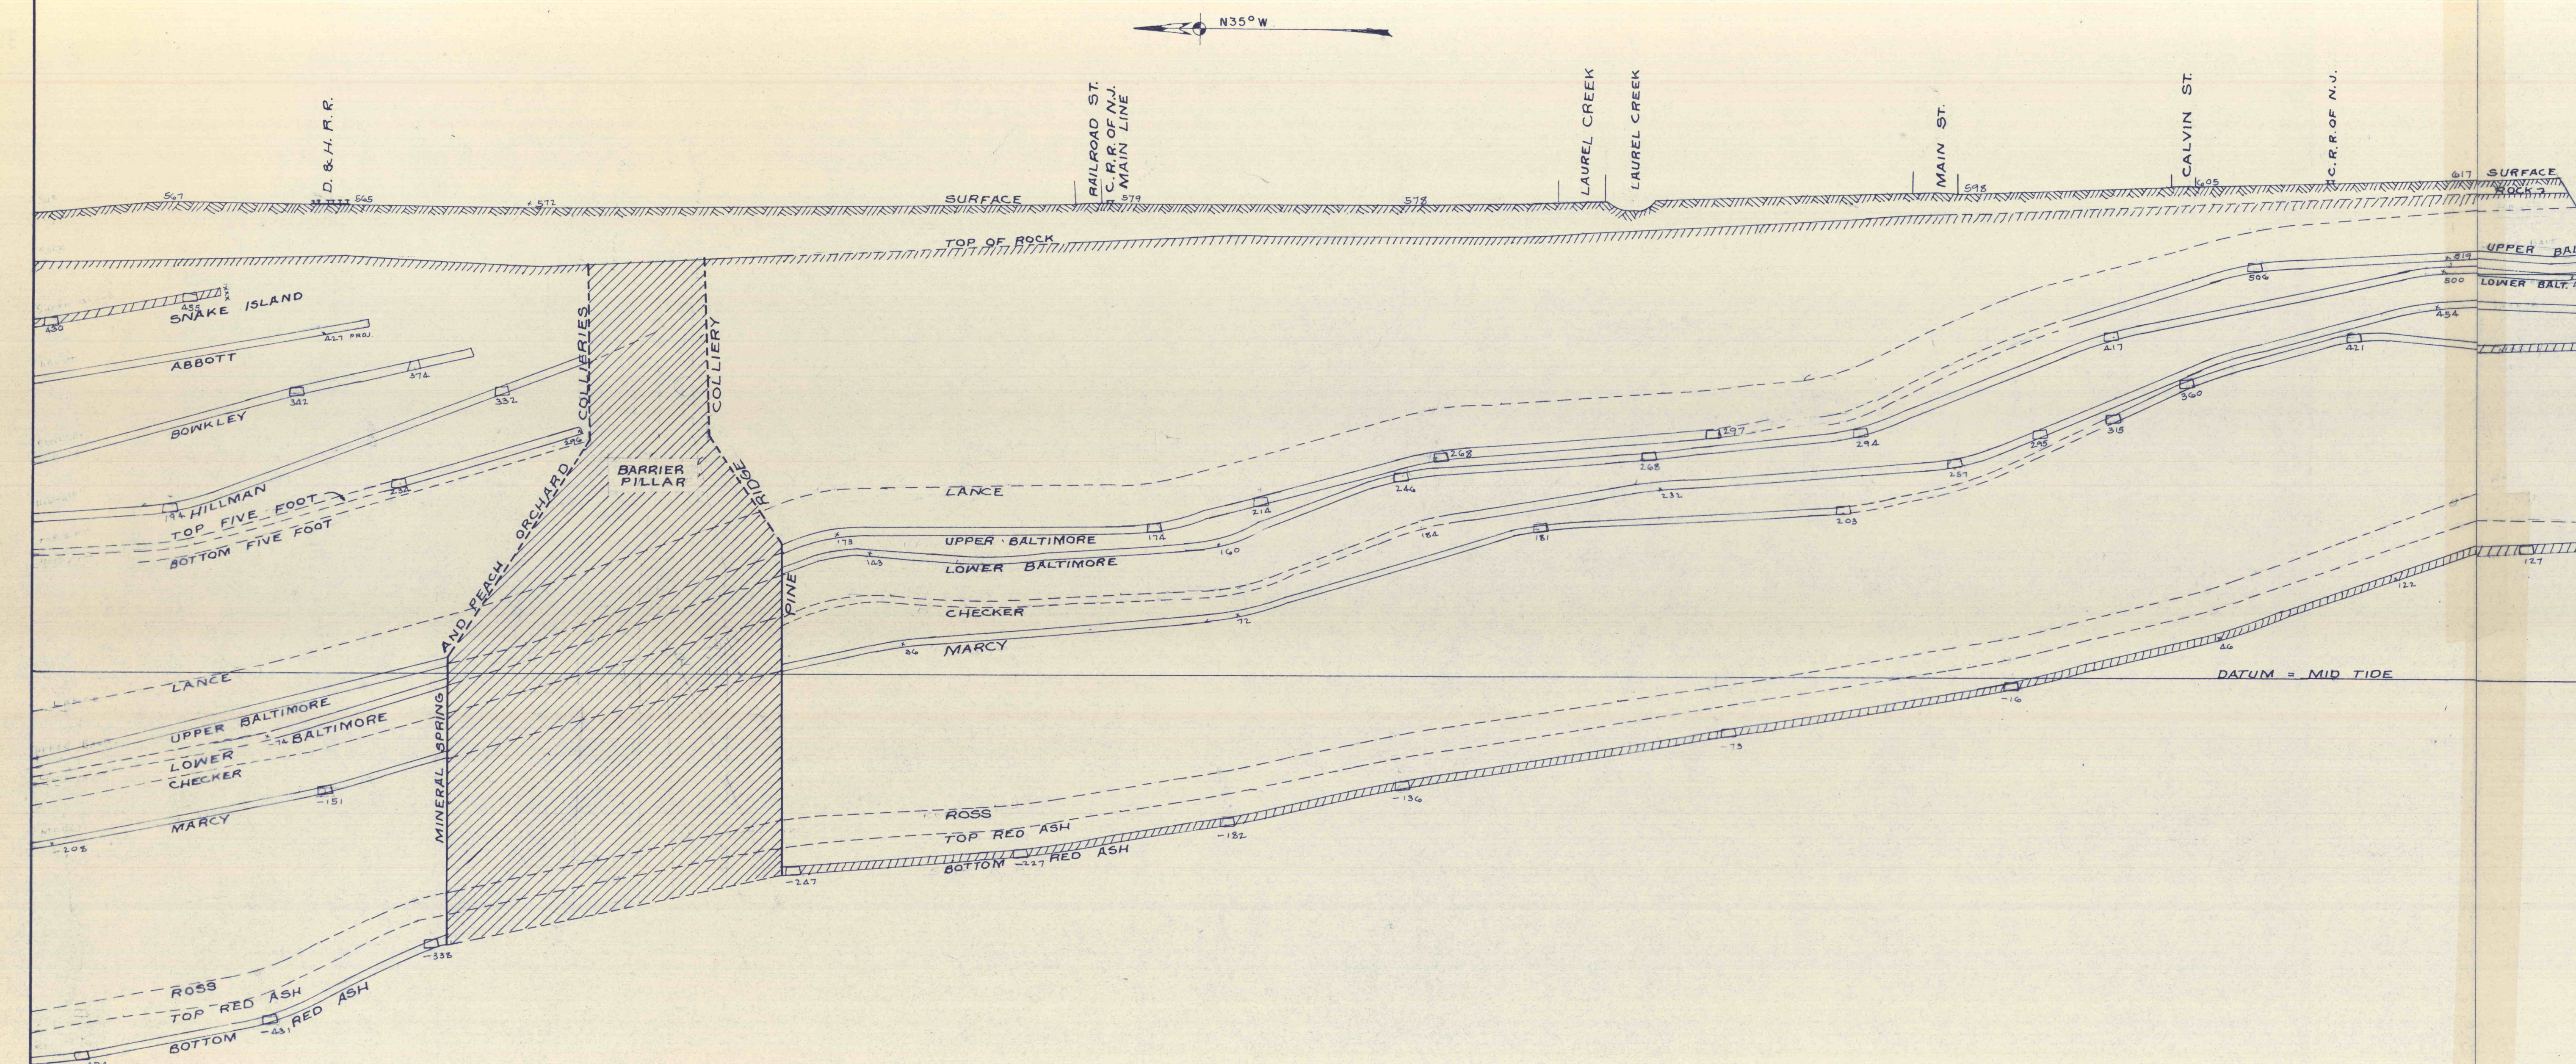


CROSS SECTION FOLIO 4 T

LOOKING UPSTREAM

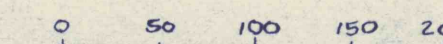


HORIZONTAL & VERTICAL SCALE IN FEET

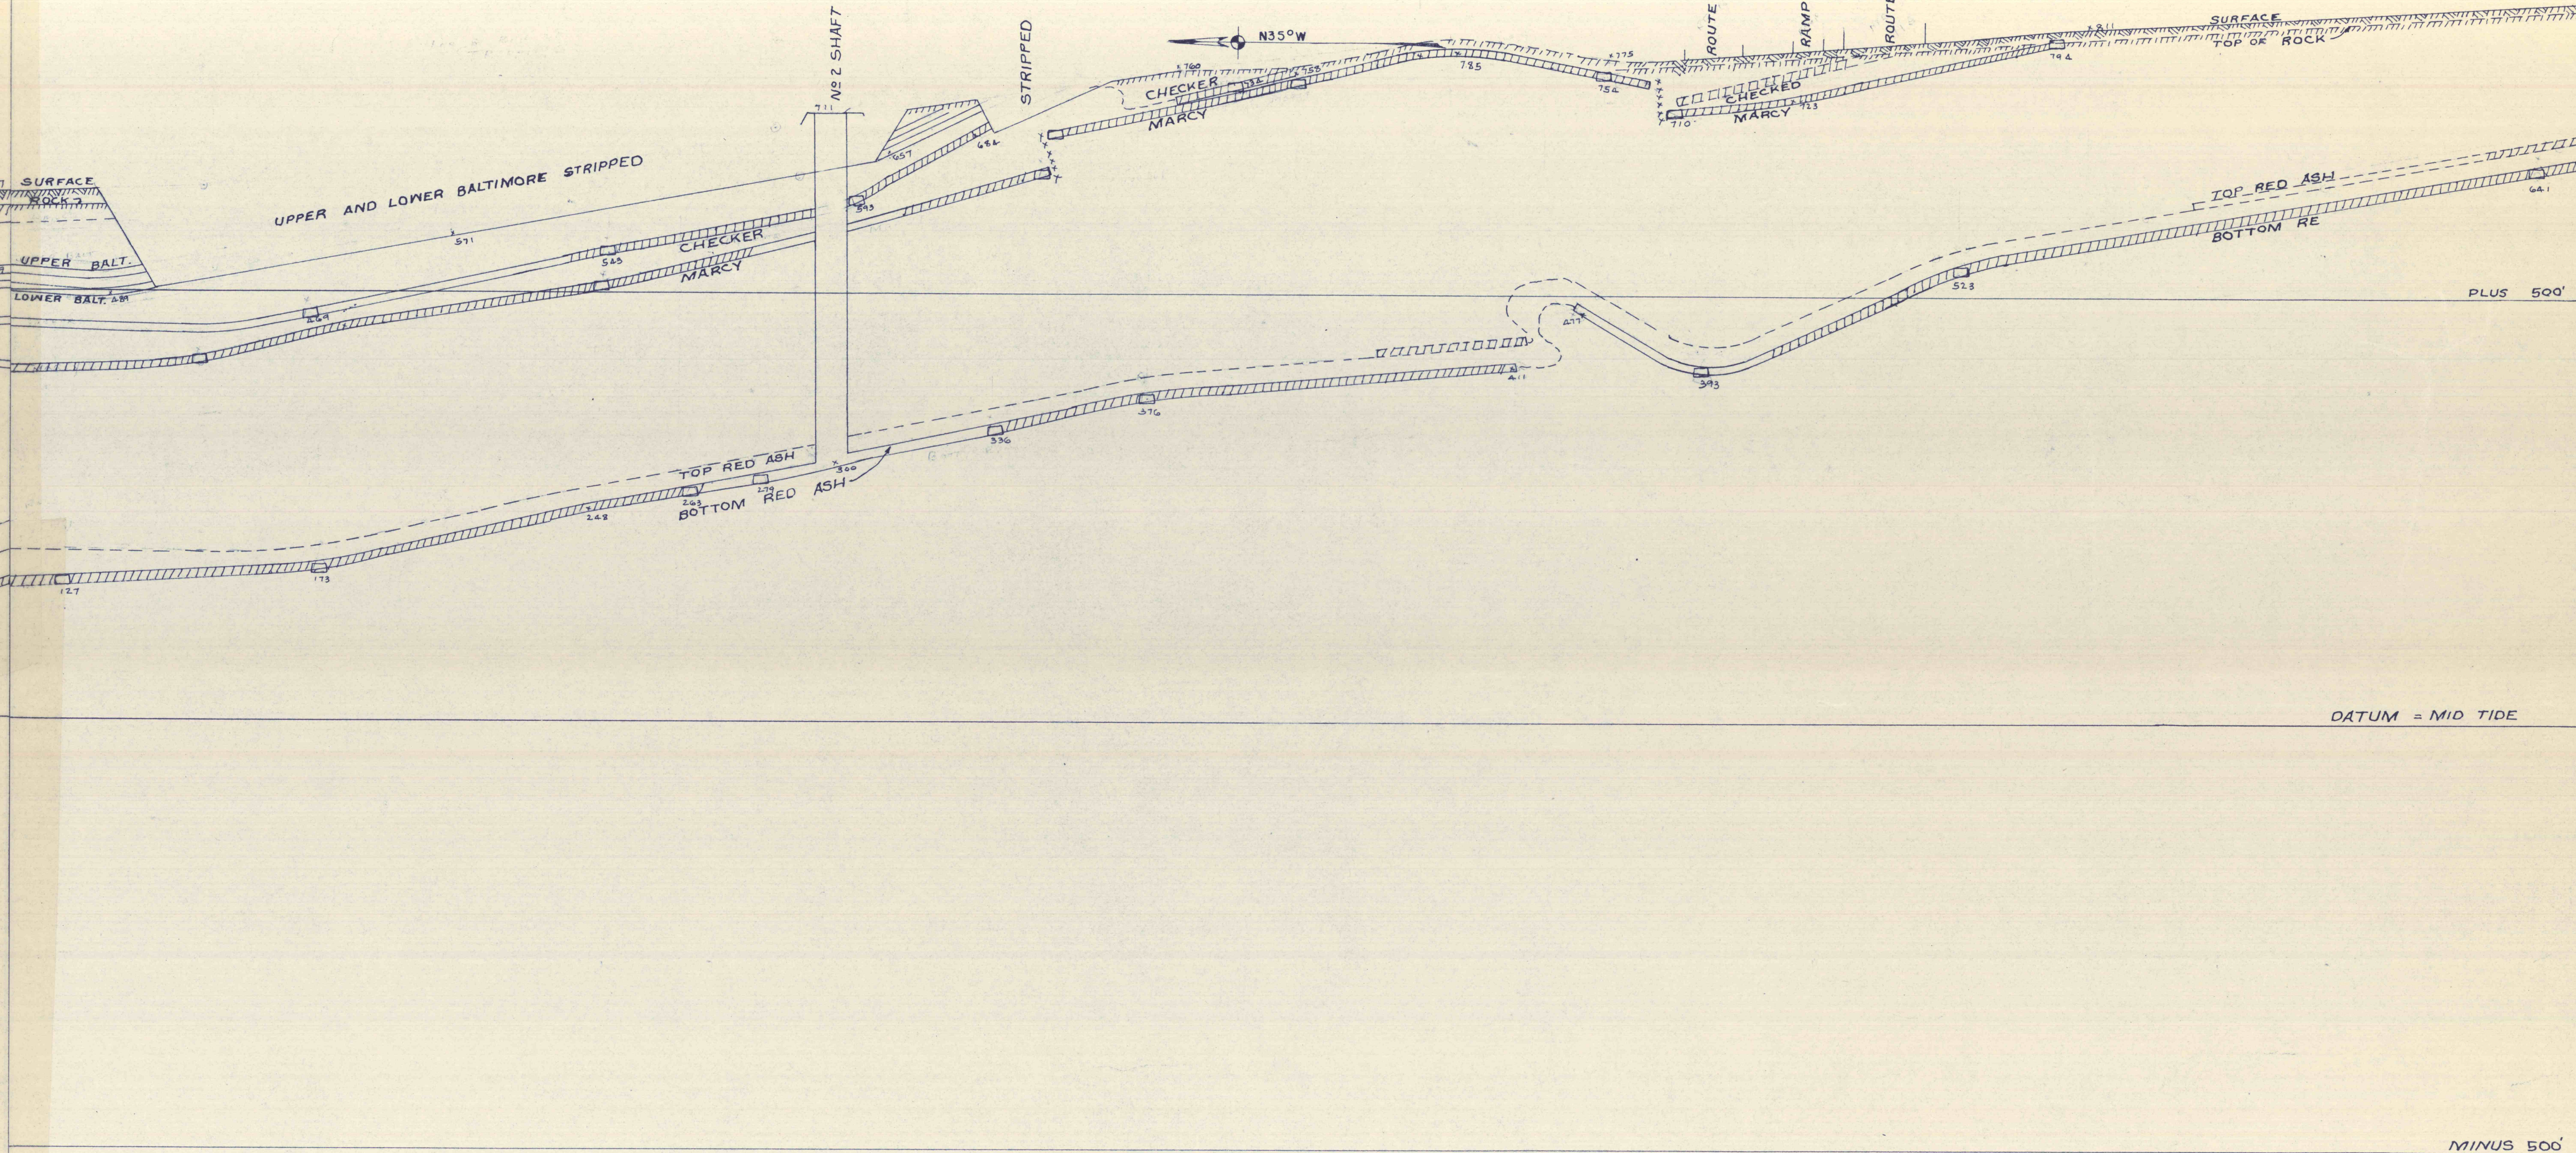

CROSS SECTION FOLIO 4 X

LOOKING UPSTREAM

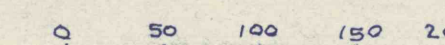

HORIZONTAL & VERTICAL SCALE IN FEET