


MT LOOKOUT  
TOP ROSS

PENNSYLVANIA COAL CO

TOP ROSS  
MT LOOKOUT

PENNSYLVANIA COAL CO.

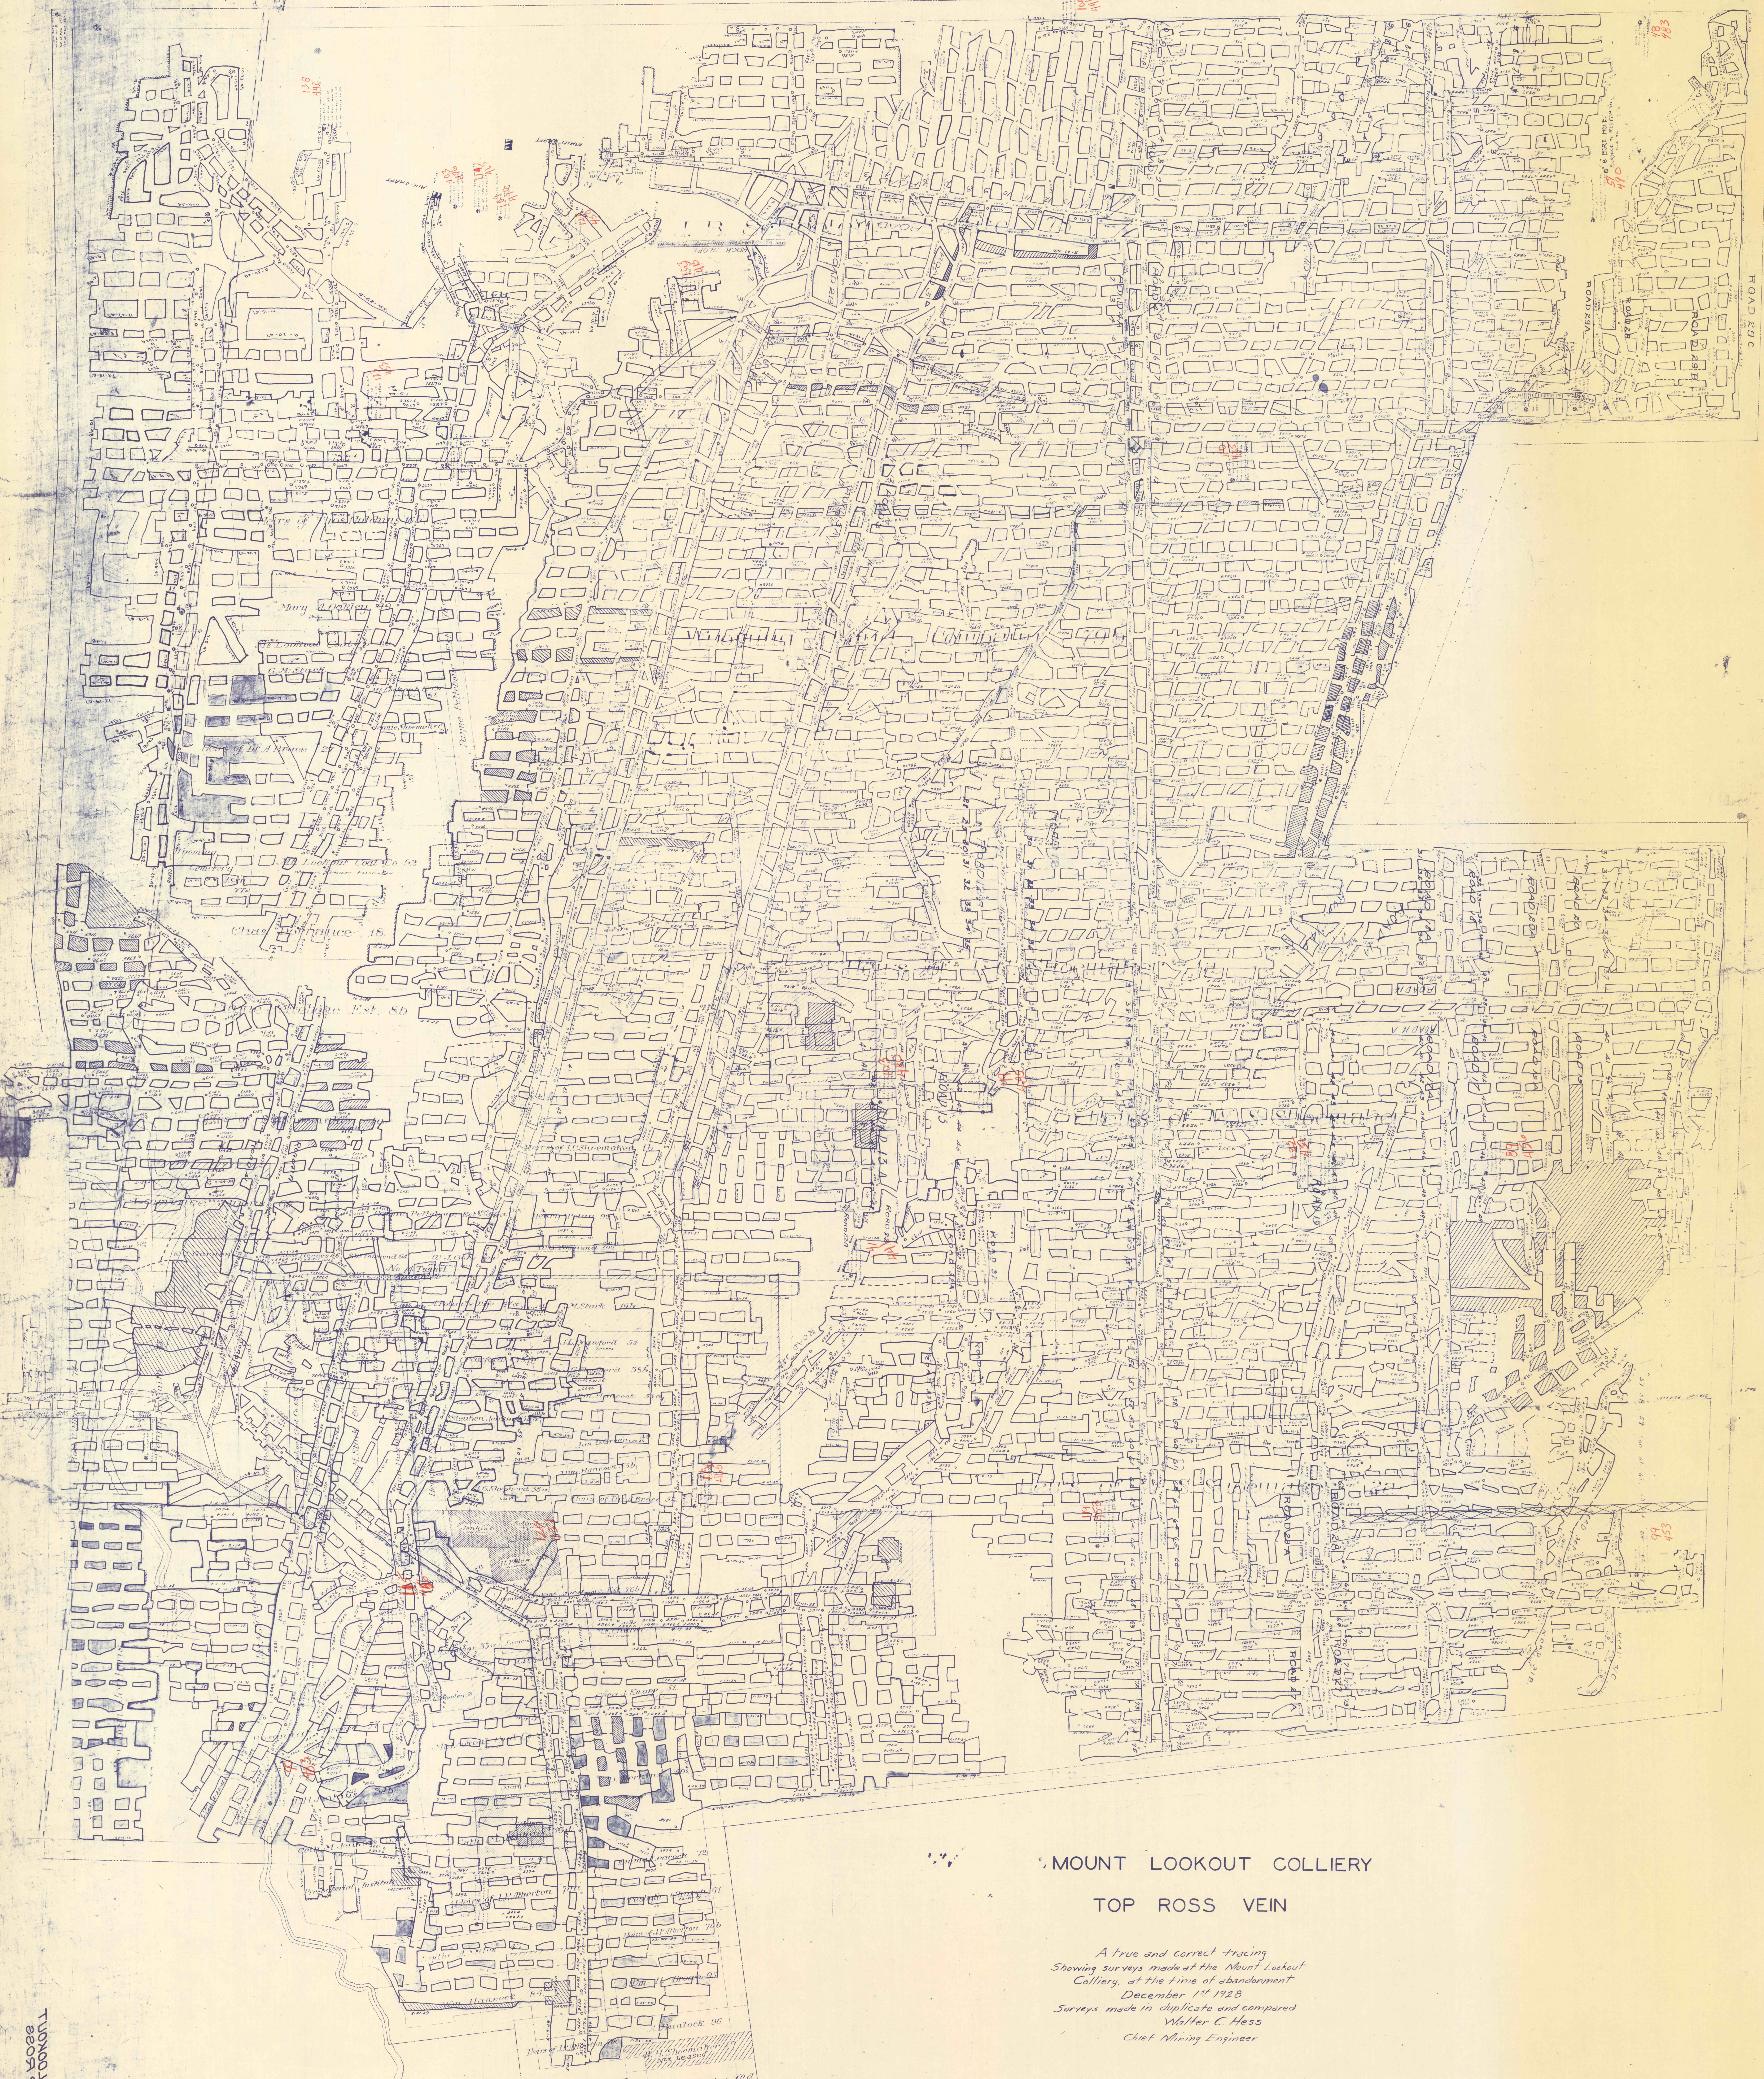

MOUNT LOOKOUT COLLIERY  
TOP ROSS VEIN

A true and correct tracing  
Showing surveys made at the Mount Lookout  
Colliery, at the time of abandonment  
December 1st 1928  
Surveys made in duplicate and compared  
Walter C. Hess  
Chief Mining Engineer

TUNOAOI TM  
2009 007