


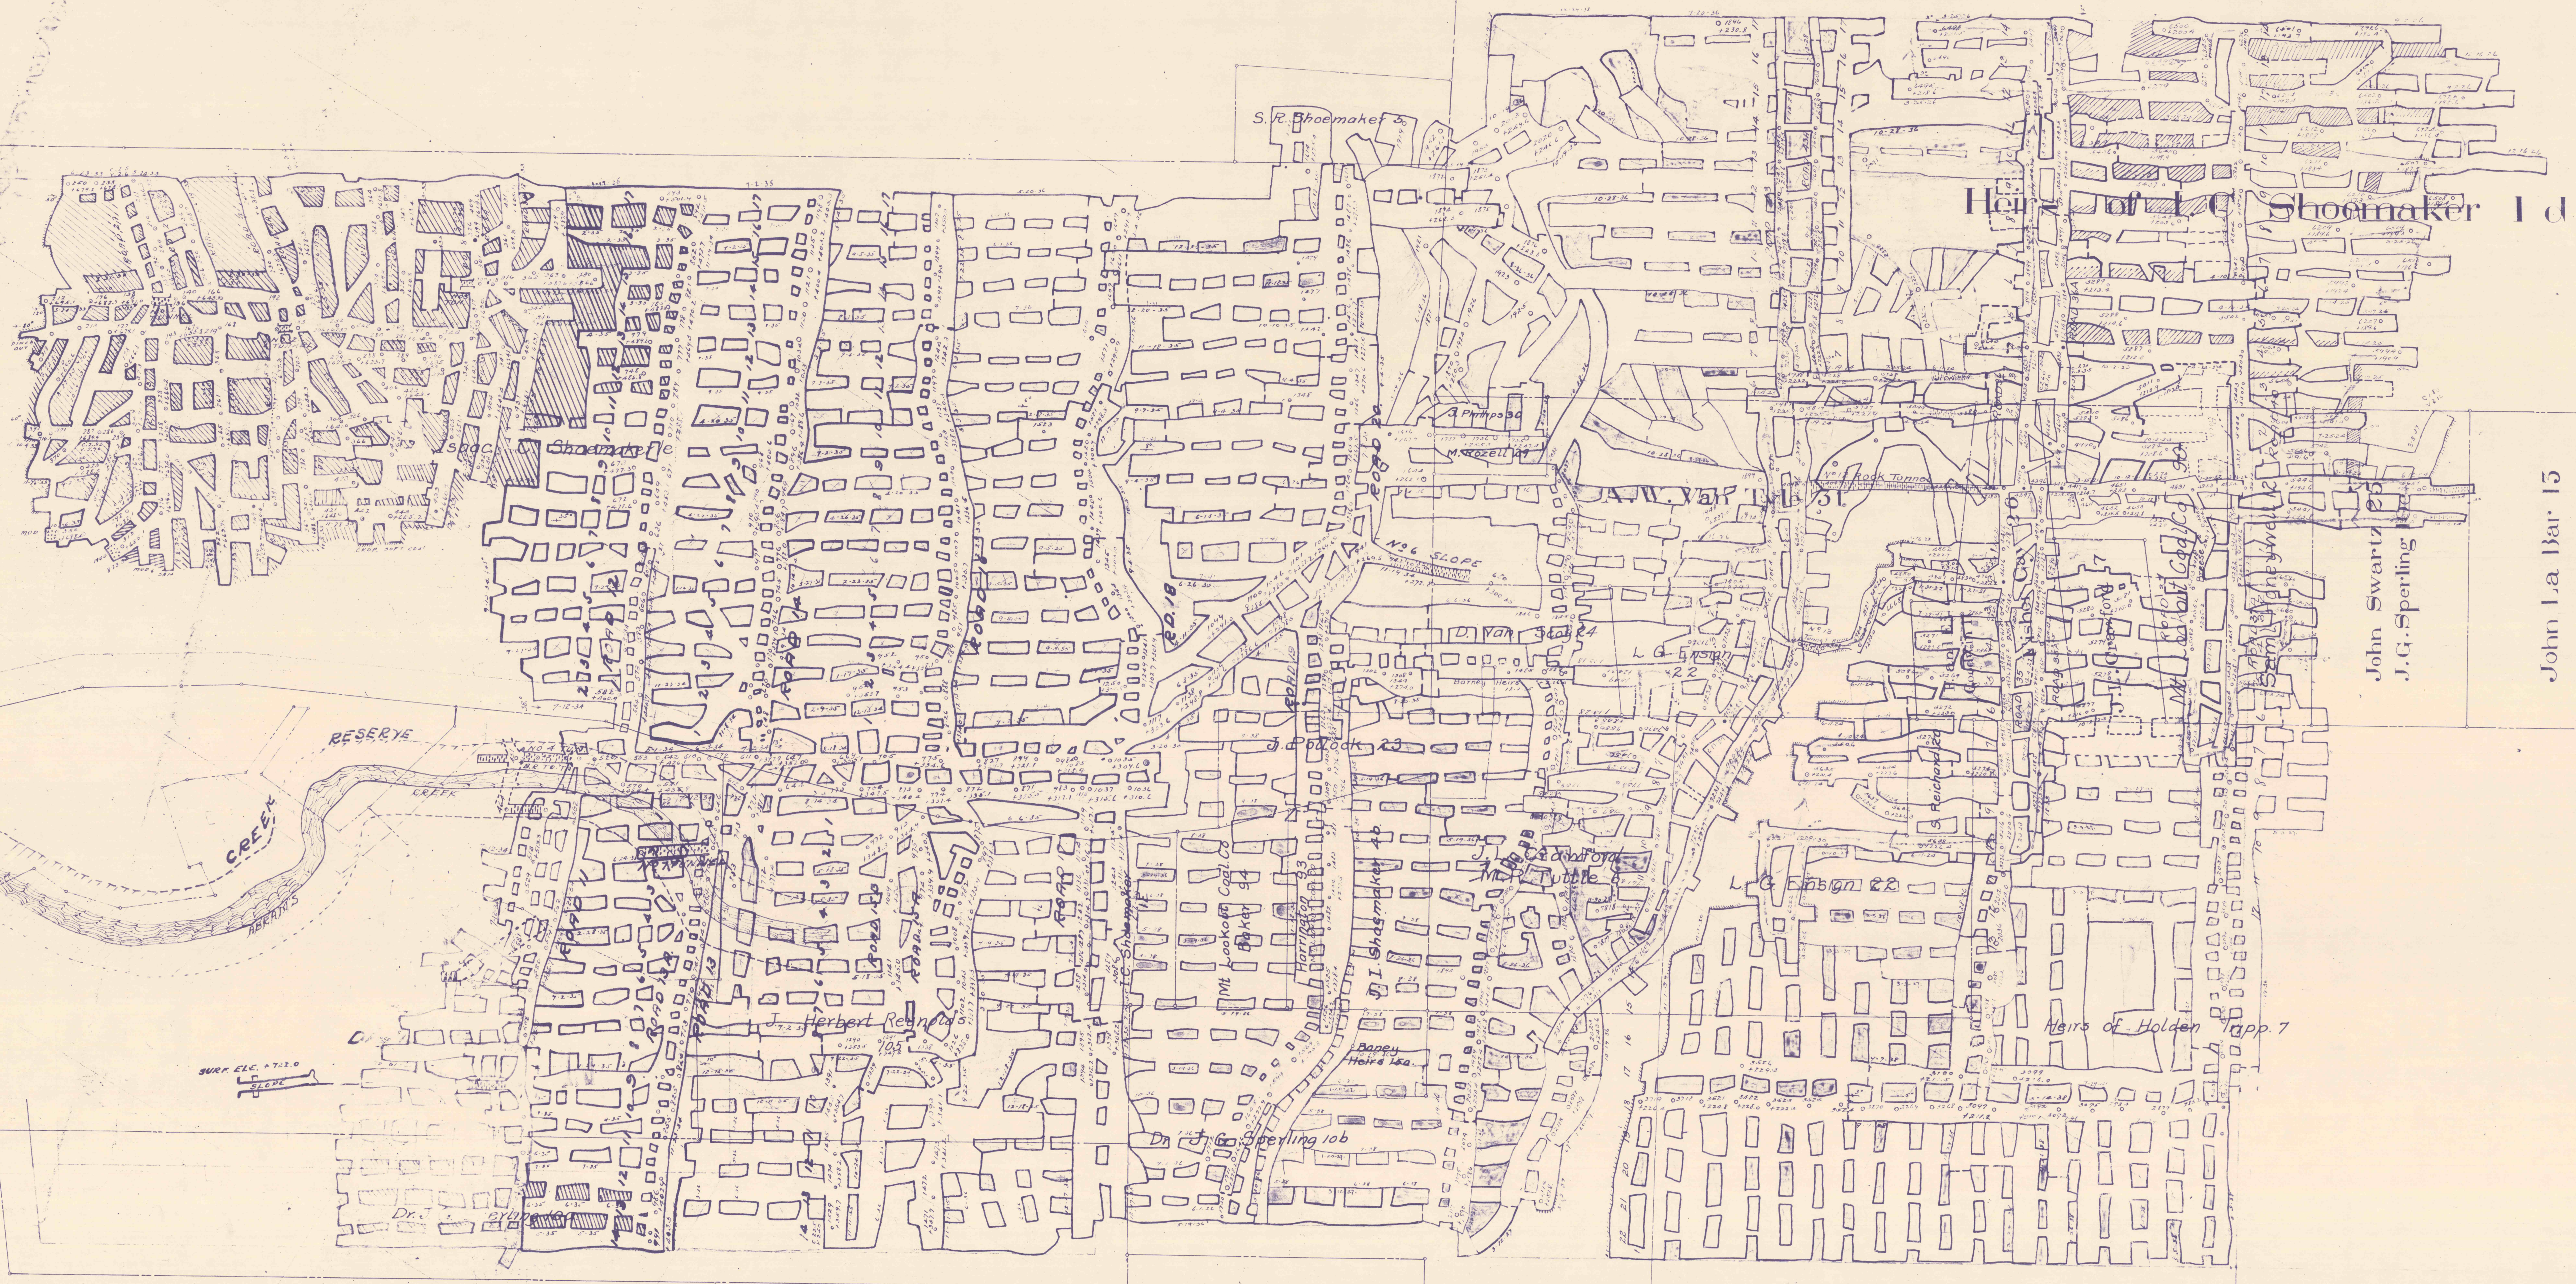

John Swartz 25
J.G. Sperling 14

John La Bar 15

Jos. Mitchell 14

DIAL ROCK COAL CO.
TOP ROSS VEIN
MINE INSPECTORS TRACING.

L. V. COAL CO.

Mt Lookout Top-Ross

Payne, Pettebone Estate 8a.

POSTING DATES.
AUG. 1935