


MATCH
LINE

~~1296~~ 1136
~~1073~~ - 390
- 1175

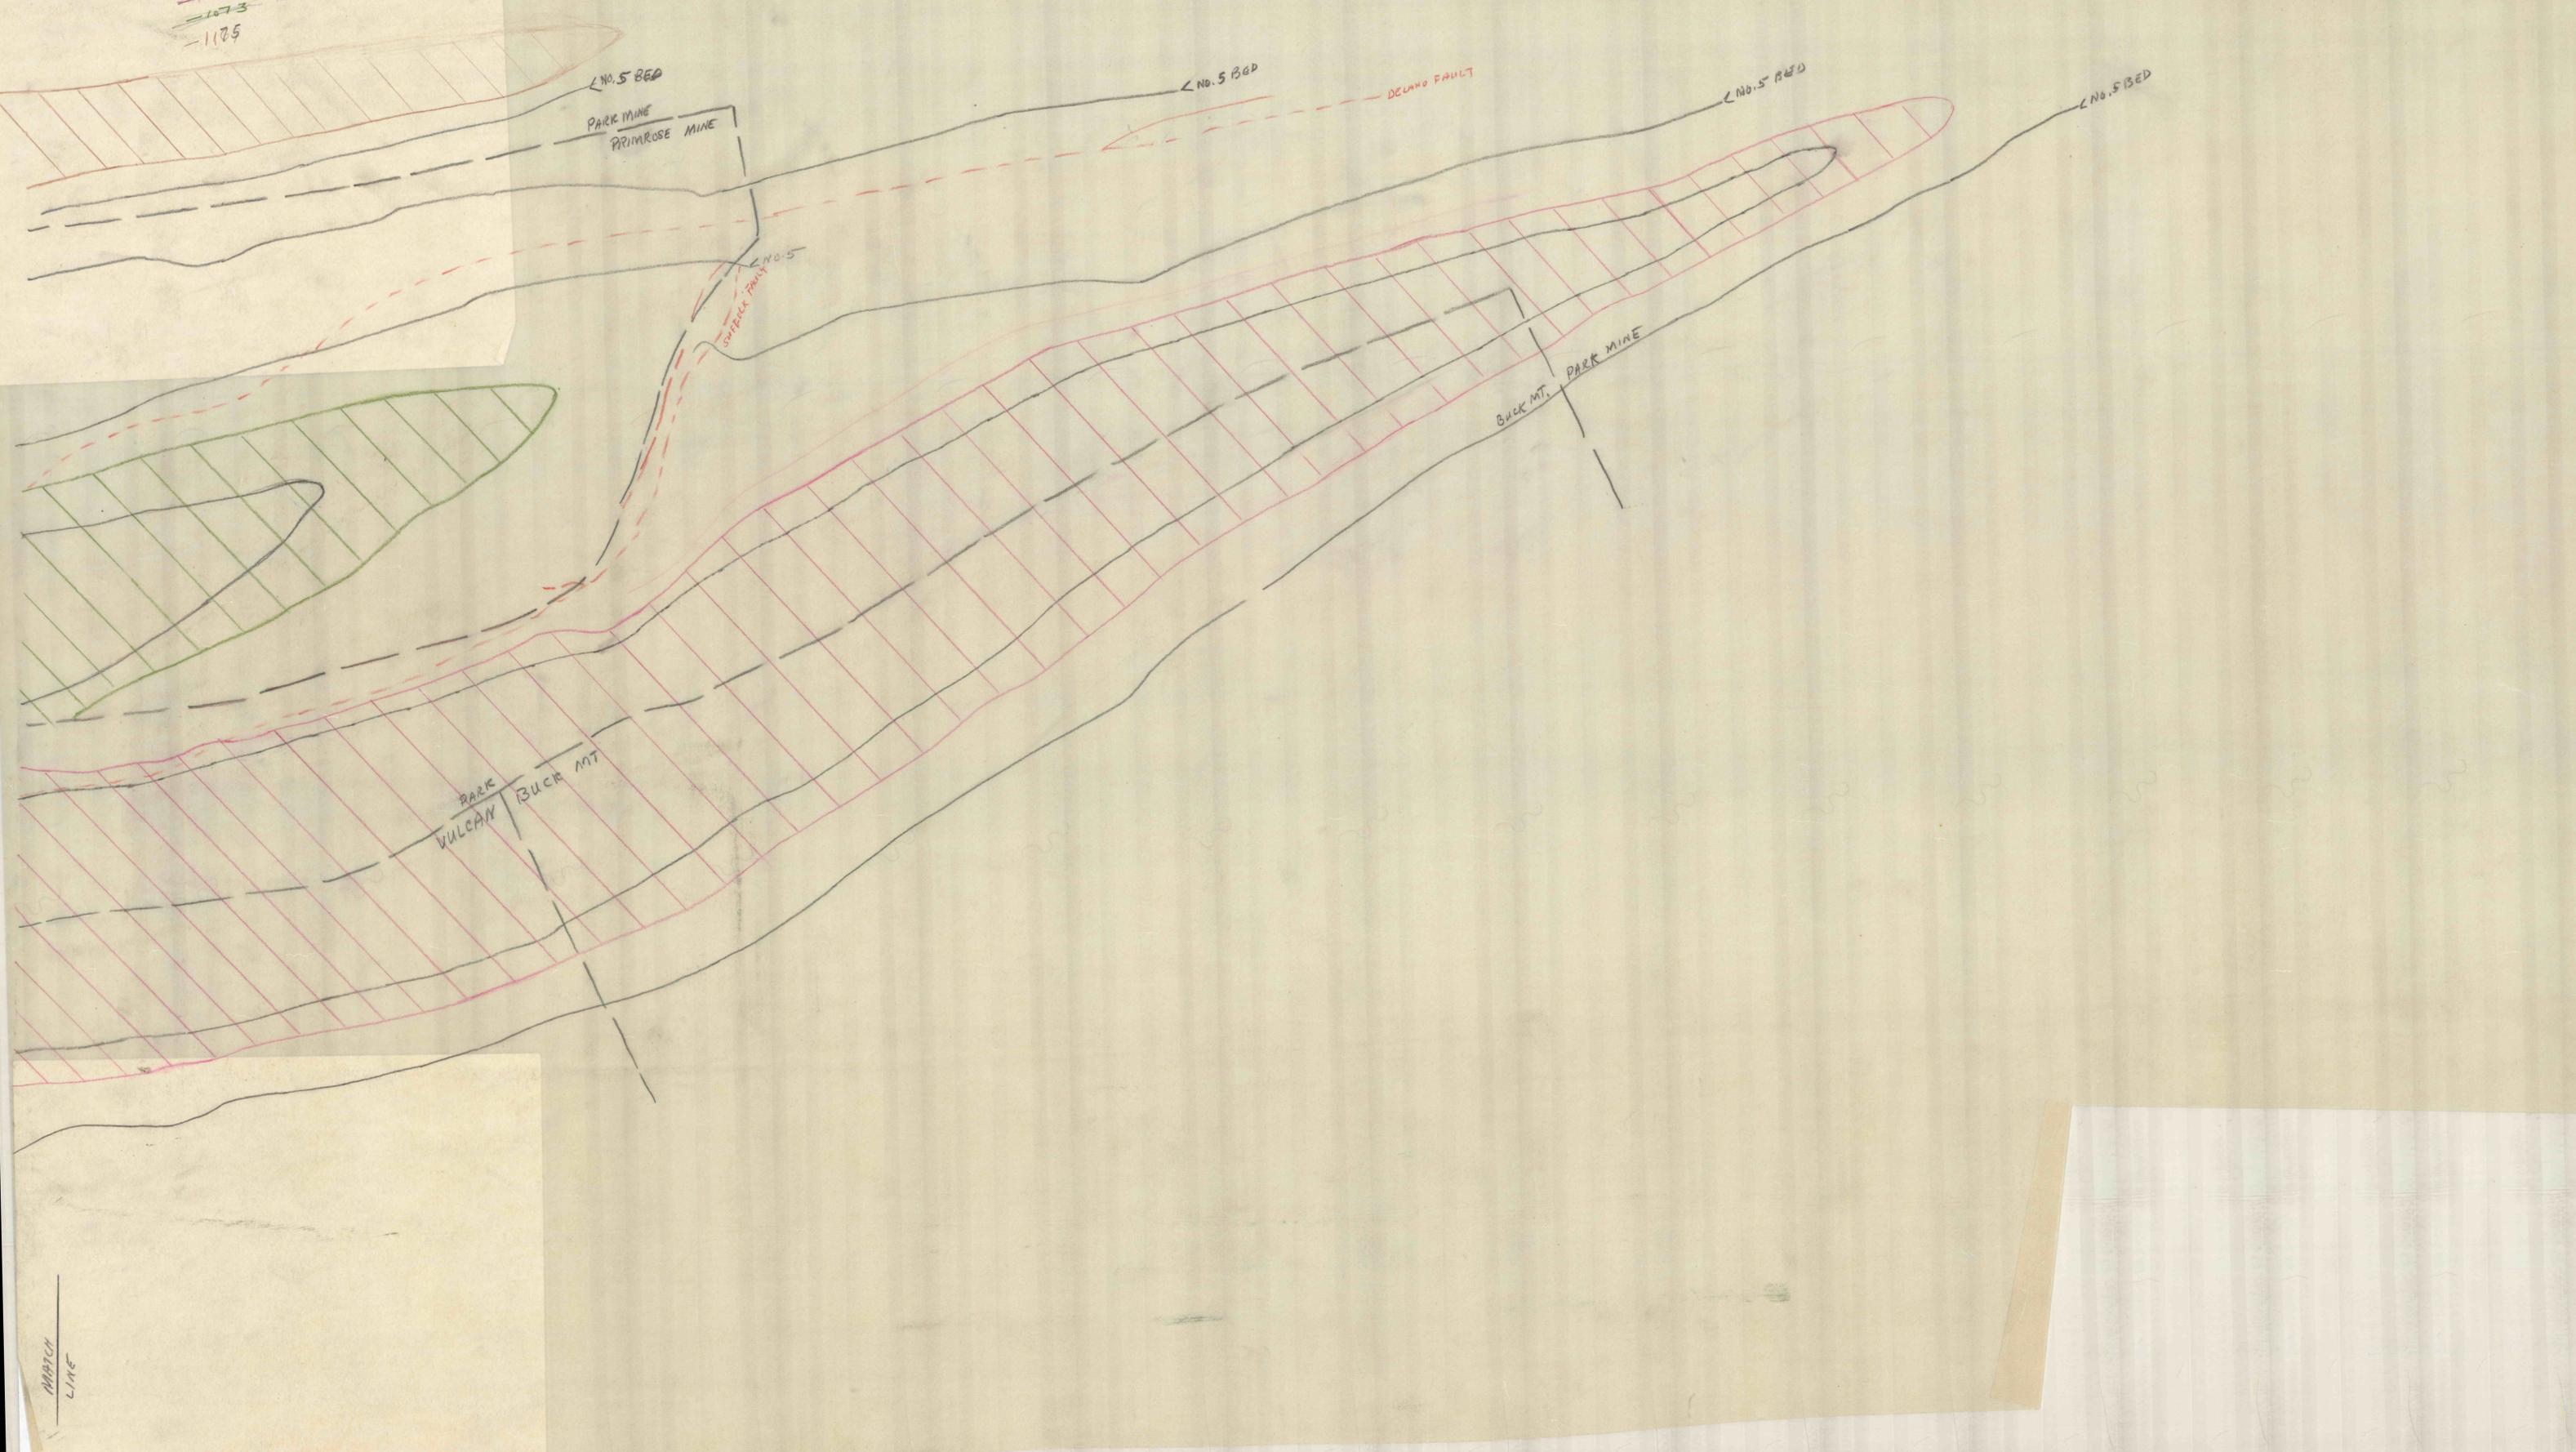

MATCH
LINE