

BORE HOLE No. 89

SEITZINGER TRACT


Scale 40 ft. per inch AB Cochran & Son
DECEMBER '90. MINING ENGINEERS.

Elevation +693.10.


Scale 4 ft. per inch



0' 10 3/4" Bony Coal
1' 9 3/4" COAL
2' 8 1/2"

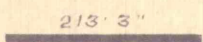

0' 1 1/2" COAL

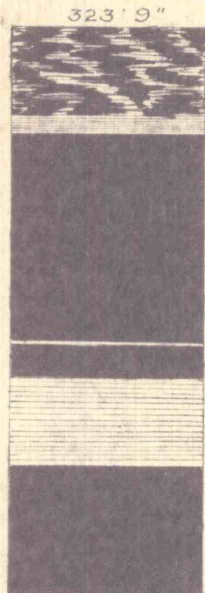

1' 10" Bony Coal
0' 4 1/2" Slate
4' 3 1/2" COAL
0' 0 3/4" Slate
0' 3 3/4" COAL
1' 10" Slate
2' 9" COAL

11' 10 1/2"
Average dip of vein 24°

