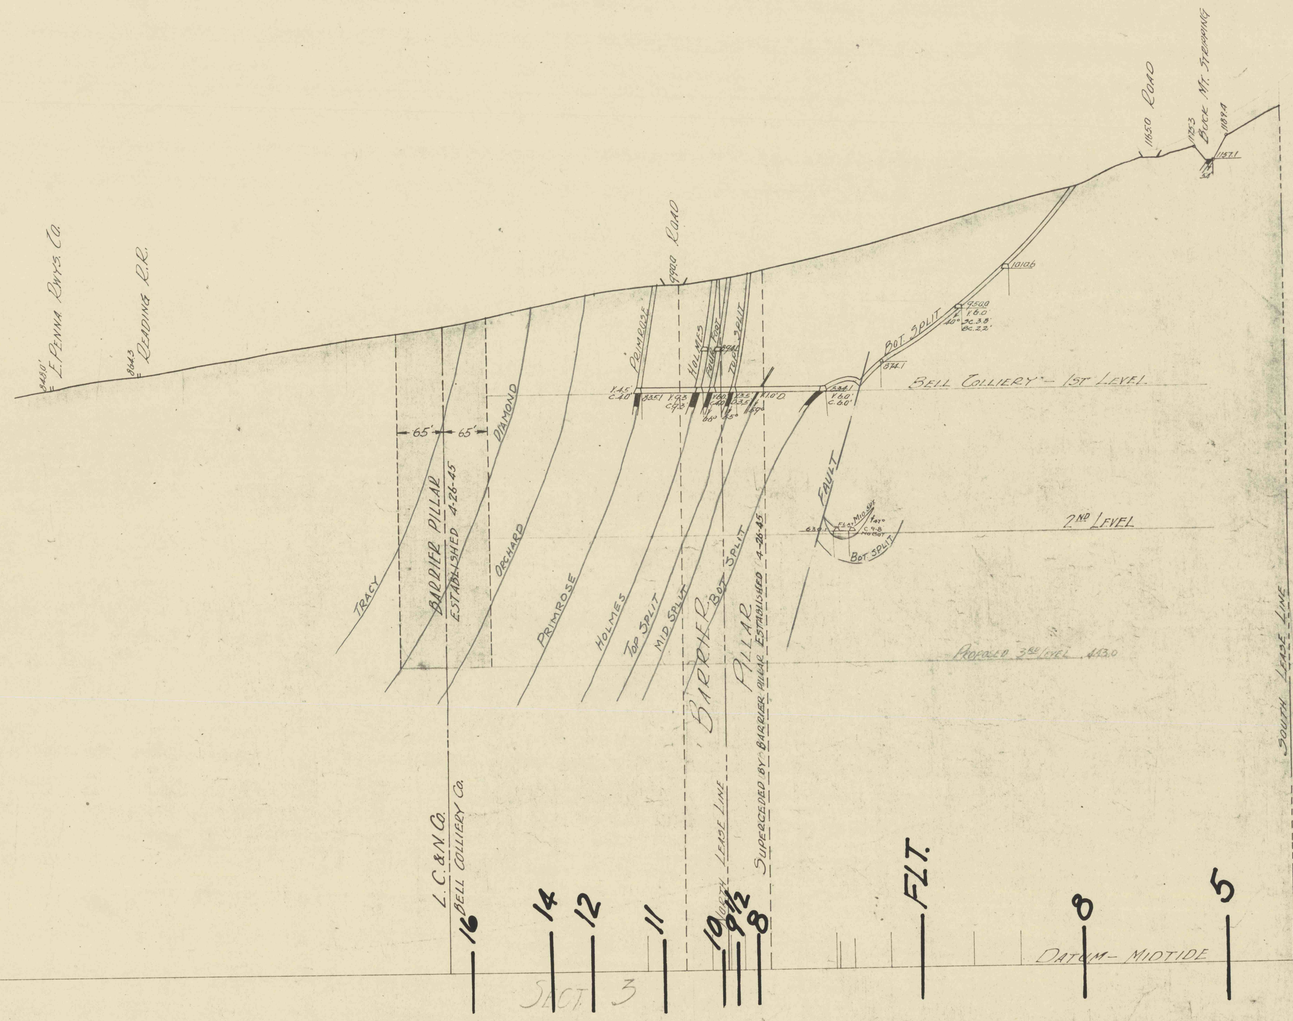
L. Penna Brys Co
Road
Road
Bell Colliery - 1st Level
2nd Level
Proposed 3rd Level
Bot Split
Top Split
Mid Split
Fault
Diamond
Orchard
Primrose
Holmes
Tracy
Barrier Pillar
Established 4-28-45
Superceded by Barrier Pillar Established 4-28-45
South Lease Line
L. C. & N. Co.
Bell Colliery Co.
Datum - Midtide
Blue Tag No 27
Sect. 3
65'
65'
16
14
12
11
10
9
8
Flt.
8
5
3

3/B

#3 BELL

3/B