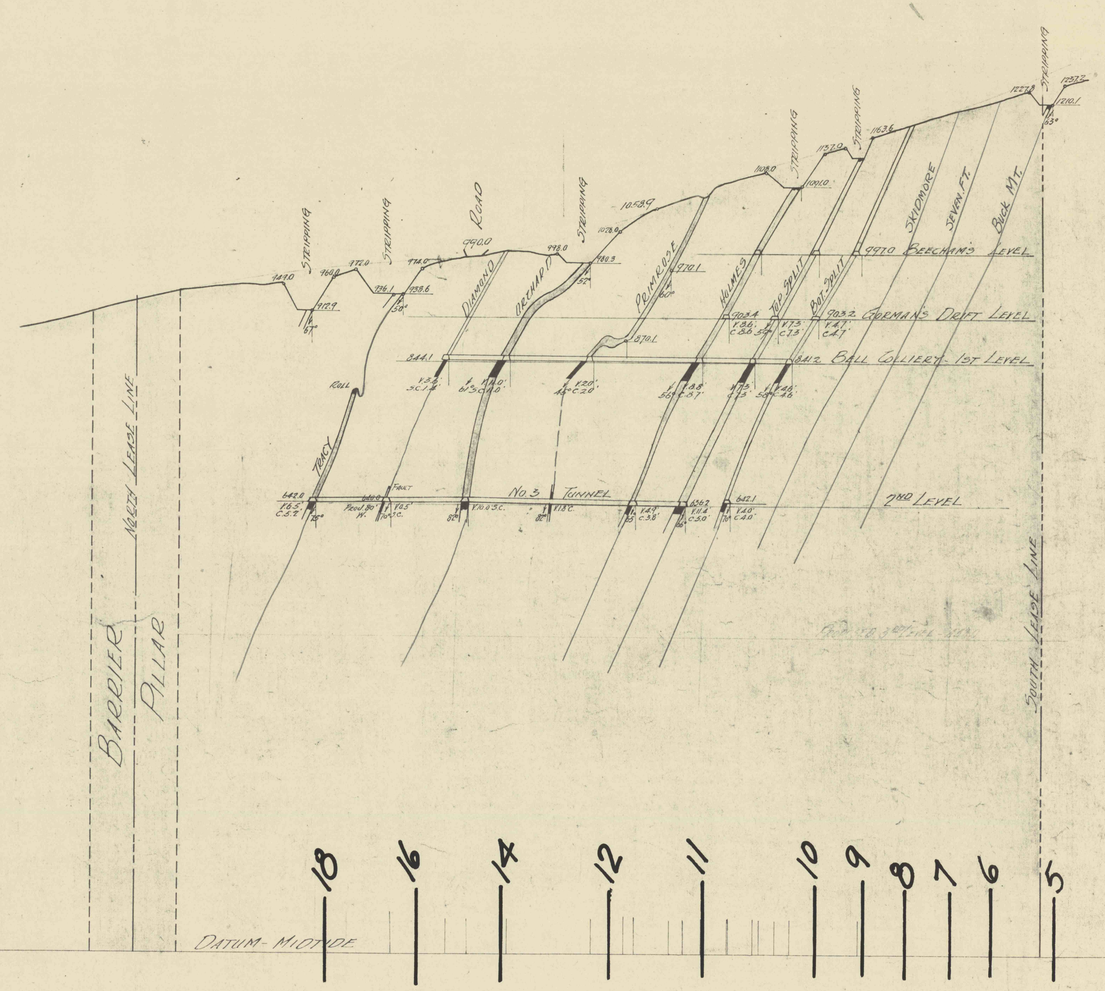


BLUE TAG No 27

6

6/B

#6 BELL

6/B