VALLEY FURNACE ESTATE

GLENTWORTH TRACT

A.C.M. Co.

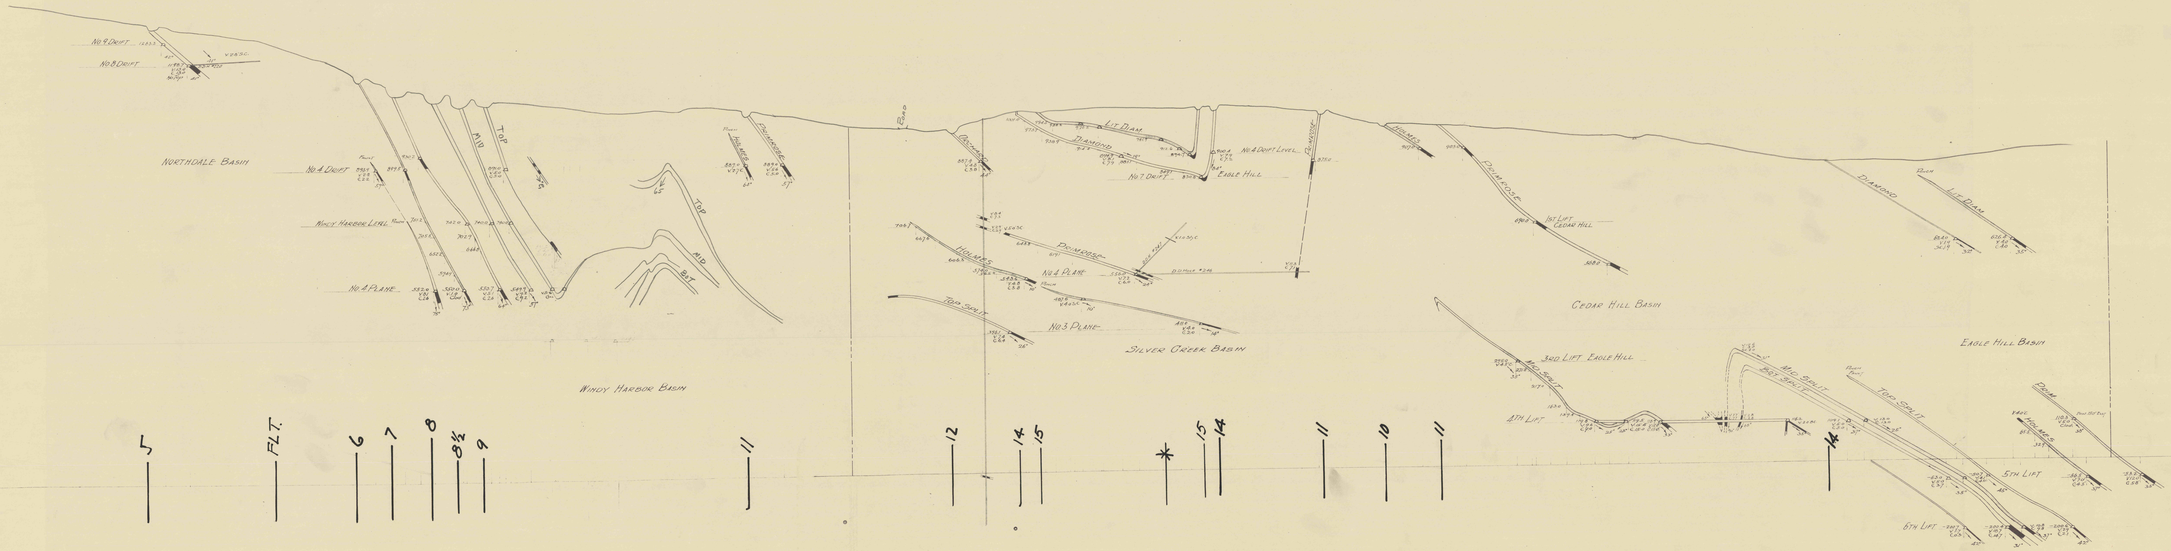

#9 SILVER CREEK