
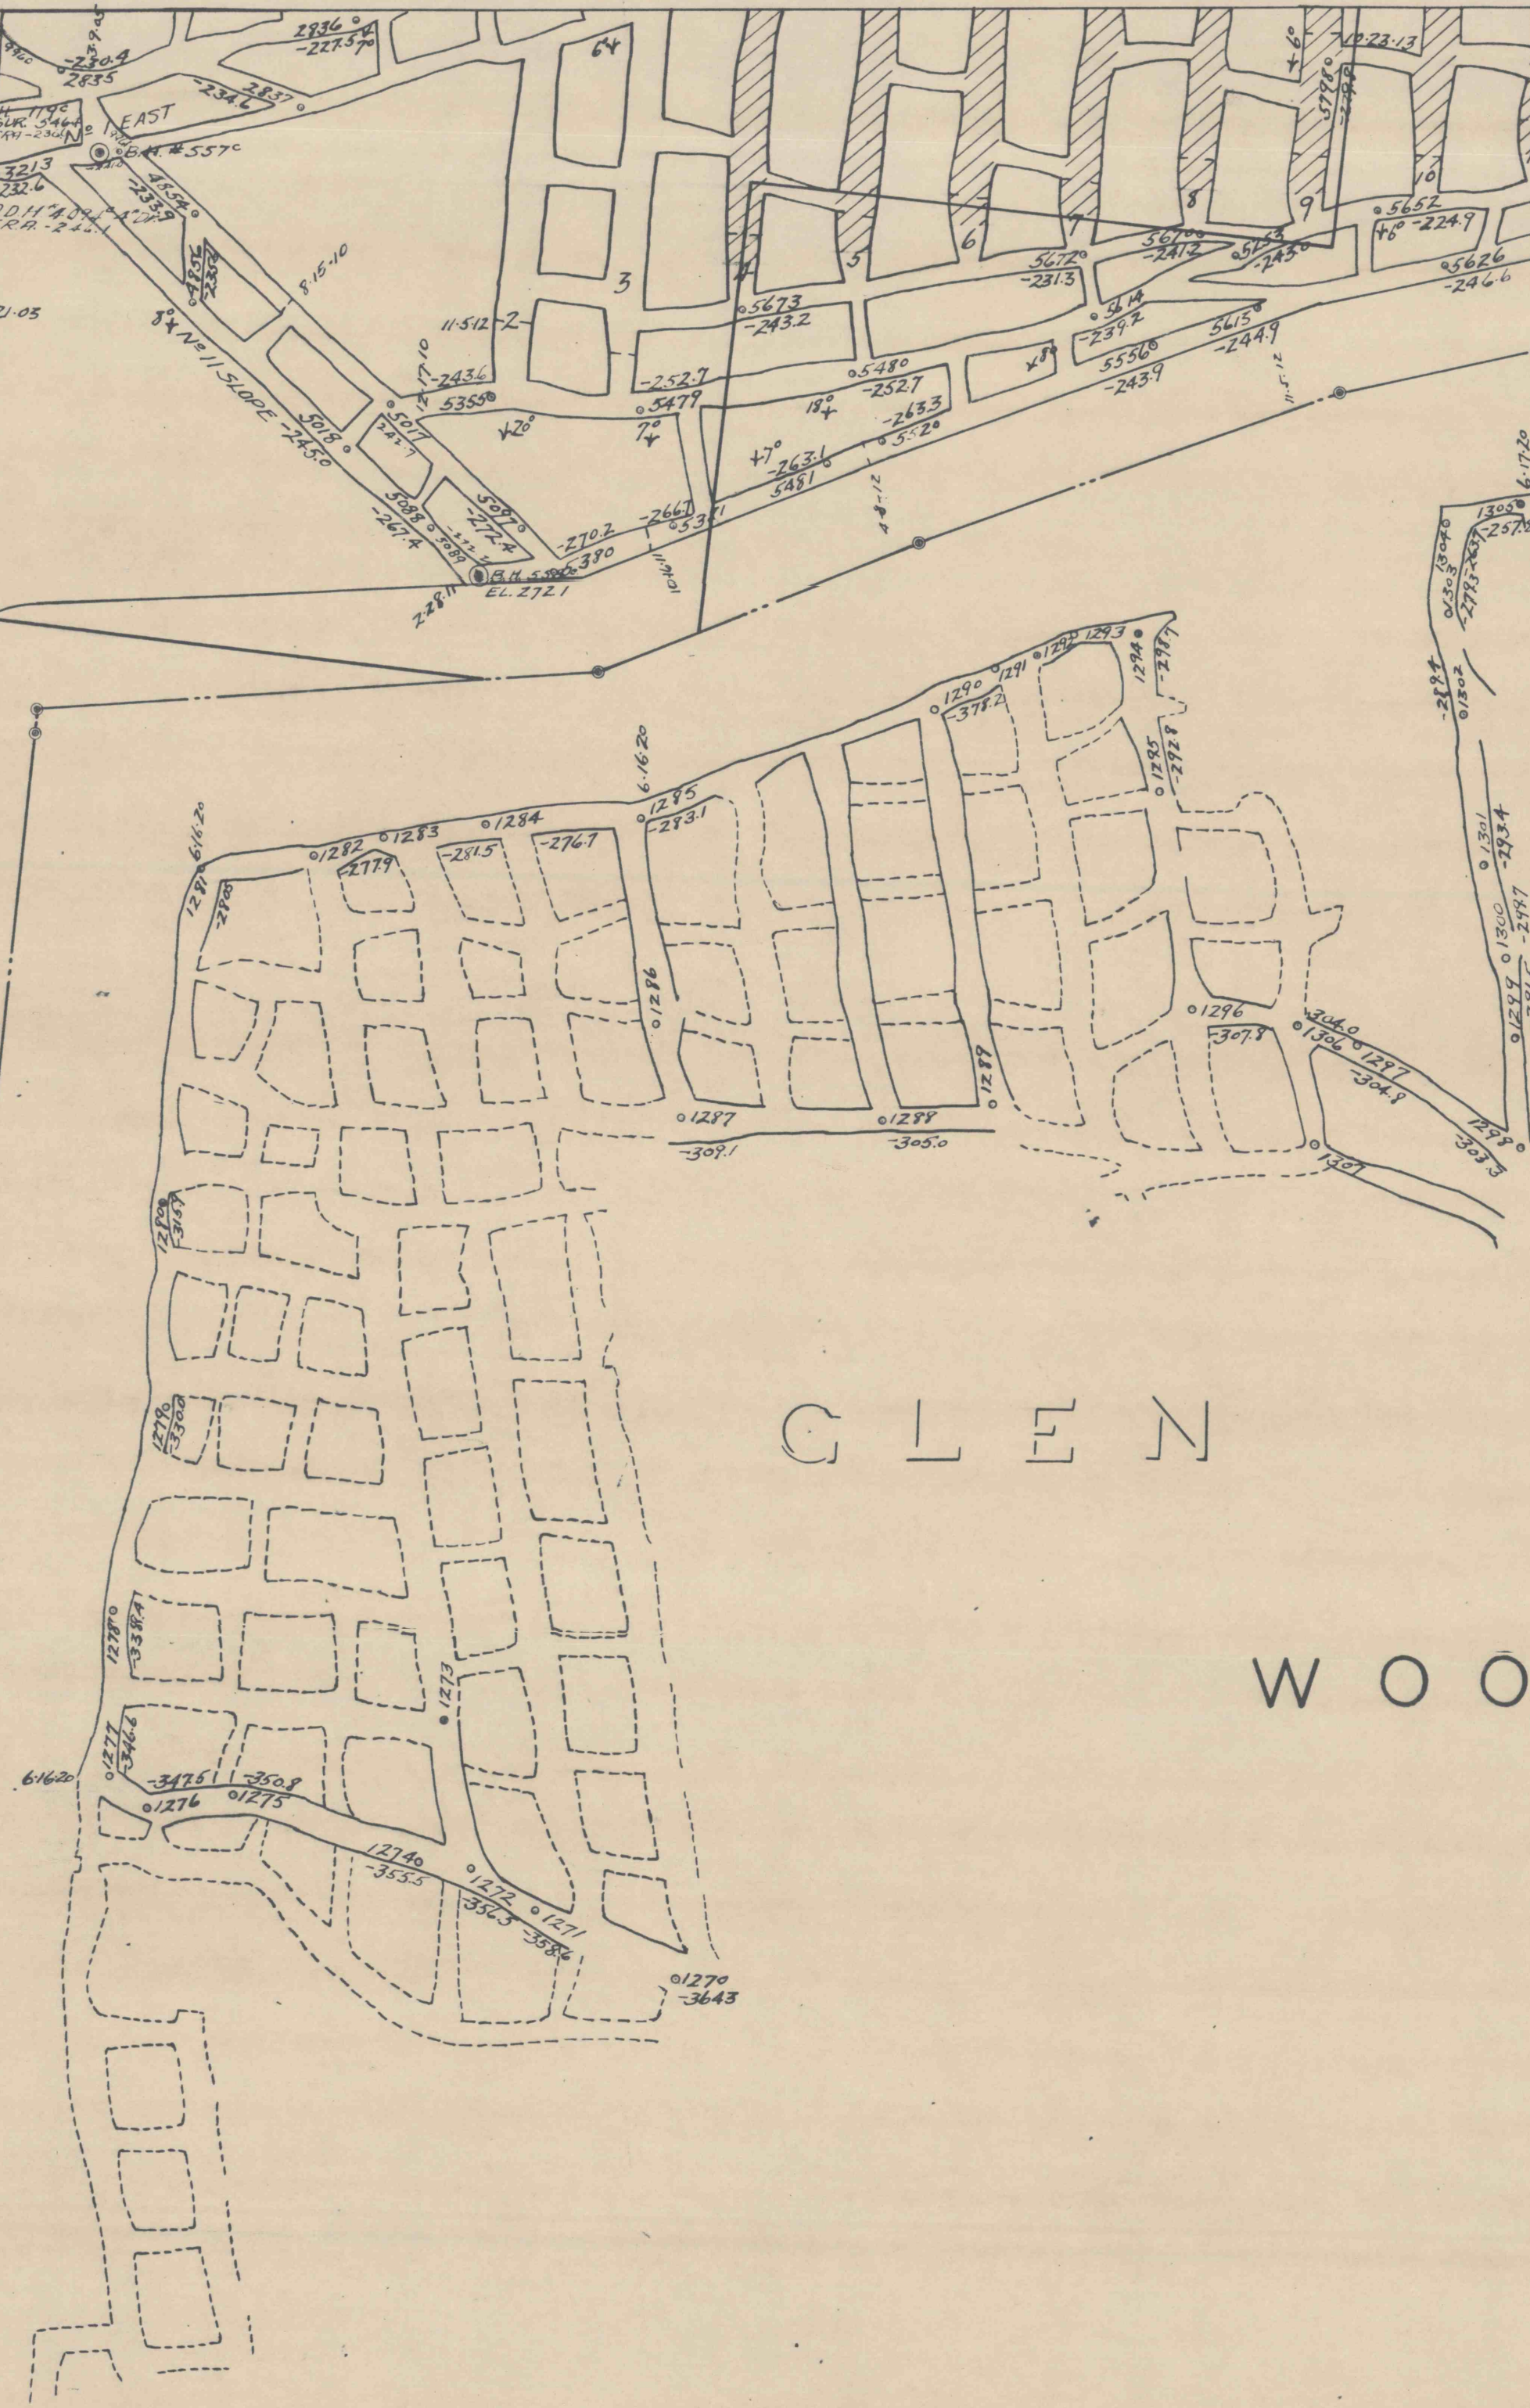



GLEN ALDEN COAL CO.

LANCE COLLIERY

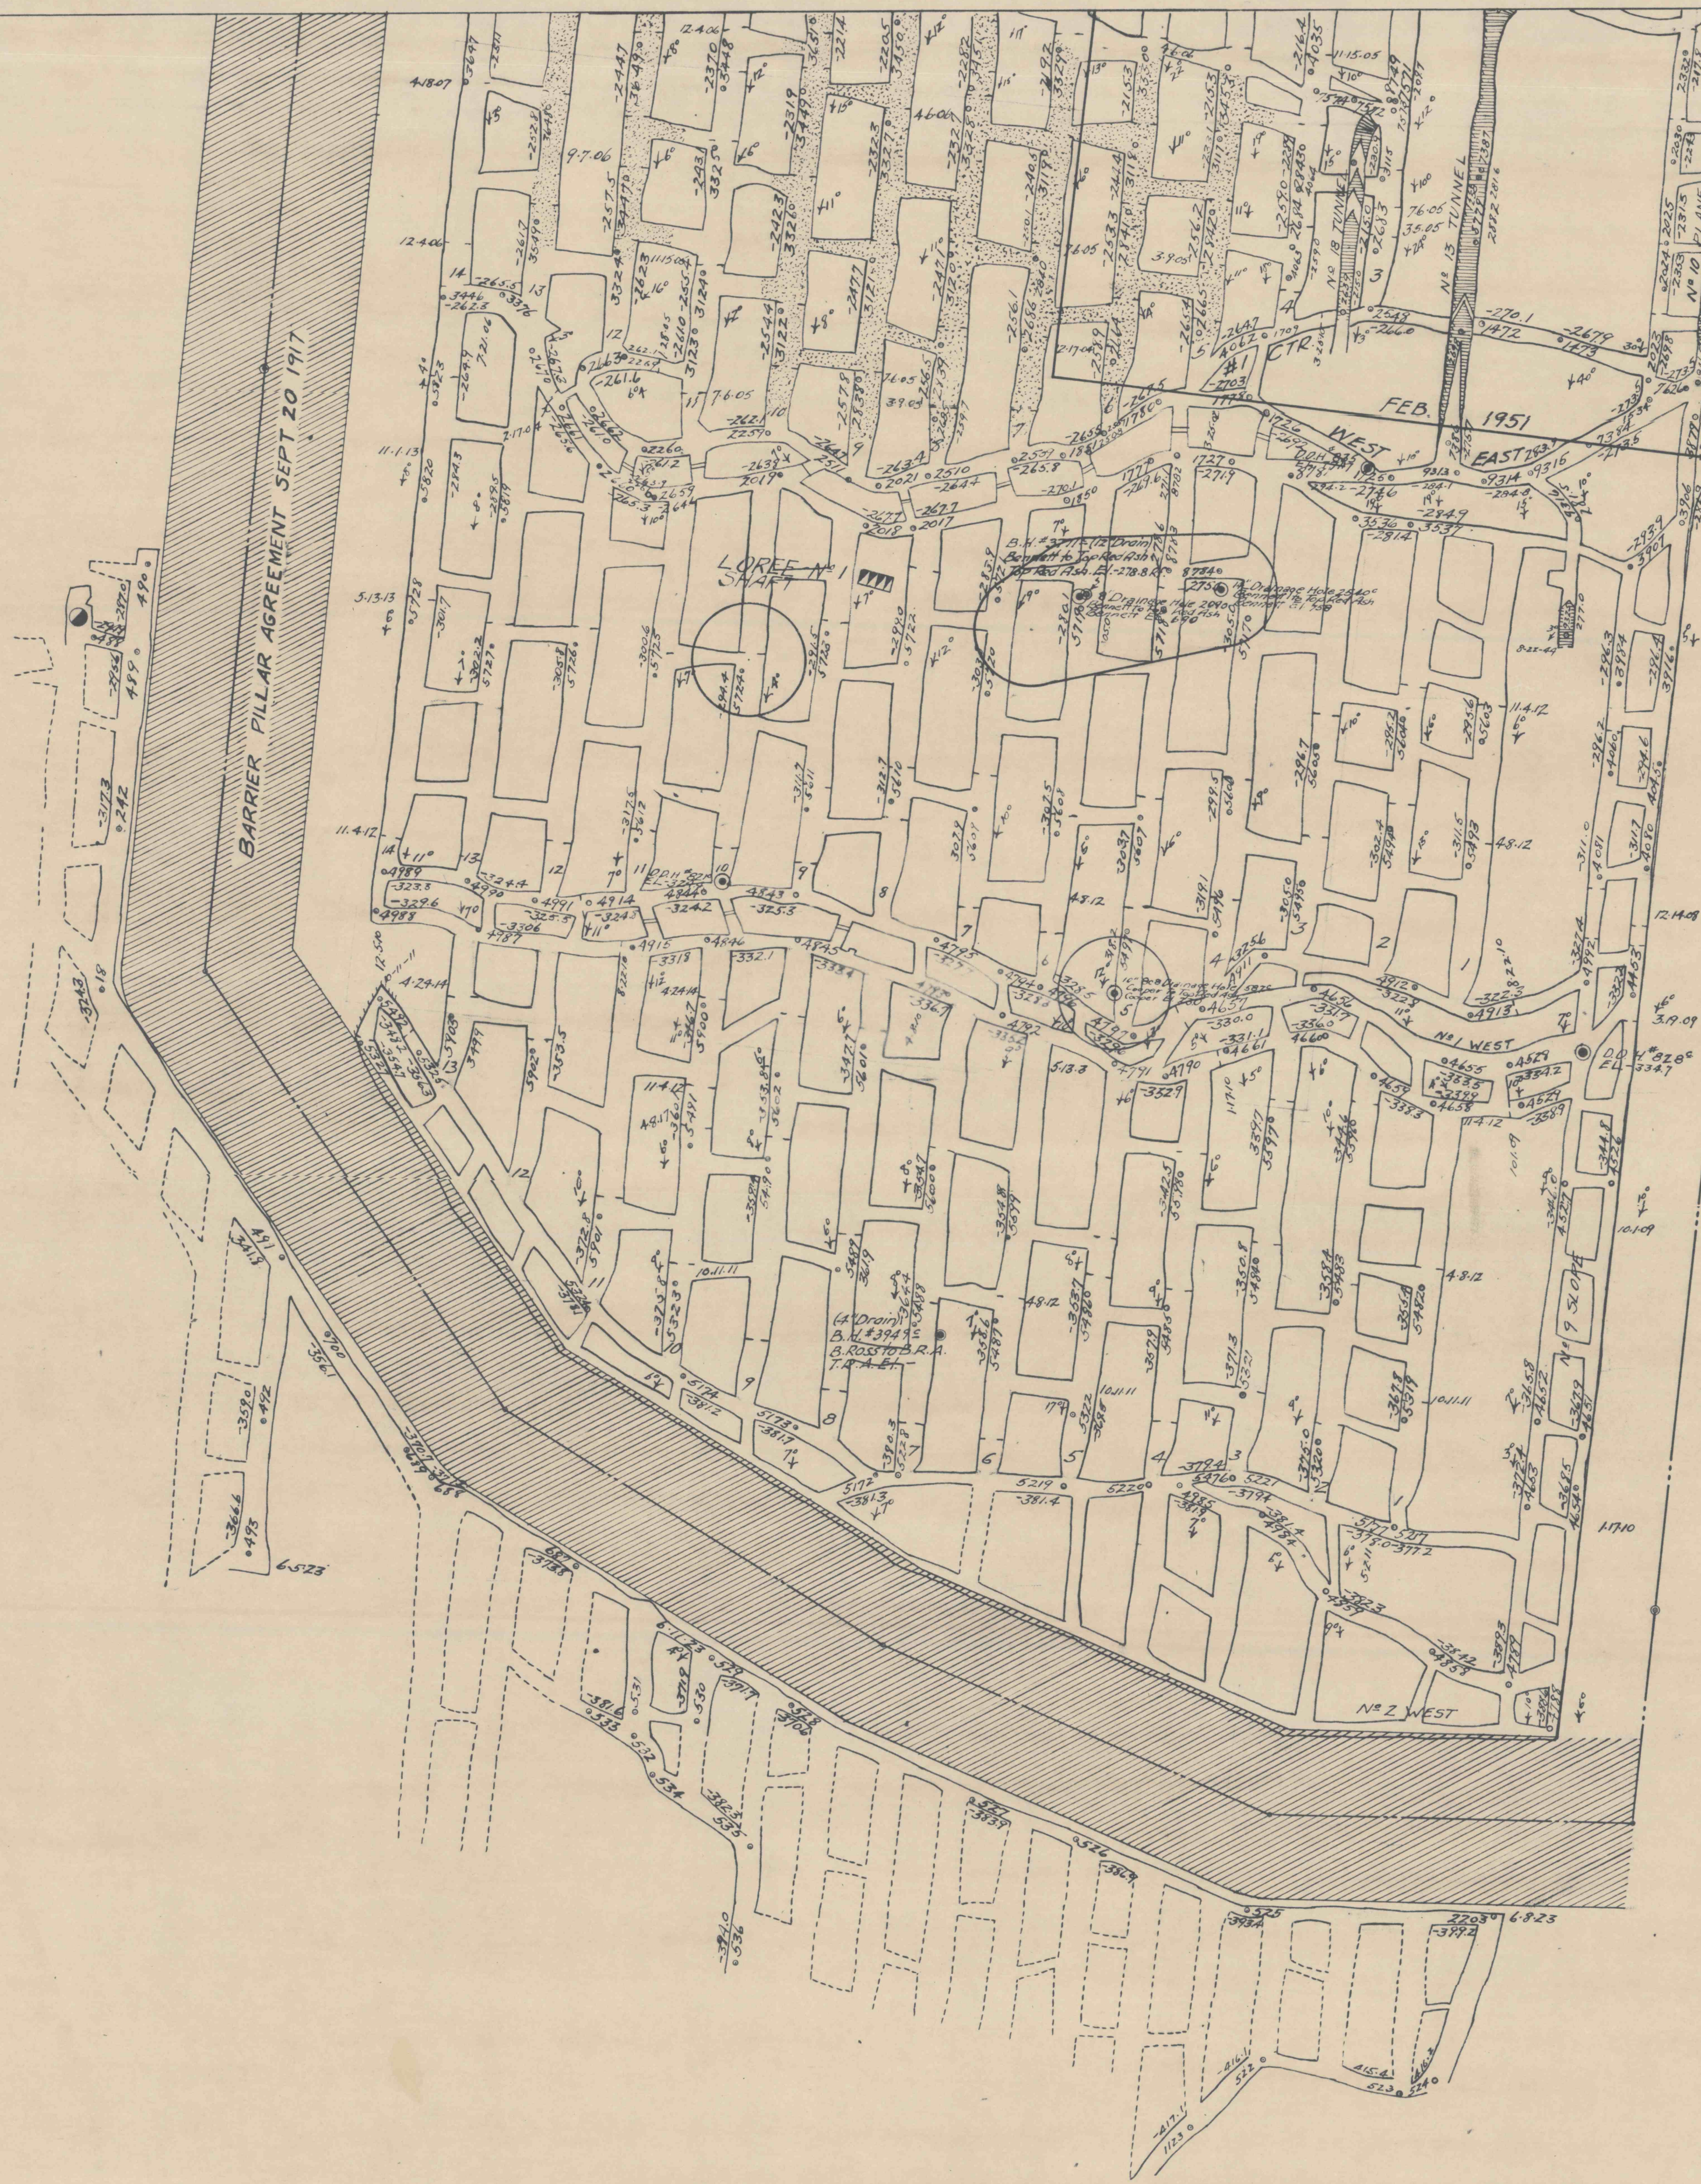

GLEN ALDEN COAL CO.
WOODWARD COLLIERY

