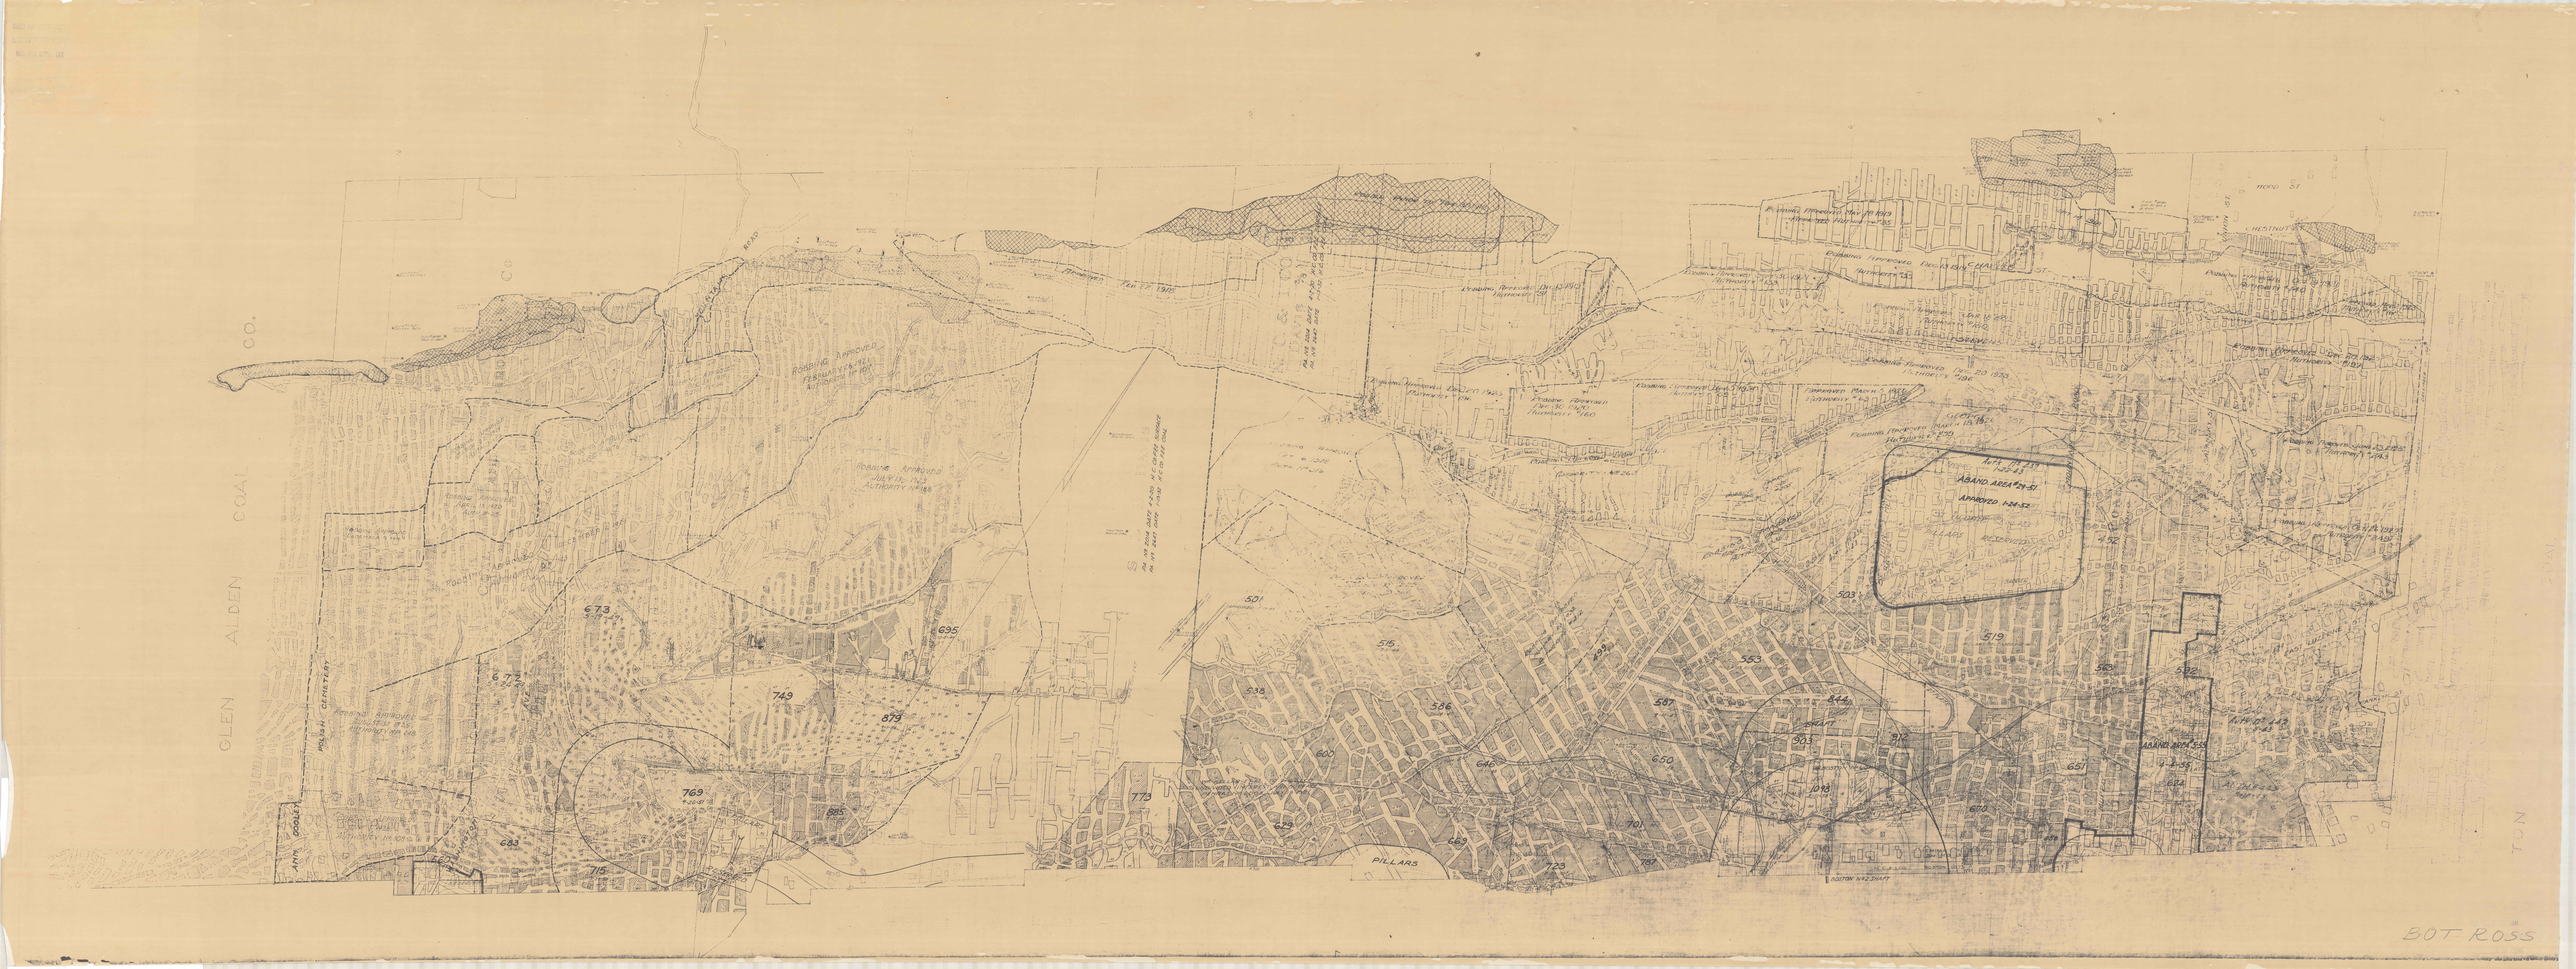

GLEN ALDEN COAL CO.
ROBBINS APPROVED FEBRUARY 1952
ROBBINS APPROVED JULY 1952
ROBBINS APPROVED JUNE 20 1952
ROBBINS APPROVED NOV 30 1950
ABAND AREA 1-24-52
APPROVED 1-24-52
ABAND AREA 5-19-52
APPROVED 5-19-52
PILLARS
673
695
749
873
769
685
715
501
515
536
600
646
679
669
773
723
701
783
587
650
553
503
1013
912
644
519
523
563
562
651
672
684
WOOD ST
CHESTNUT
PARISH CEMETERY
ANN COOLEY
BOT ROSS