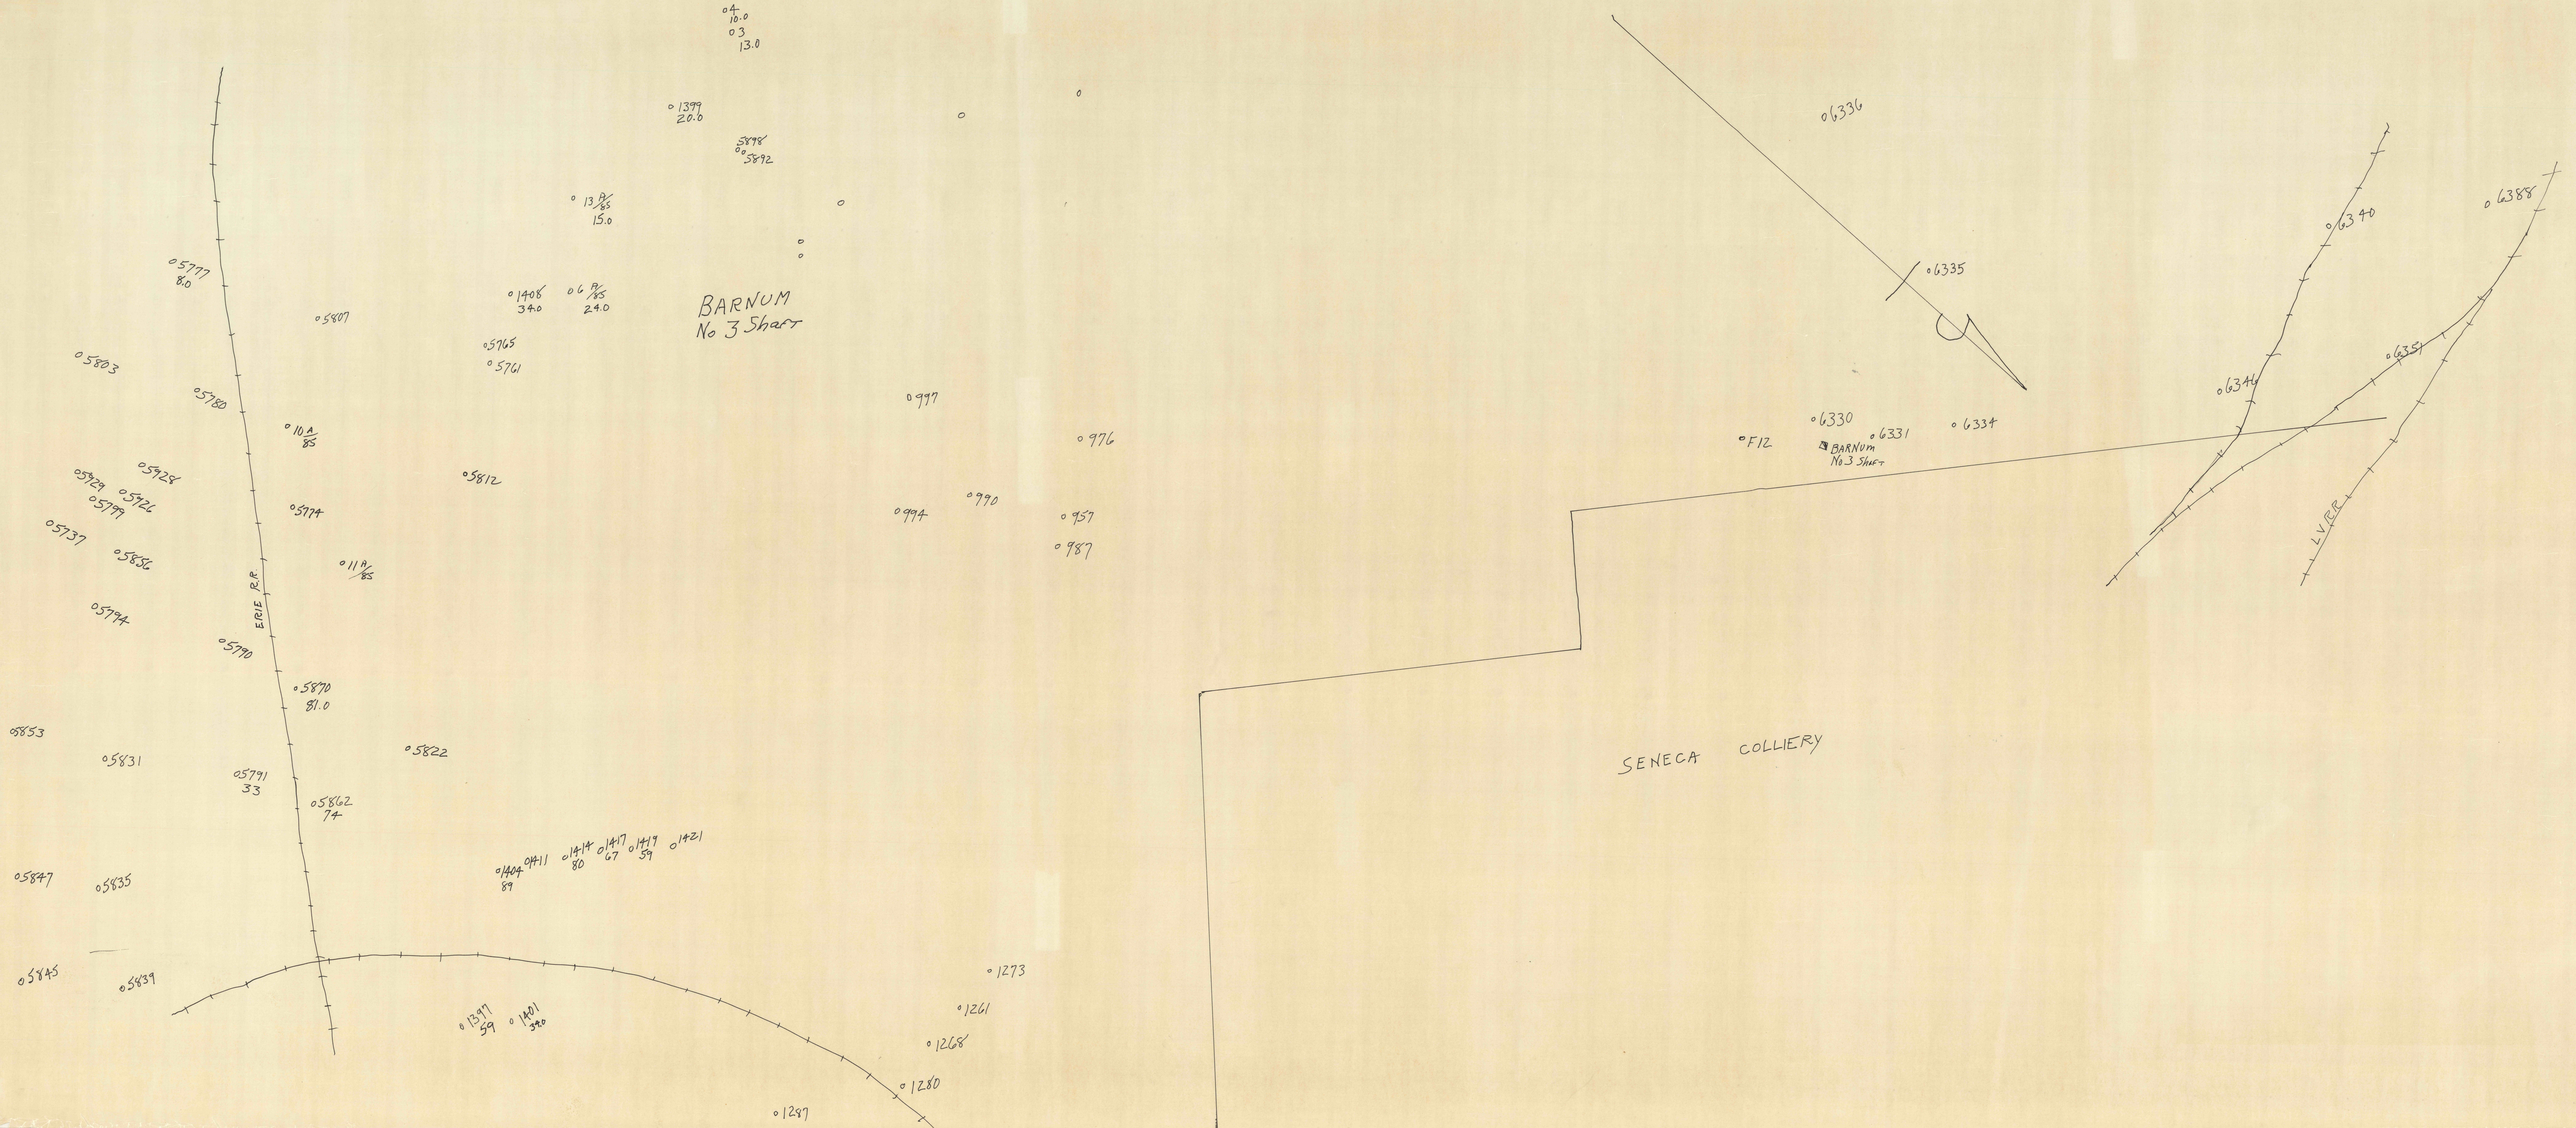
BARNUM
No 3 Shaft
SENECA COLLIERY
E.R.R.P.R.
L.V.R.R.
BARNUM
No 3 Shaft
4
10.0
3
13.0
1399
20.0
5898
5892
13 P/85
15.0
5777
8.0
1408
34.0
6 P/85
24.0
5807
5765
5761
5803
5780
10 A
85
997
976
5812
5928
5929
5926
5799
5774
994
990
957
987
5737
5856
11 A/85
5794
5790
5870
81.0
5853
5822
5831
5791
33
5862
74
1404
89
1411
1414
80
1417
67
1419
59
1421
5847
5835
5845
5839
1397
59
1401
39.0
1273
1261
1268
1280
1287
6336
6335
6340
6388
6349
6351
6330
6331
6334
F12