


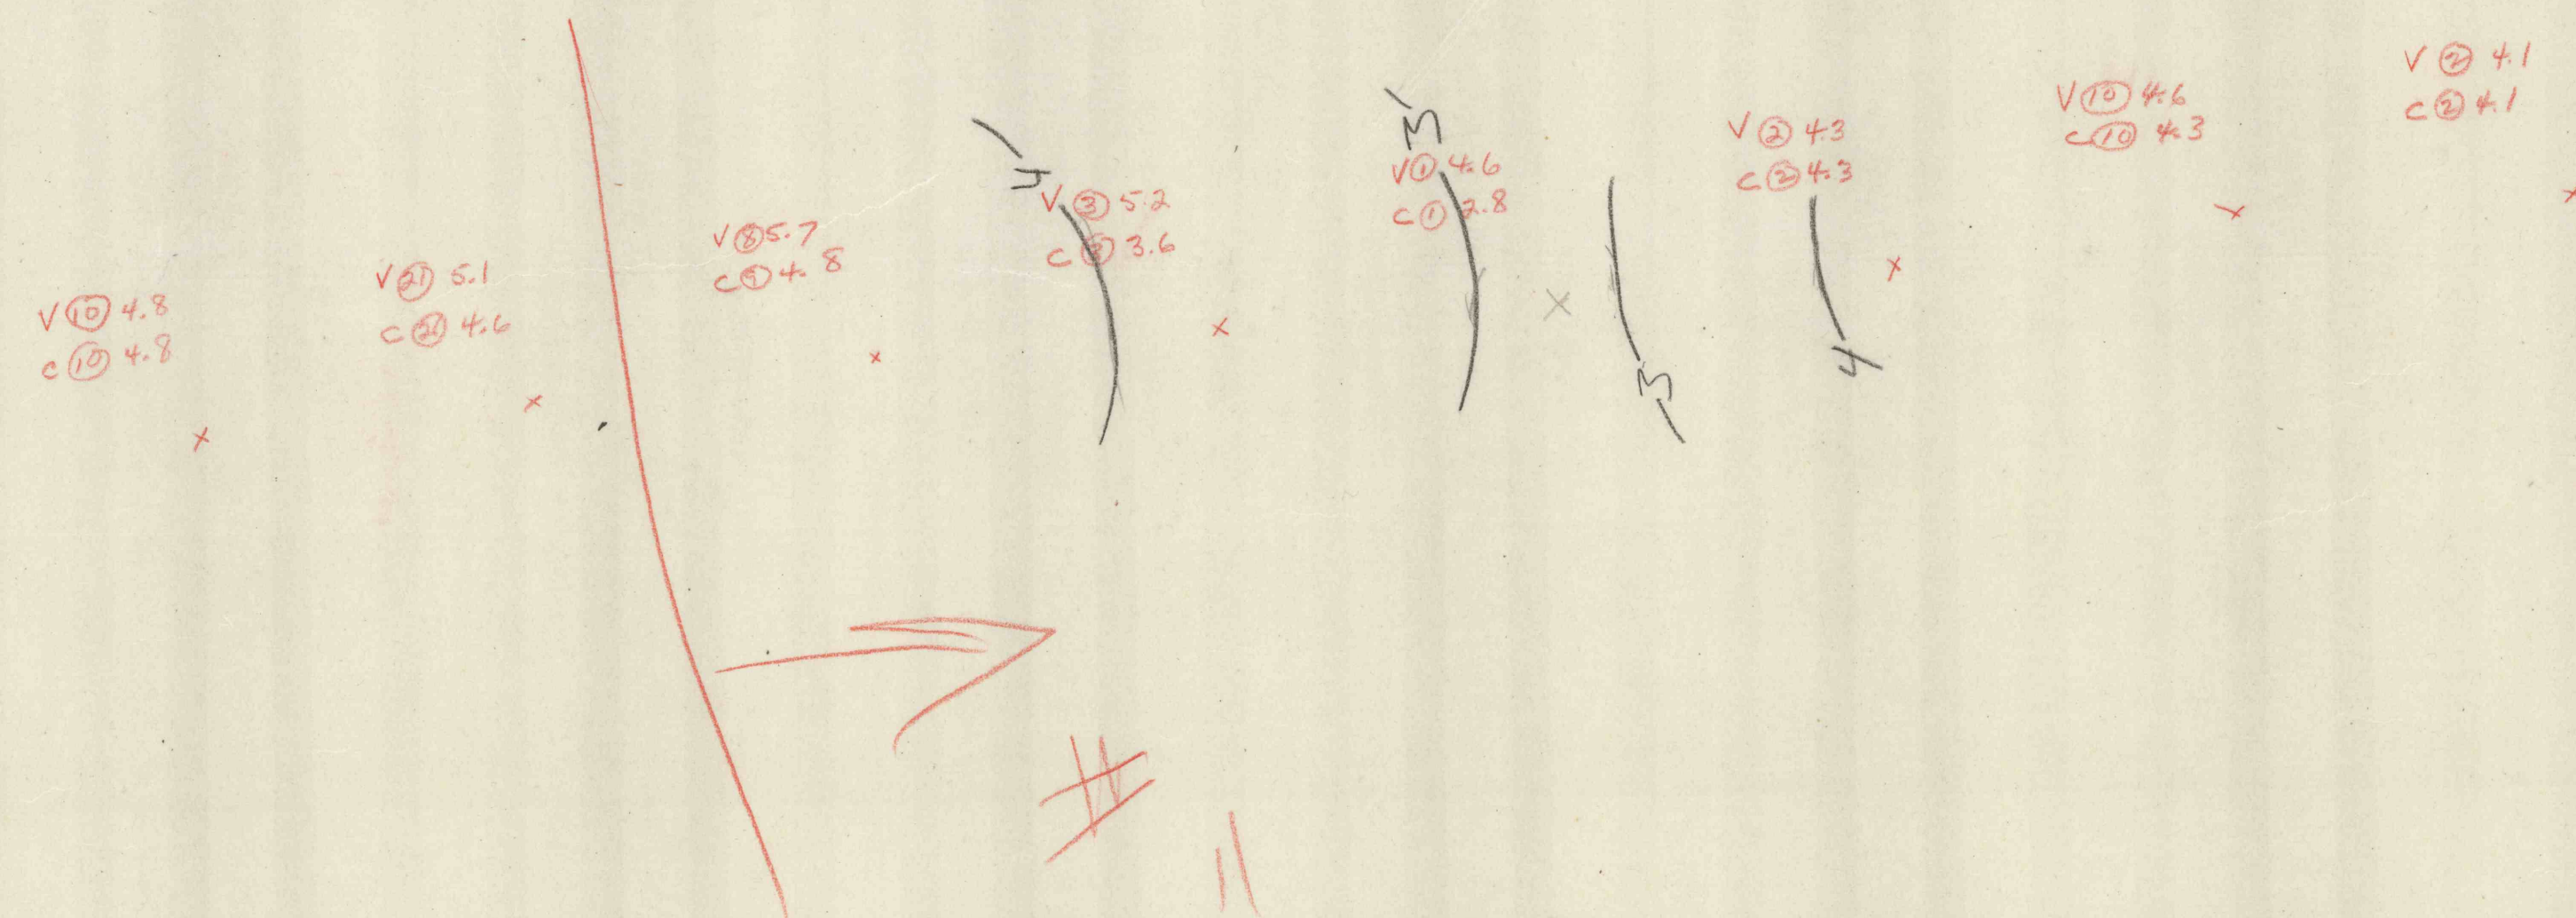

76° 22' 30"

HOLMES TOP SPHT = U.S.G.S. #10T

CENTRALIA Holmes Top = 10T

VN. RANGE	COAL RANGE	No Obs.	No Areas
3.0' - 7.8'	2.8' - 5.3'	57	10
Av. VN.	Av. COAL		
7.4'	4.5'		

76° 18' 45"