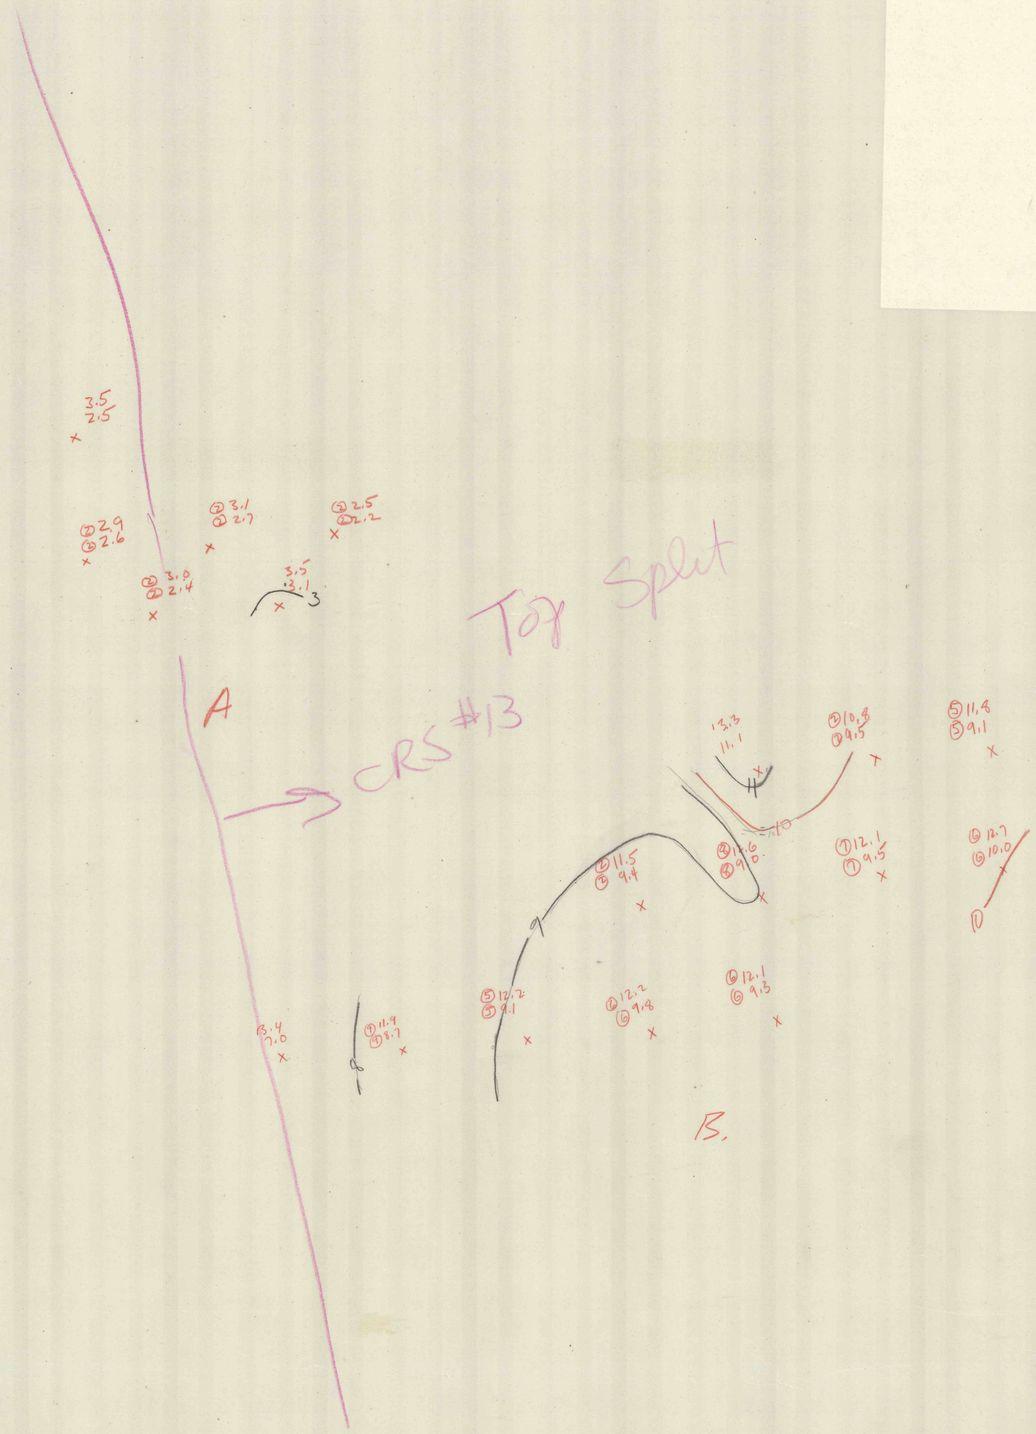

A Raven Run	9	Mammoth Top	V 2.0 – 3.6	C 1.4 – 3.1
B Hammond	9	Mammoth Top	V 7.6 – 14.6	C 5.0 – 12.7

Supplement to Map 203