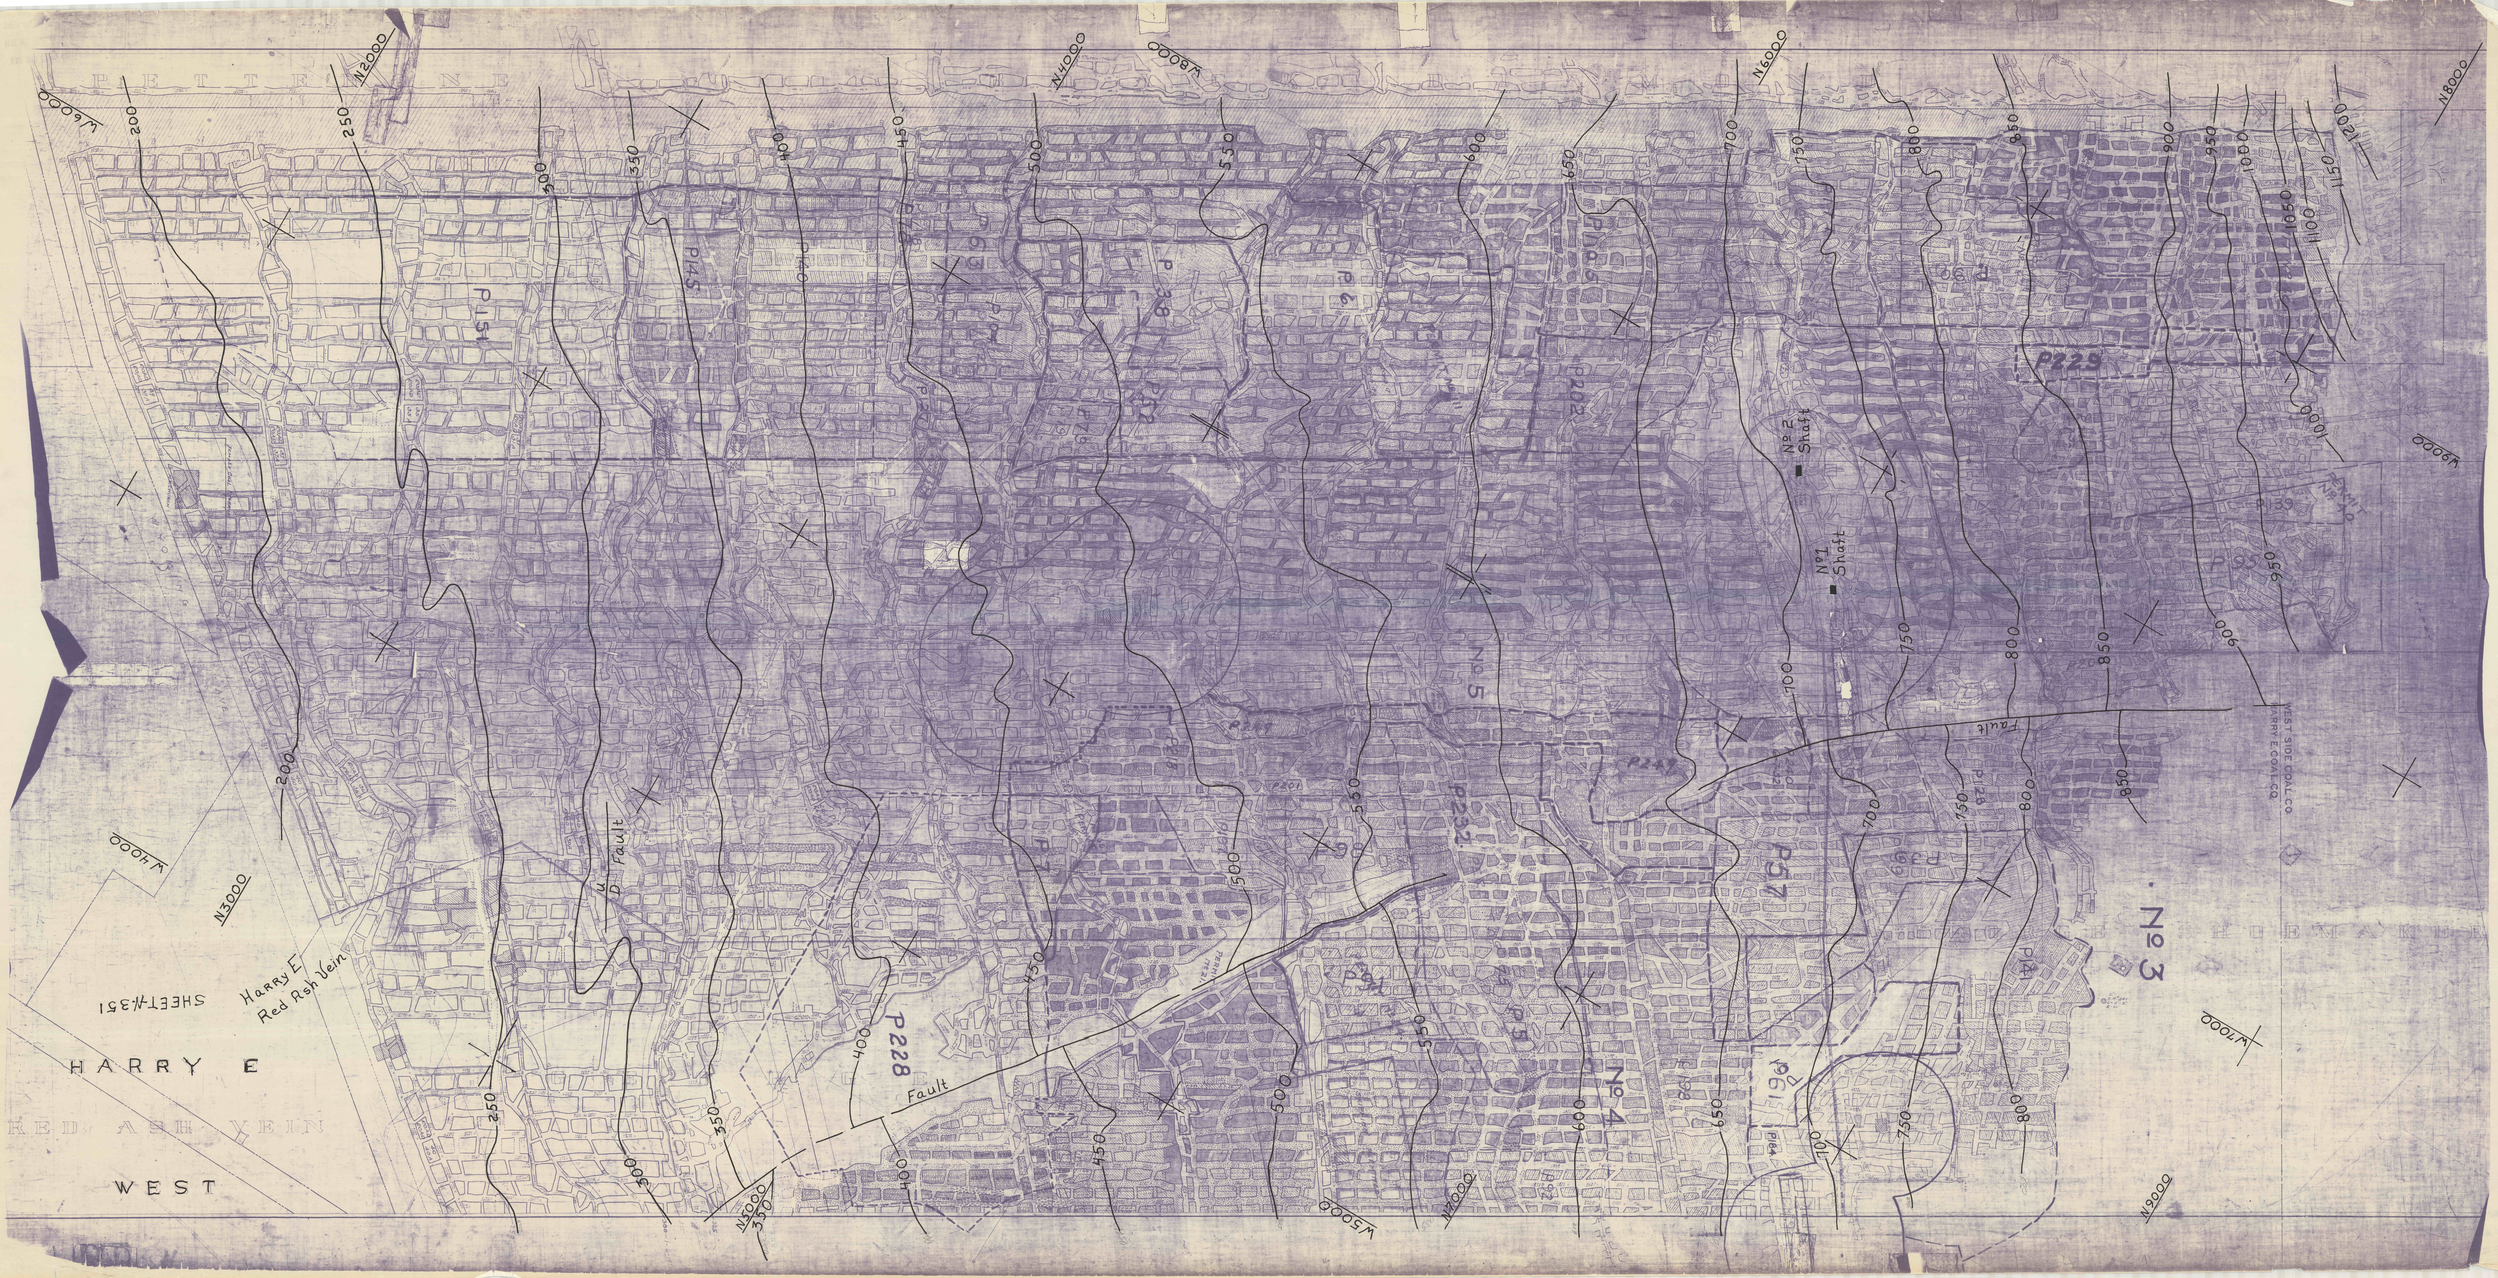

HARRY E
RED ASH VEIN
WEST
SHEET-N-351
Harry E
Red Ash Vein
No 1 Shaft
No 2 Shaft
No 3
No 4
No 5
Fault
D Fault
P151
P145
P228
P232
P57
P229
P202
P249
P39
P128
N2000
N3000
N4000
N5000
N6000
N7000
N8000
N9000
W4000
W5000
W6000
W7000
W8000
W9000
200
250
300
350
400
450
500
550
600
650
700
750
800
850
900
950
1000
1050
1100
1150
1200