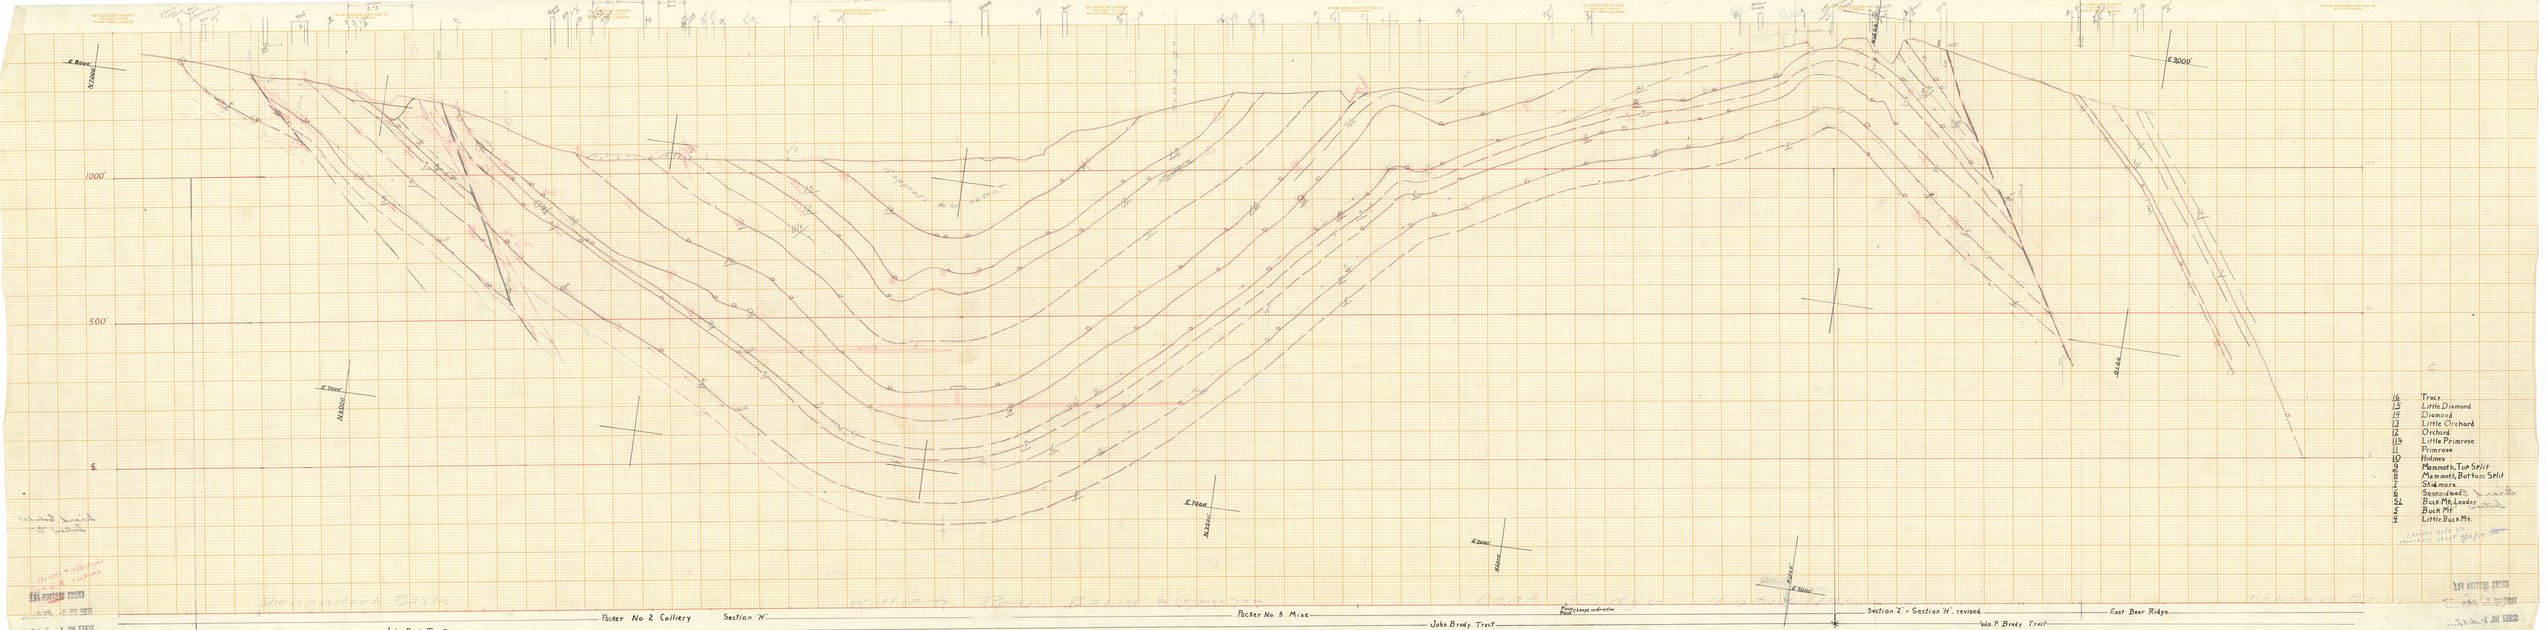

E 8000'
N 7000'
Edward Lynch Tract
Tract line
Packer No. 2 Coll
Road
Breast 5
Stripped 8 + 9
Rock Bank
Silt Bank
Creek
RR
Road
Breast
West Mahanoy Twp
Stripped
Old Ewing Grading
N 11000'
E 9000'
1000'
500'
$
15 appears to be absent
E 7000'
N 6000'
E 7000'
N 3000'
E 7000'
N 2000'
E 7000'
N 4000'
0100
Shenandoah Basin
William Penn Basin = Germantown
Bear Ridge Anticline
Mahanoy Basin
Packer No. 2 Colliery
Section "H"
Packer No. 5 Mine
Pivot Point change in direction
Section "2" = Section "H", revised
East Bear Ridge
Edward Lynch Tract
John Brady Tract
John Brady Tract
Wm. P. Brady Tract
16
15
14
13
12
11¼
11
10
9½
9
8
7
6
5L
5
4
C

16	Tracy
15	Little Diamond
14	Diamond
13	Little Orchard
12	Orchard
11¼	Little Primrose
11	Primrose
10	Holmes
9	Mammoth, Top Split
8	Mammoth, Bottom Split
7	Skidmore
6	Seven-foot
5L	Buck Mt. Leader
5	Buck Mt.
4	Little Buck Mt.

changes made on structure sheet 9/12/50 DH

Changes + additions from E.E sections