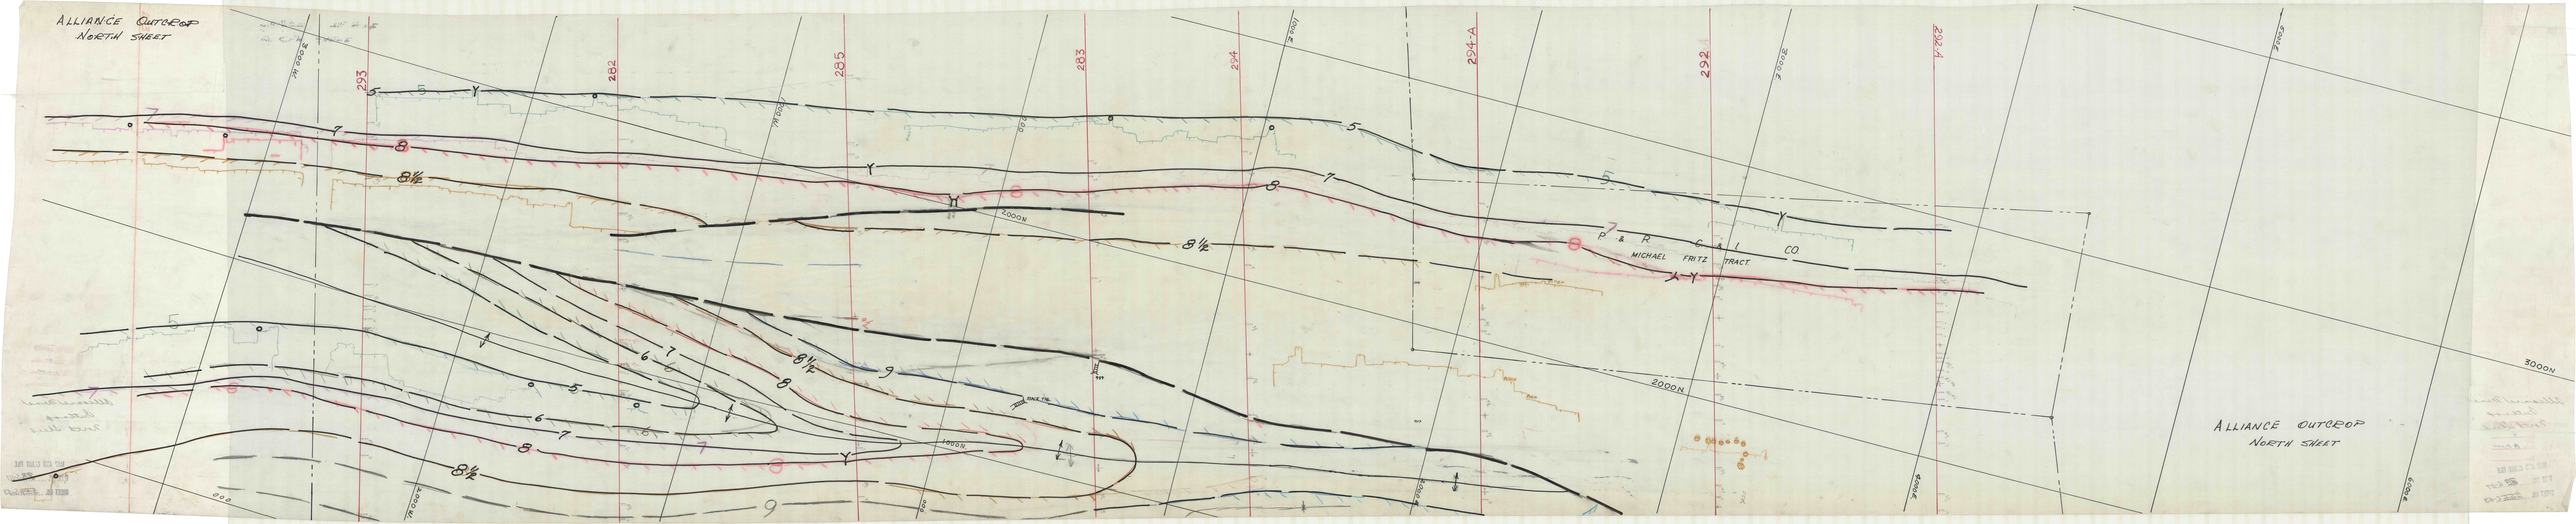
ALLIANCE OUTCROP
NORTH SHEET
233
282
285
283
294
294-A
292
P & R G & I CO
MICHAEL FRITZ TRACT
2000N
3000N
ALLIANCE OUTCROP
NORTH SHEET