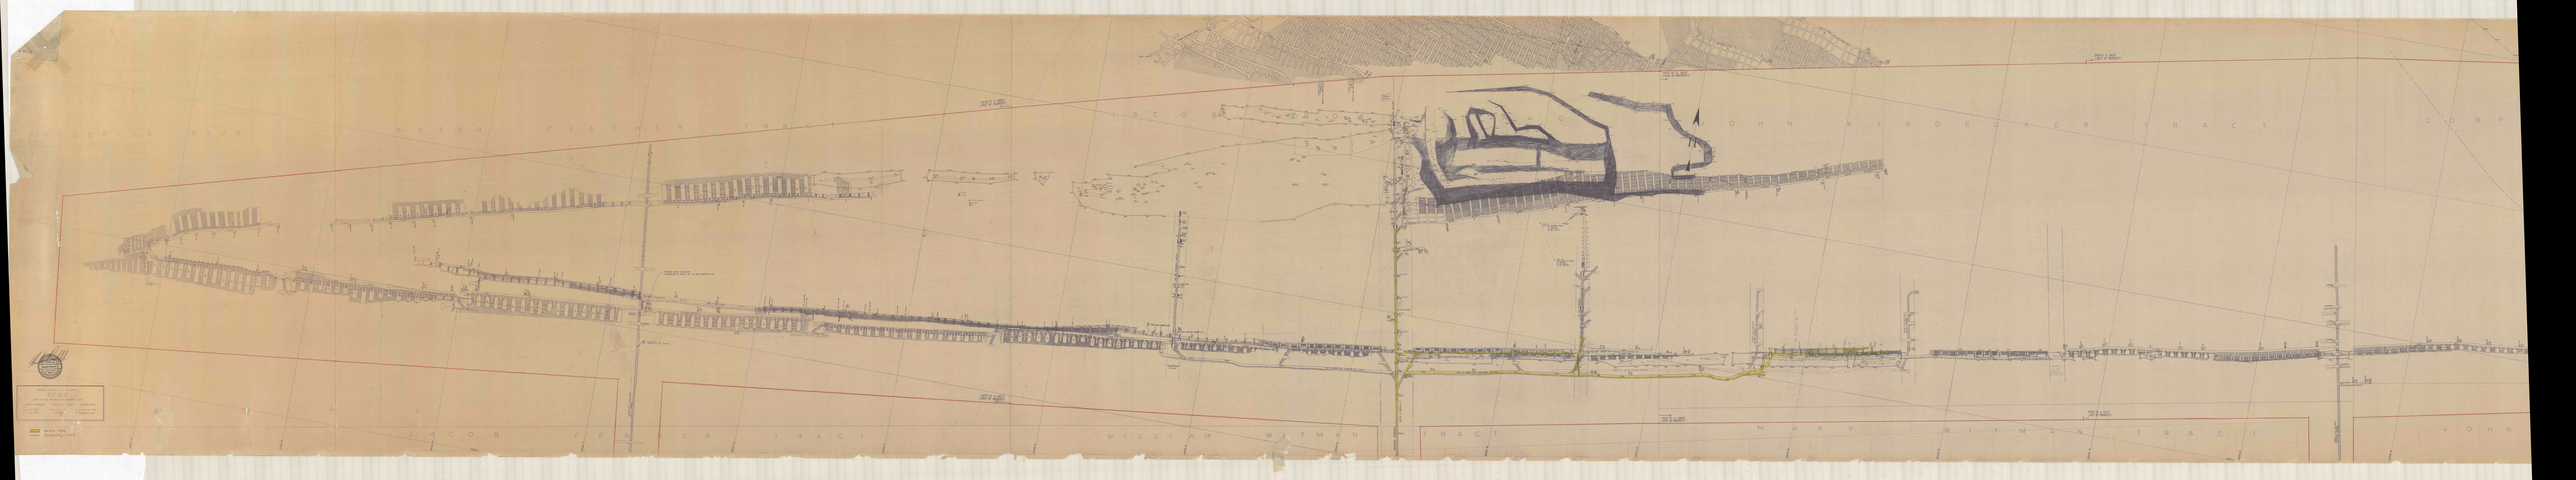
FREDERICK RAUB
PETER FEATHER TRACT
JACOB
JOHN ASTROE
WILLIAM WITMAN
MARY WITMAN TRACT
JOHN