


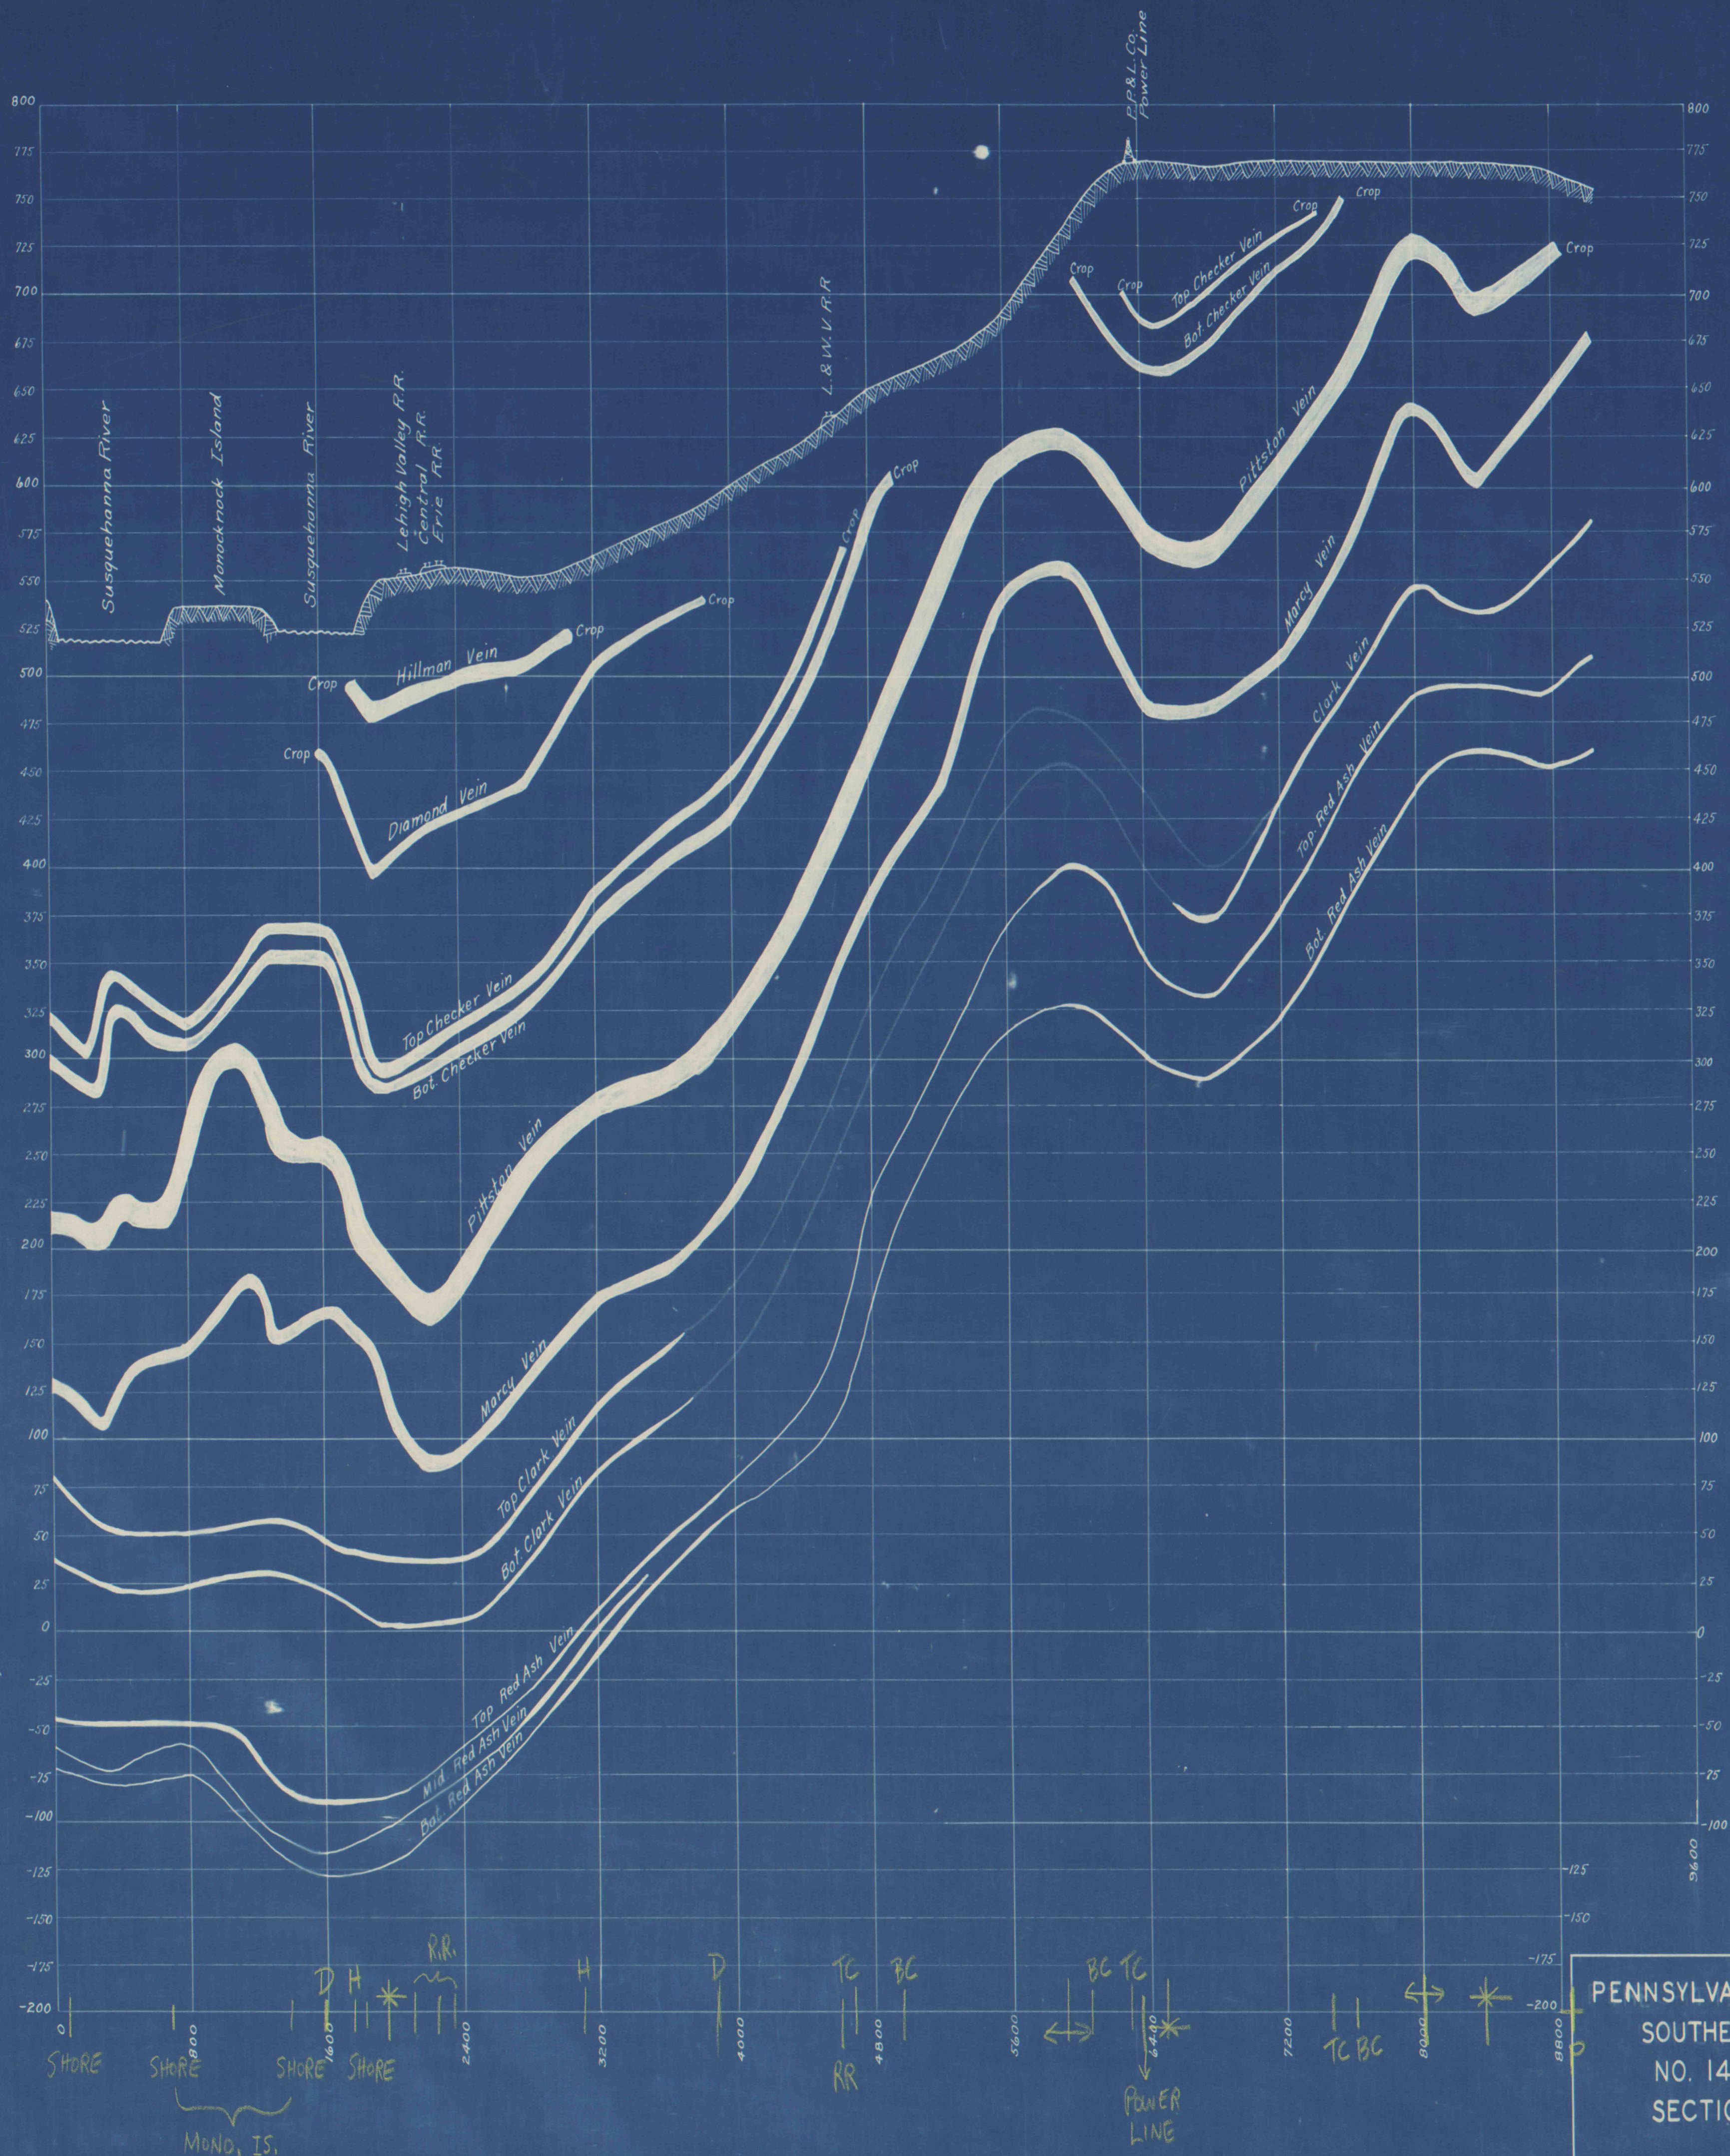

PENNSYLVANIA COAL CO.
SOUTHERN DIVISION
NO. 14 COLLIERY
SECTION C-D

SCALE { HOR. 1" = 400'
VER. 1" = 50'

Office of
Mining Engineer
