




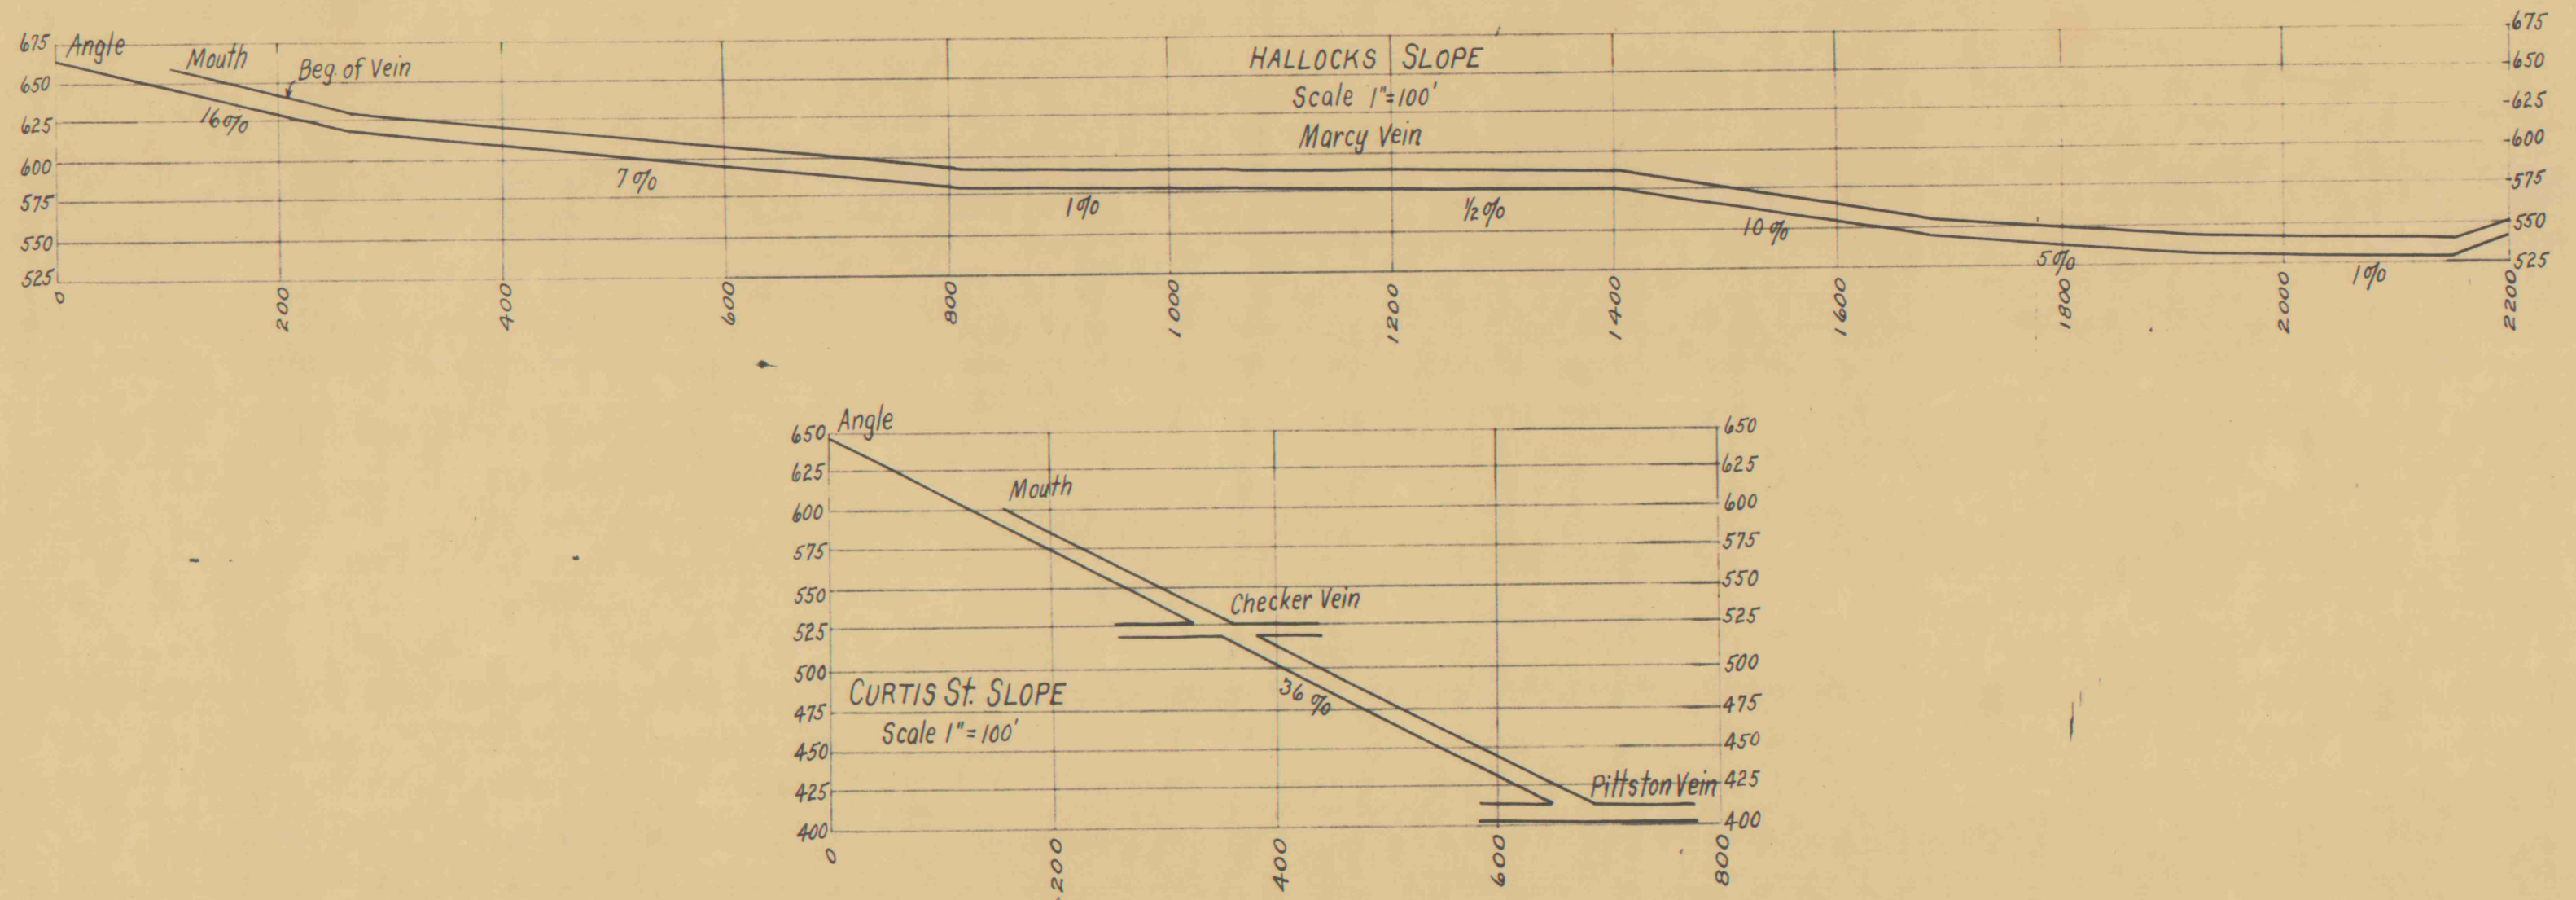


BARNUM NO. 2 SHAFT

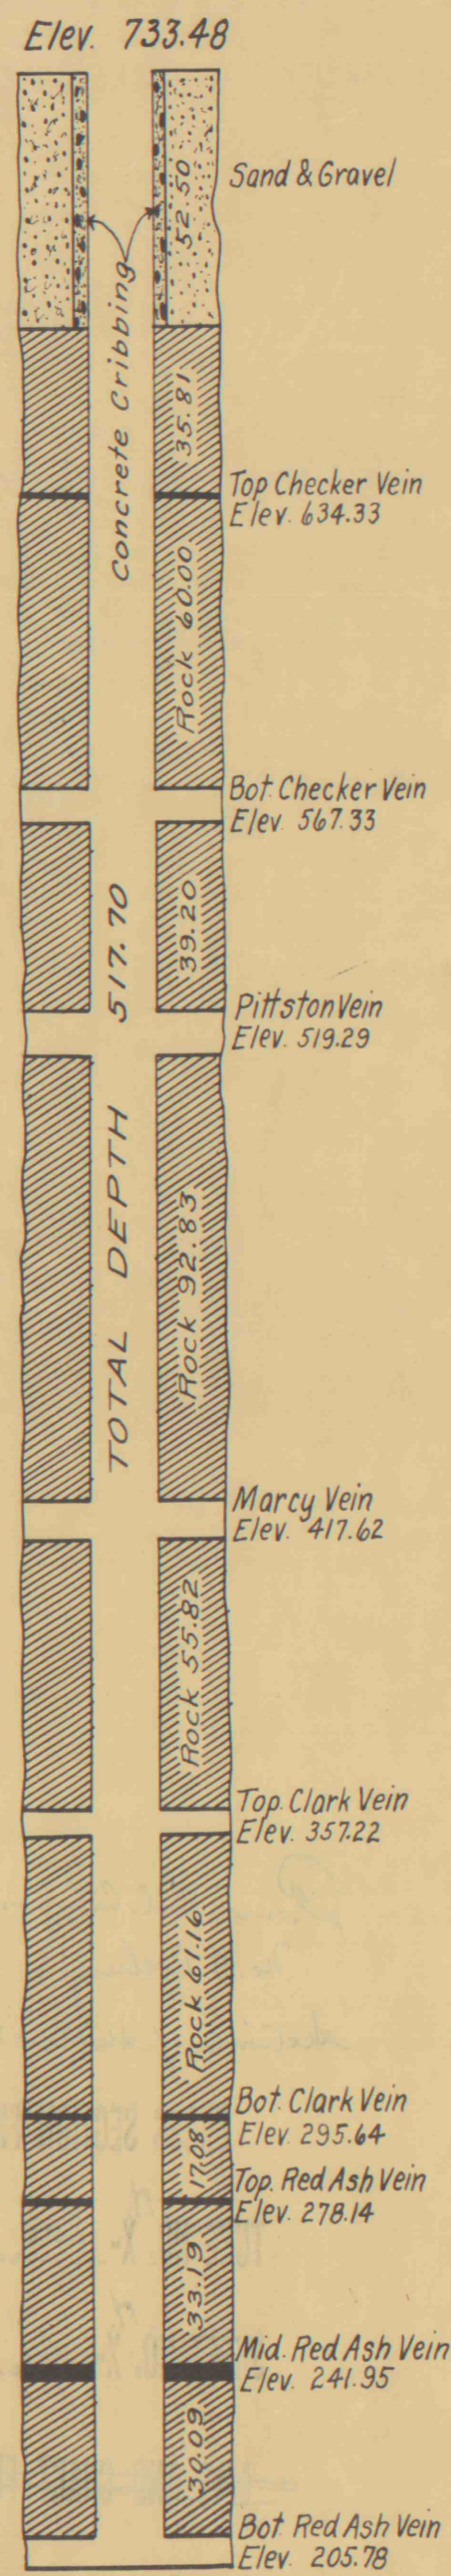


BARNUM NO. 1 SHAFT

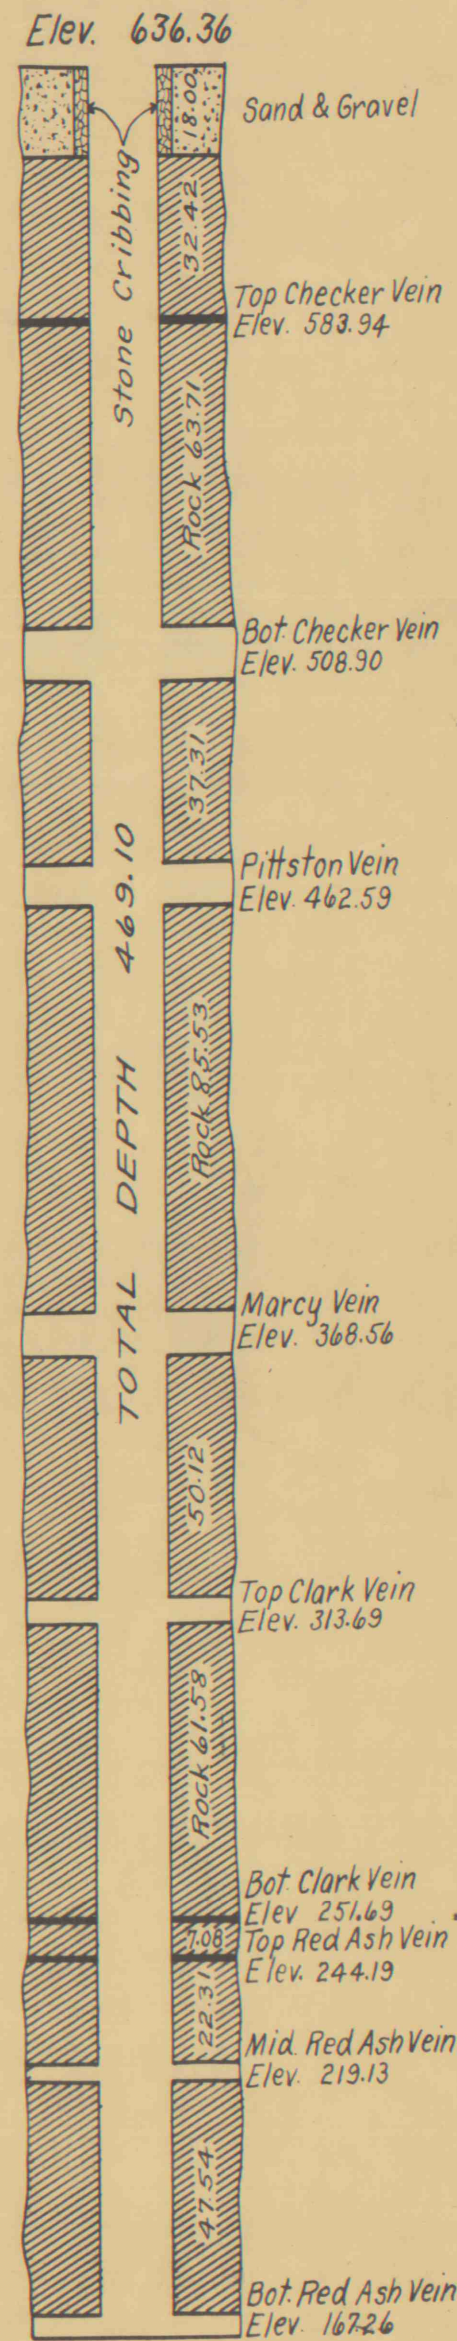


NO. 9 SHAFT

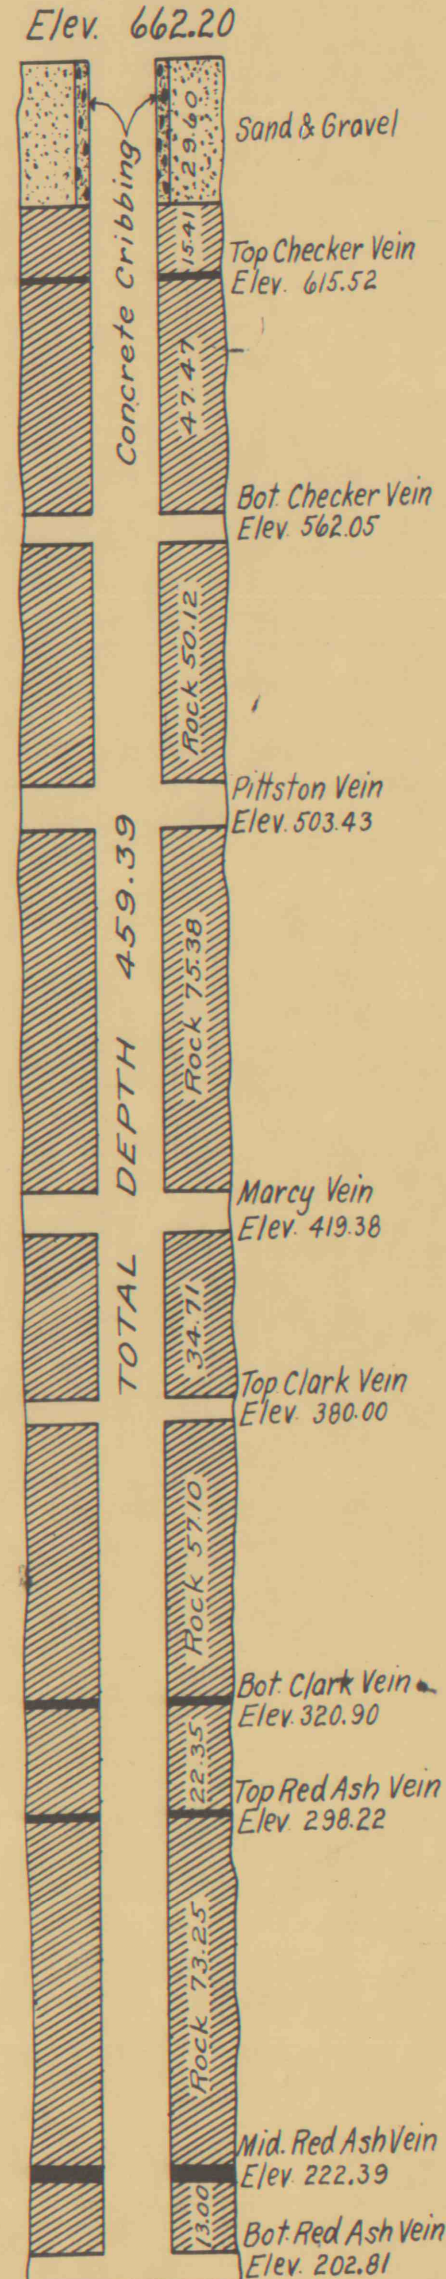


LEADVILLE SHAFT

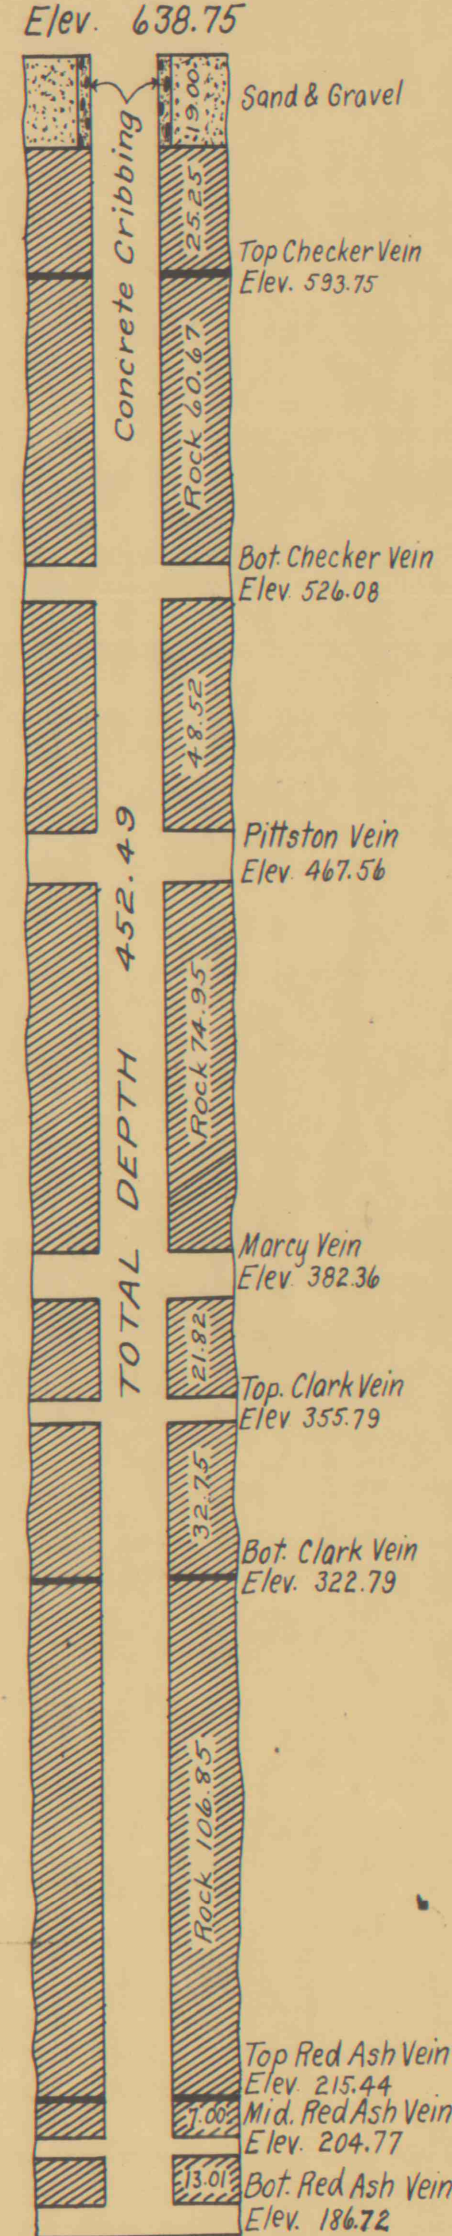


NO. 1 SHAFT

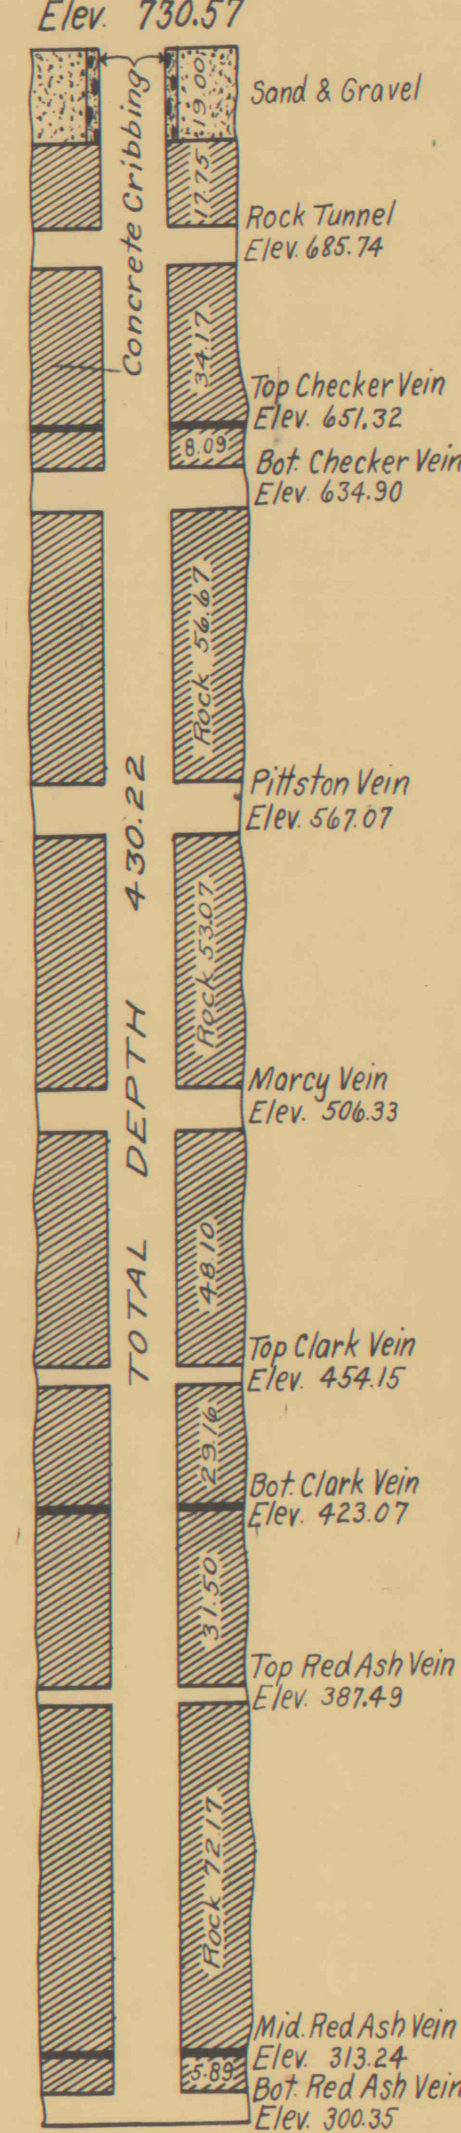


NO. 3 SHAFT

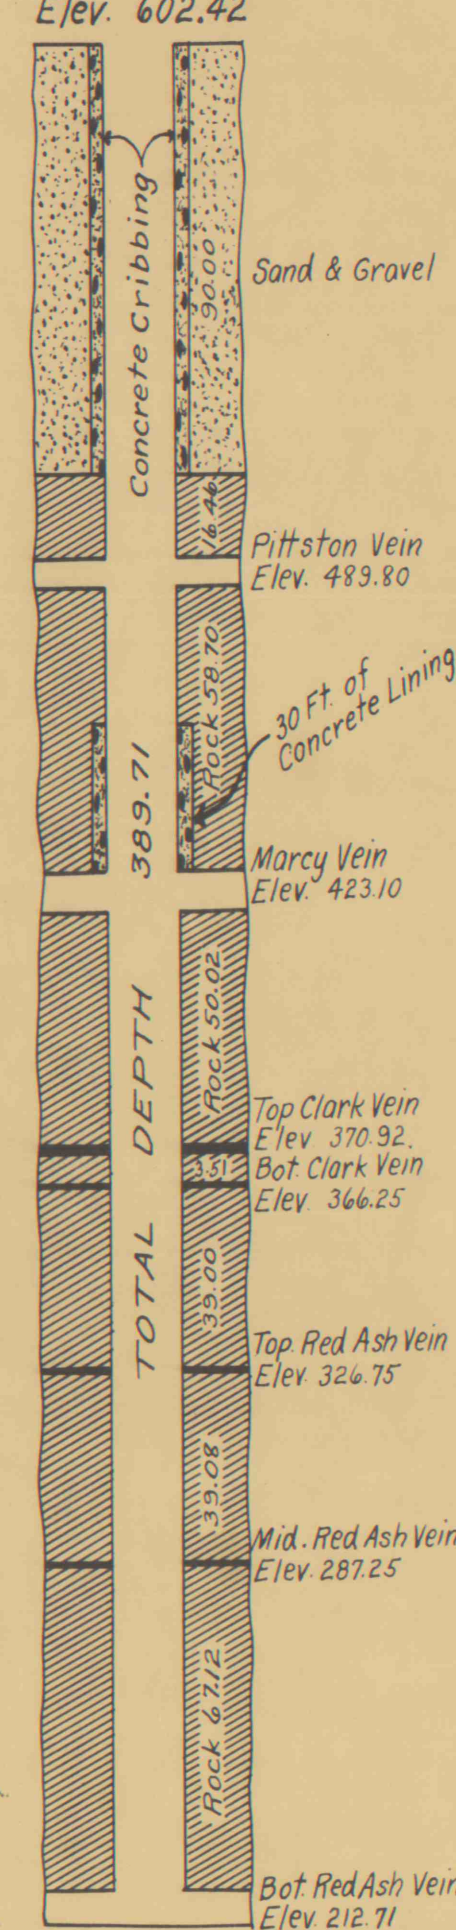

NO. 8 SHAFT

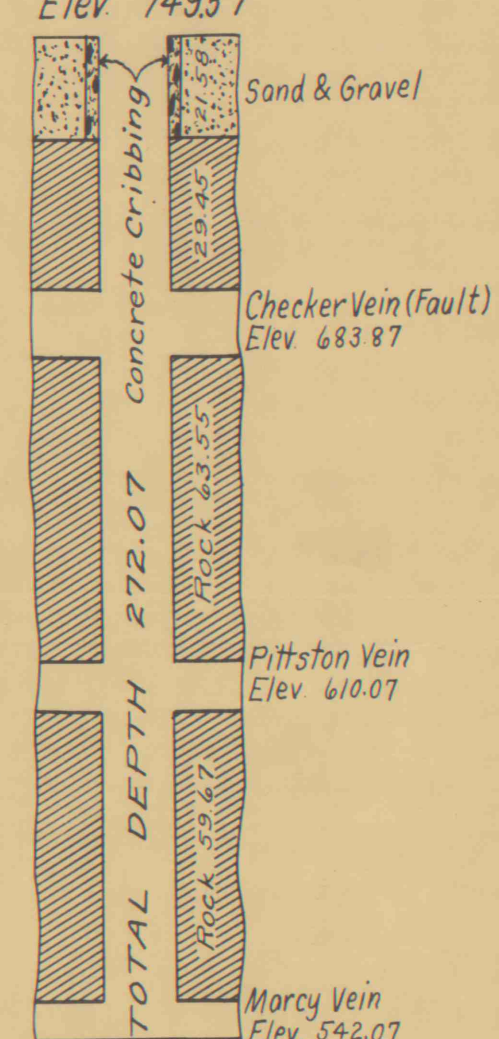

NO. 10 SHAFT

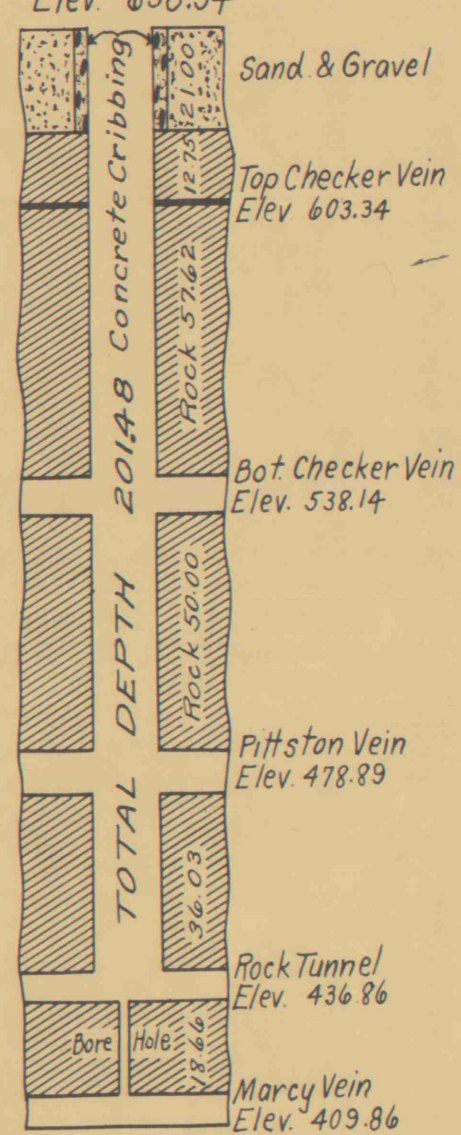

THE PITTSSTON COMPANY
SOUTHERN DIVISION
NO. 9 COLLIERY
SECTIONS OF
SHAFTS & SLOPES