


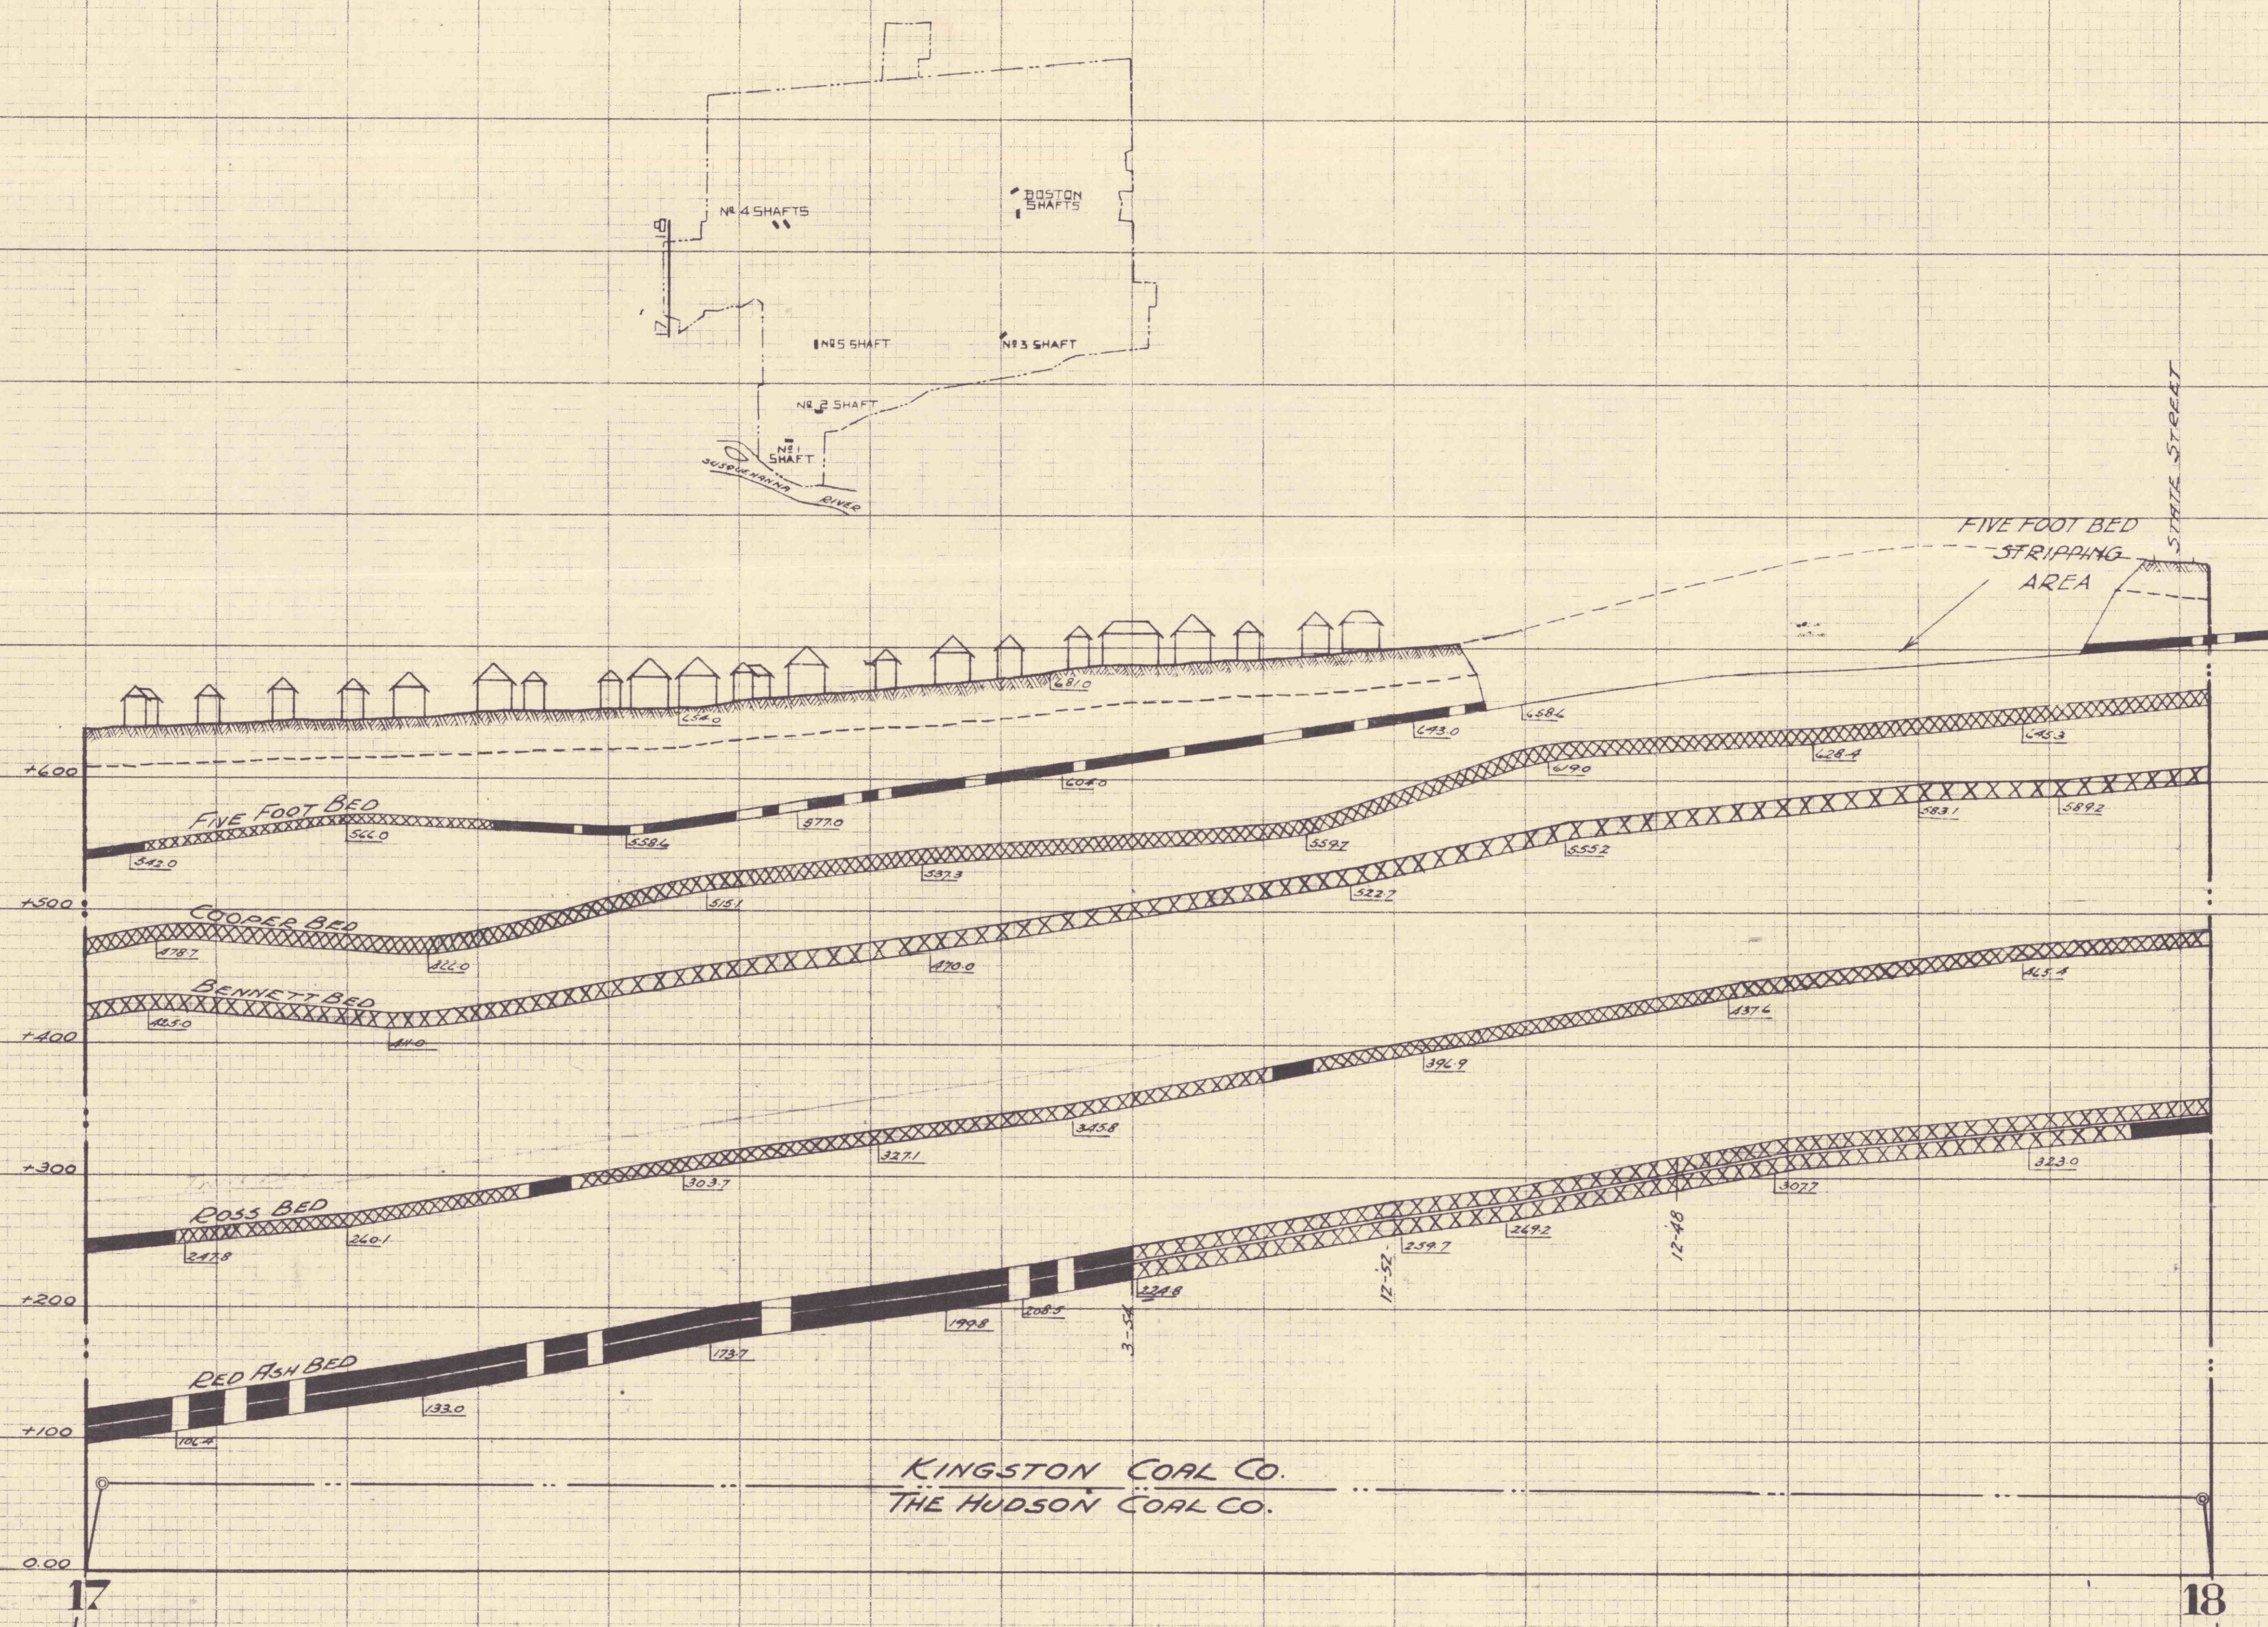

THE HUDSON COAL CO.
LOREE COLLIERY
CROSS SECTION
THRU COAL MEASURES
SCALE 1" = 100'

MINING ENGINEER'S OFFICE APRIL 1929

POSTED	
7-25-25	K.M.
3-1-27	K.M.
2-23-30	K.M.
2-27-33	K.M.
5-17-34	K.M.

81-71 NOIT322 2202D

LOREE COLLIERY