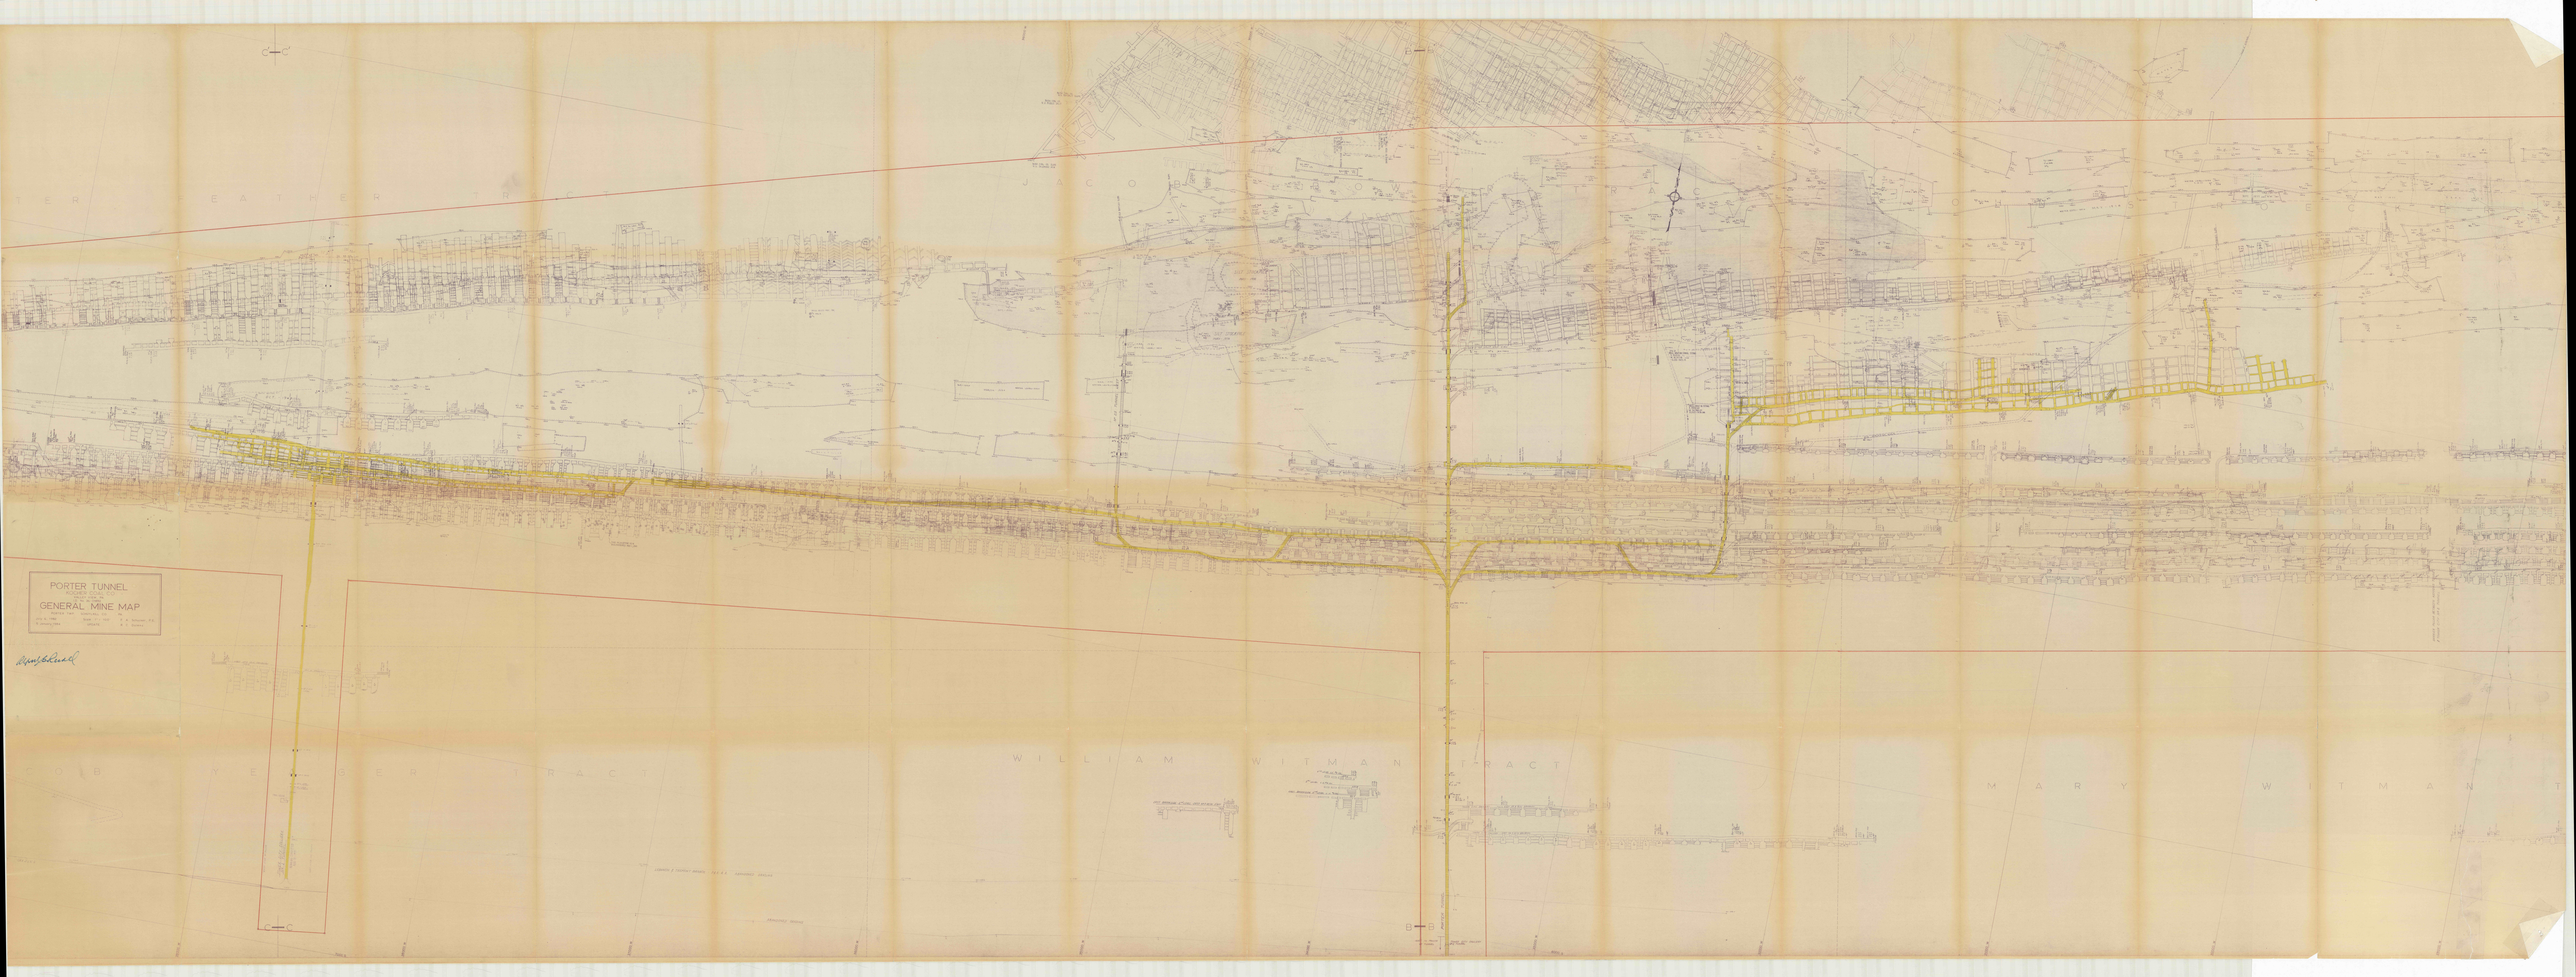

PORTER TUNNEL
GENERAL MINE MAP
WATER TRACT
JACOBS TRACT
OBYRNE TRACT
WILLIAM WITMAN TRACT
MARY WITMAN