


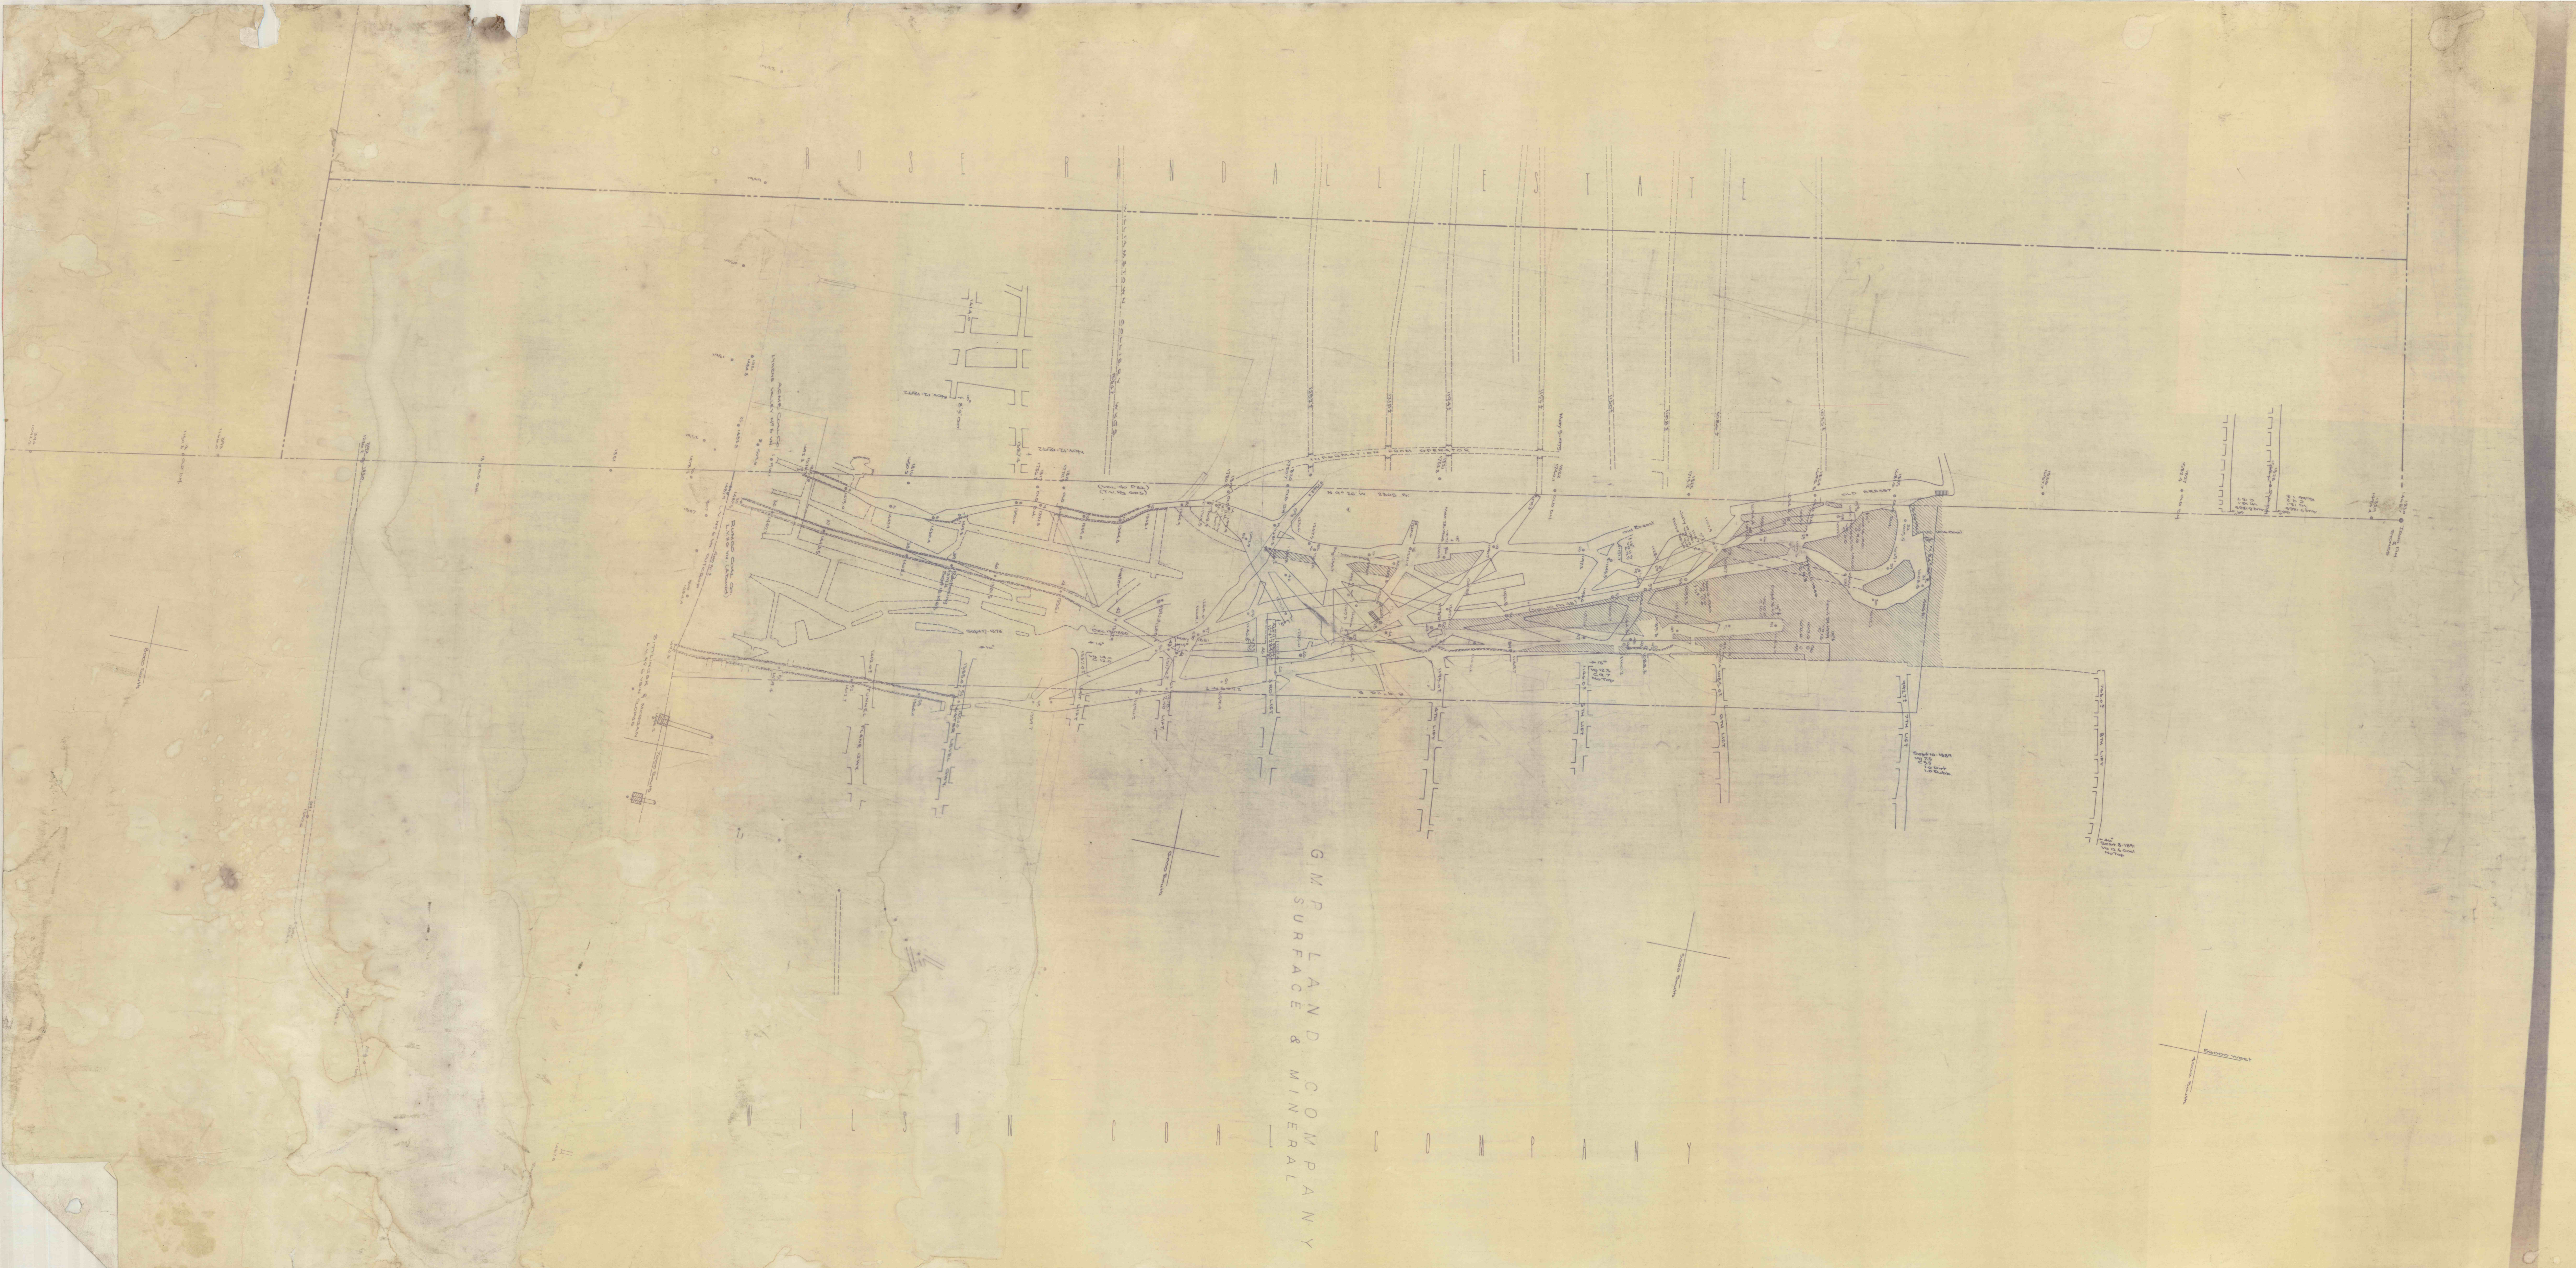

GMP LAND COMPANY
SURFACE & MINERAL

